
ROBERS & FISCHER INC

~~HOGANSON & ROBERS, INC.~~

CONSULTING ENGINEERS & LAND SURVEYORS

PHONE (414) 763-2652 116 E. CHESTNUT ST. BURLINGTON, WIS. 53105

LOT 18, BLOCK "E", COUNTRY CLUB ESTATES SUB. UNIT 3, VILLAGE OF FONTANA, WALWORTH COUNTY, WISCONSIN.

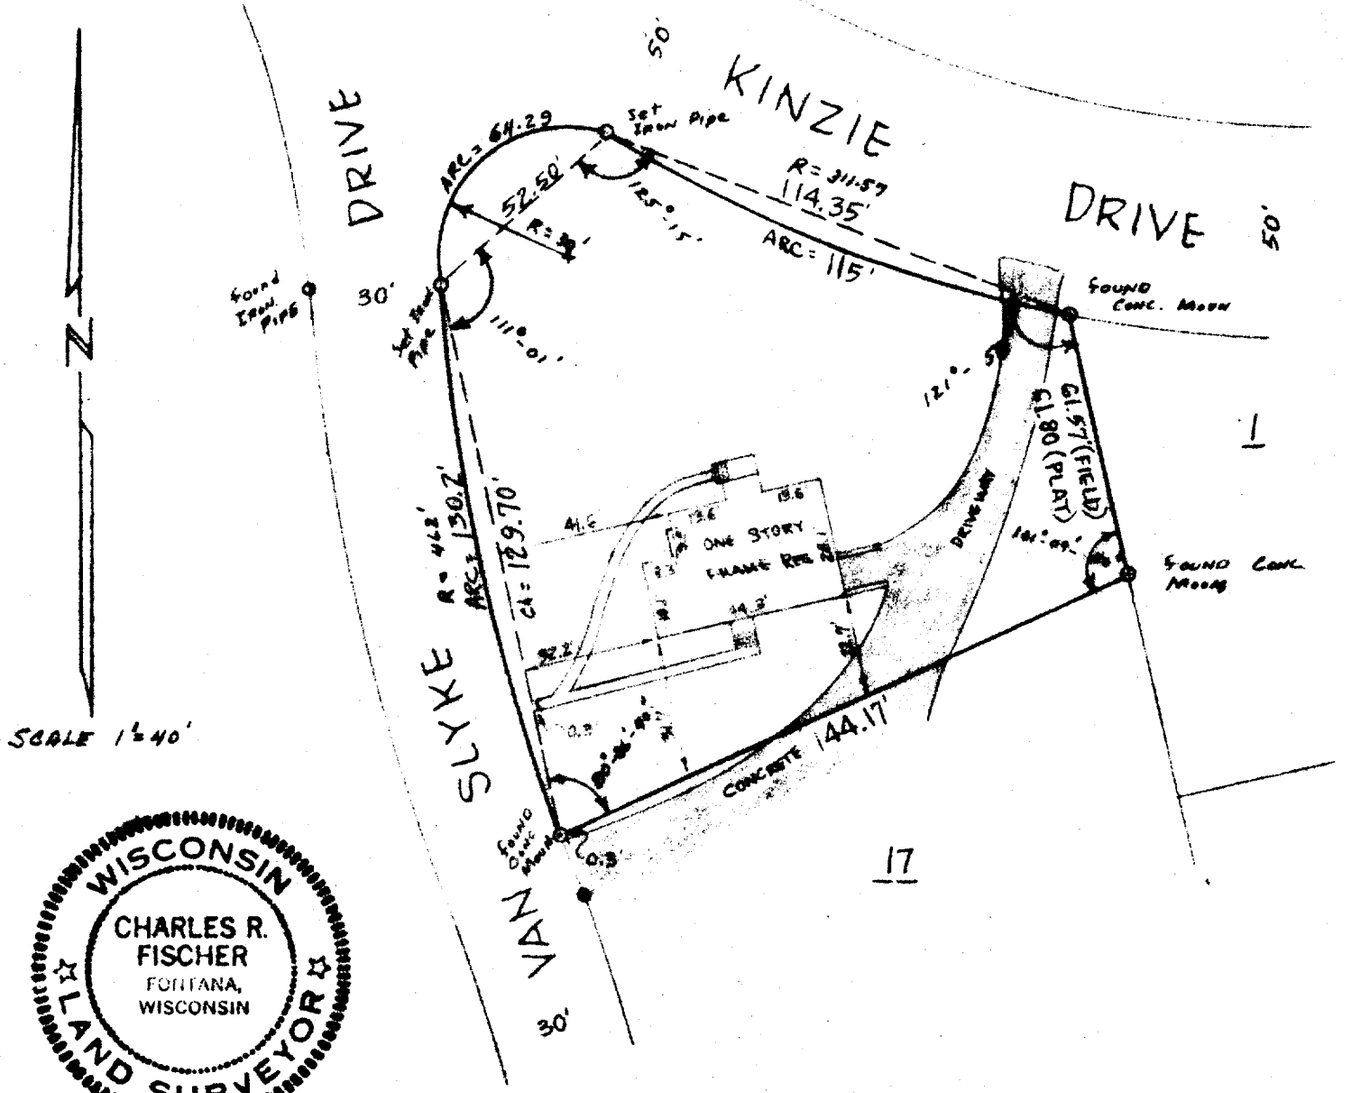

WISCONSIN
CHARLES R. FISCHER
FONTANA, WISCONSIN
LAND SURVEYOR

I HEREBY CERTIFY THAT WE HAVE SURVEYED THE LANDS DESCRIBED ABOVE ACCORDING TO OFFICIAL RECORDS AND THAT THE PLAT DRAWN HEREON IS A CORRECT REPRESENTATION OF SAID SURVEY.

Charles R. Fischer
WIS. REG. LAND SURVEYOR

DATE July 13, 1970 5-151A JOB NO. 70093

SC03-95