
ROWERS & FISCHER, INC.

[redacted]

CONSULTING ENGINEERS & LAND SURVEYORS

PHONE (414) 763-2652 116 E. CHESTNUT ST. BURLINGTON, WIS. 53105

Plat of Survey
of
4 and 5, Block 10, Glenwood Springs Subdivision, Village of Fontana-on-Geneva Lake, Walworth County, Wisconsin.

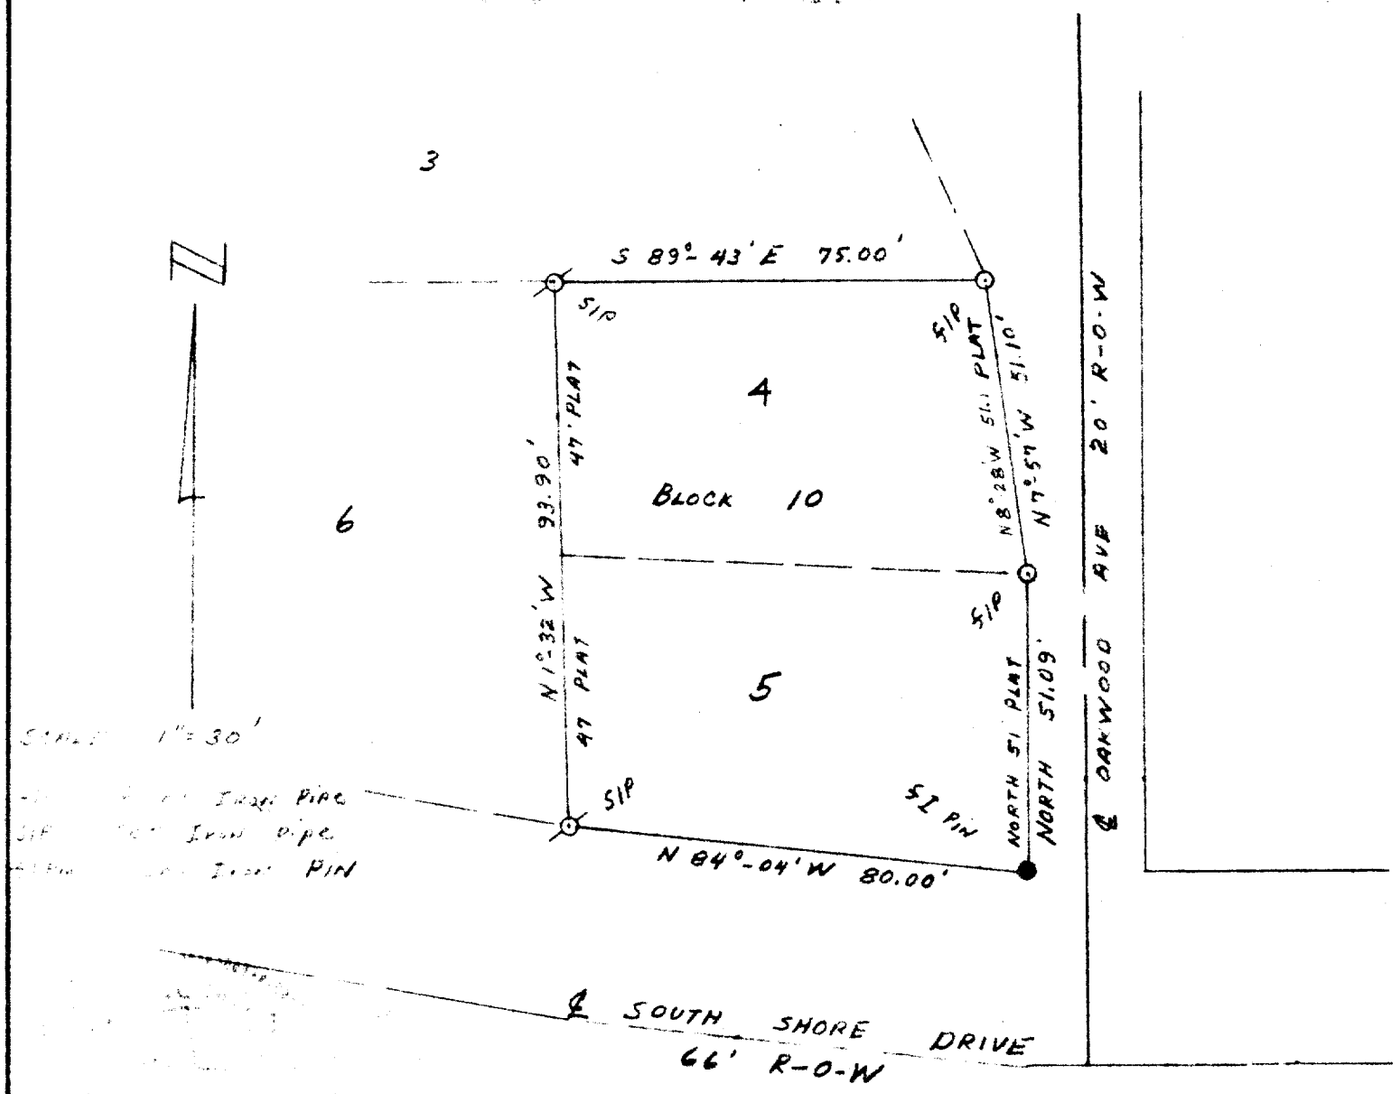

I HEREBY CERTIFY THAT WE HAVE SURVEYED THE LANDS DESCRIBED ABOVE ACCORDING TO OFFICIAL RECORDS AND THAT THE PLAT DRAWN HEREON IS A CORRECT REPRESENTATION OF SAID SURVEY.

WIS. REG. LAND SURVEYOR

DATE June 16, 1970 5-153A JOB NO. 70039

S65 57, 58