
HAROLD H. ROLB

REGISTERED PROFESSIONAL LAND SURVEYOR
LAKE GENEVA, WISCONSIN

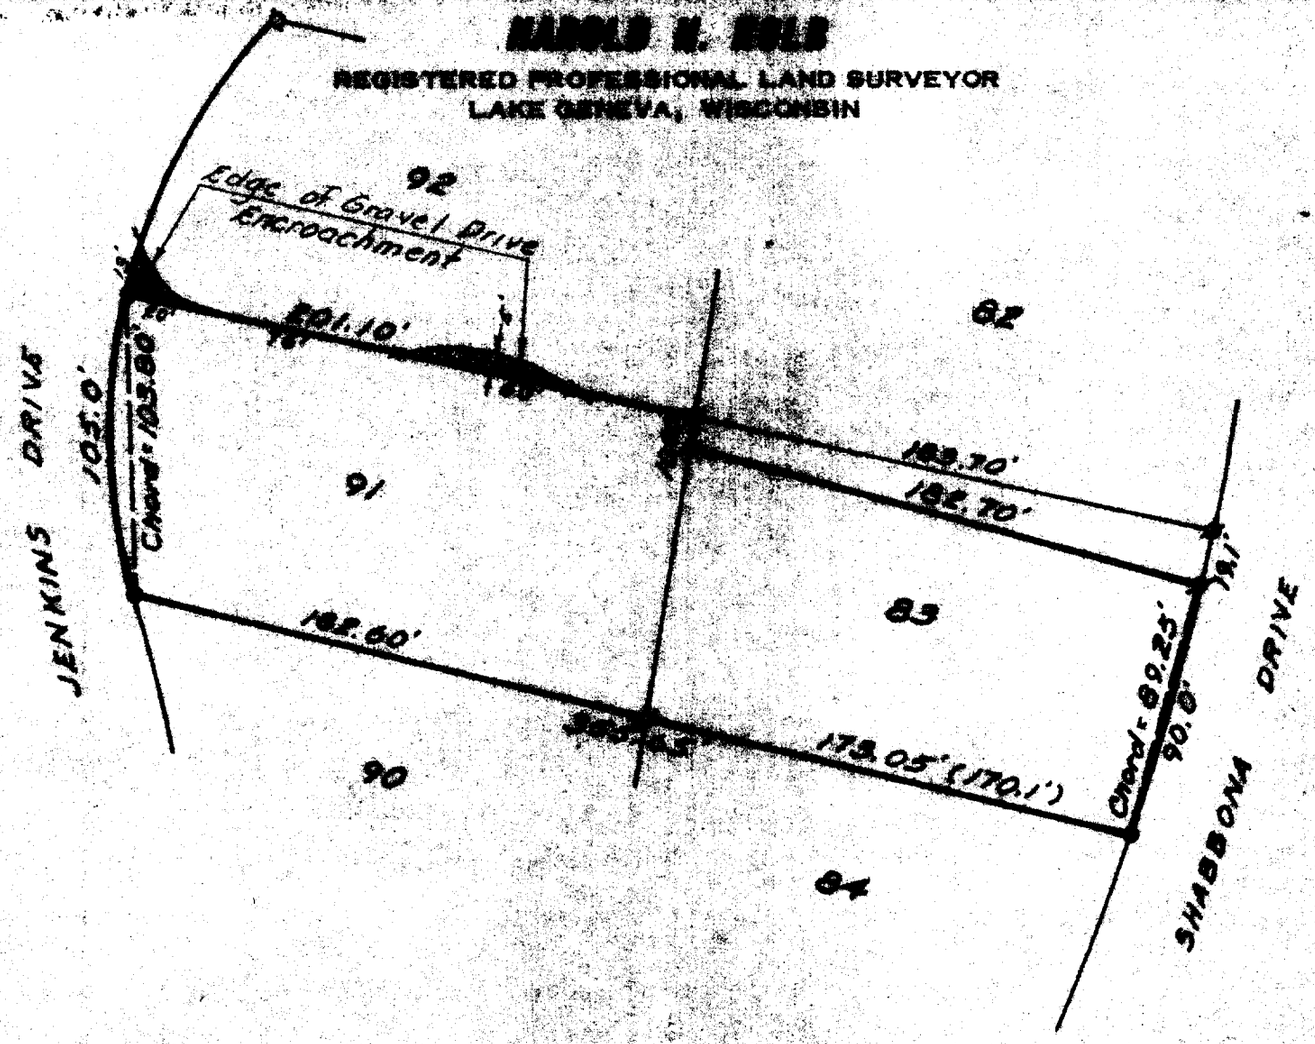

PLAT OF SURVEY OF

Lot 91 and part of Lot 83, Unit 2, Country Club Estates, Village of Fontana-on-Geneva Lake, Walworth County, Wisconsin.

N

SCALE: 1"= 60'

LEGEND

- IRON PIPE FOUND
- Conc. Monument found
● - CONCRETE MONUMENT set
x - SPIKE
( )- Recorded distance

WISCONSIN HAROLD H. ROLB S-187 LAKE GENEVA, WIS. LAND SURVEYOR

I, HAROLD H. ROLB, DO HEREBY CERTIFY THAT I HAVE SURVEYED THE PROPERTY HEREON DESCRIBED ACCORDING TO THE RECORDS THEREOF, AND THAT THE PLAT HEREON IS A CORRECT REPRESENTATION OF THE LOT LINES.

[redacted] REGISTERED LAND SURVEYOR, S-187

DATE [redacted]

5-16-84

OCO2-78 4-86

Fon 39