


PLAT OF SURVEY

LOTS 89-90-91-PT. 92 & 93 - BUENA VISTA
VILLAGE OF FONTANA, WALWORTH COUNTY
WISCONSIN

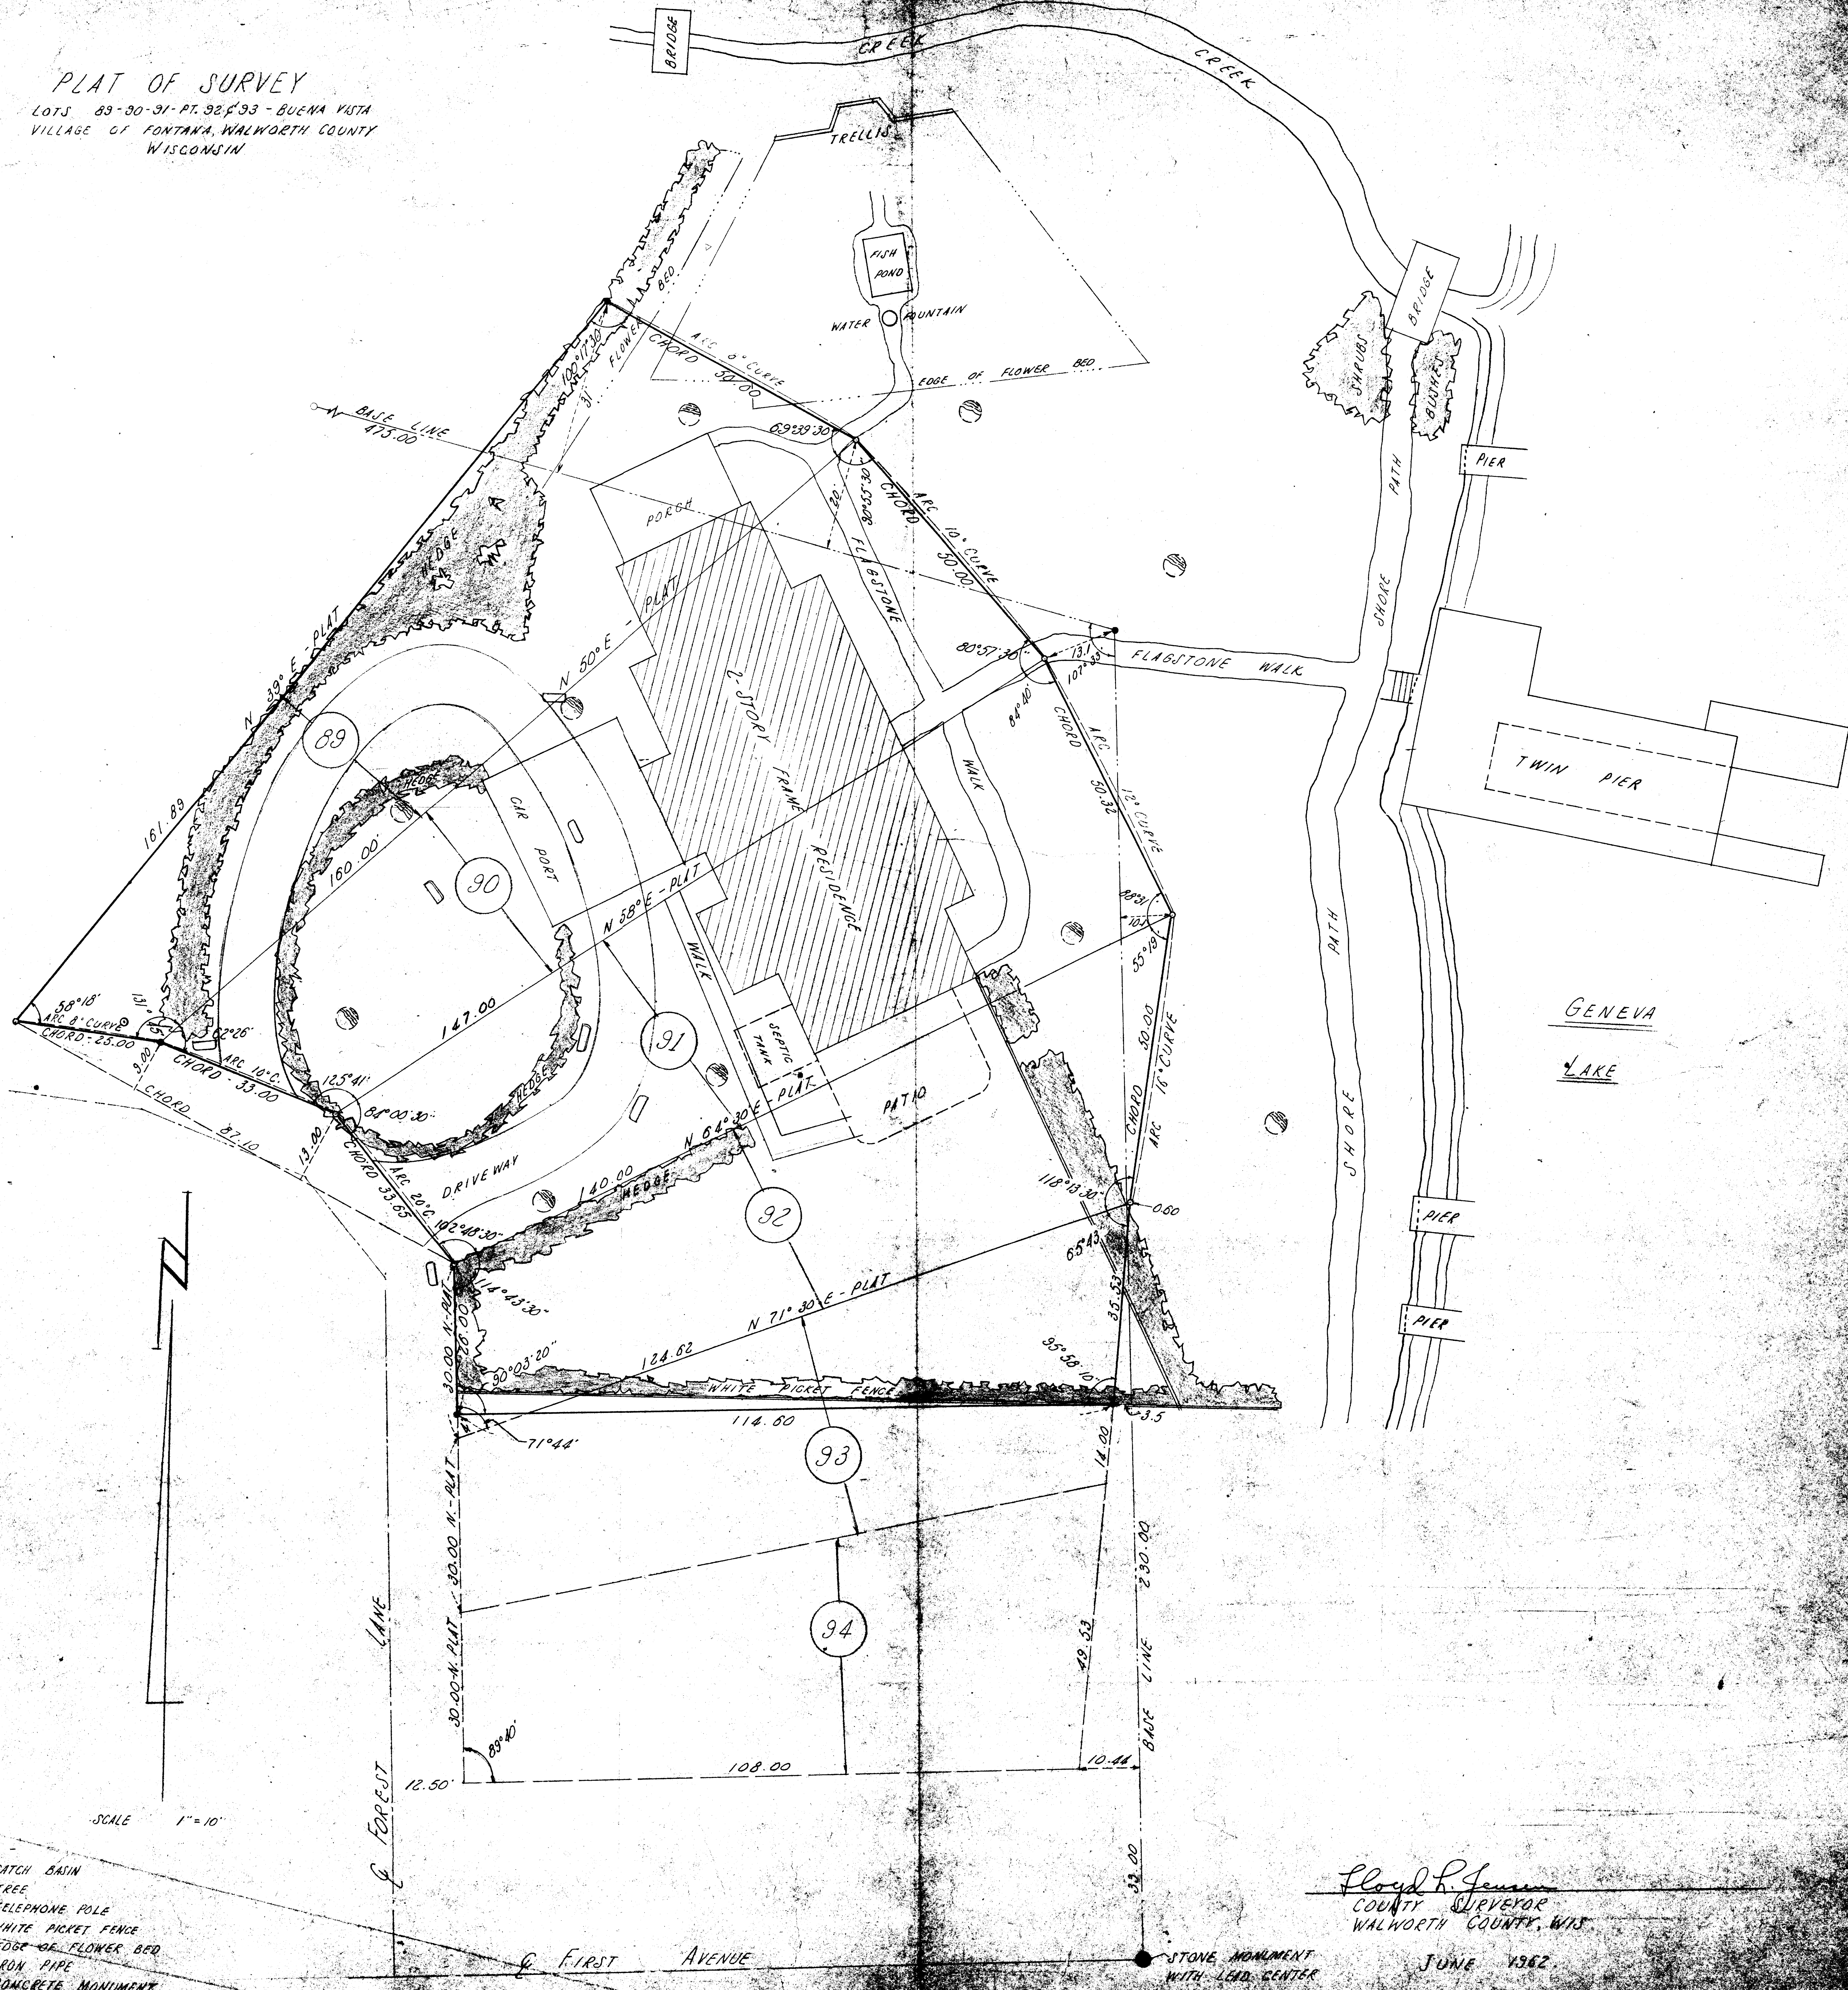

- LEGEND -
- CATCH BASIN
 - TREE
 - TELEPHONE POLE
 - WHITE PICKET FENCE
 - EDGE OF FLOWER BED
 - IRON PIPE
 - CONCRETE MONUMENT

SCALE 1" = 10'

Lloyd R. Jensen
COUNTY SURVEYOR
WALWORTH COUNTY, WIS.

JUNE 1962