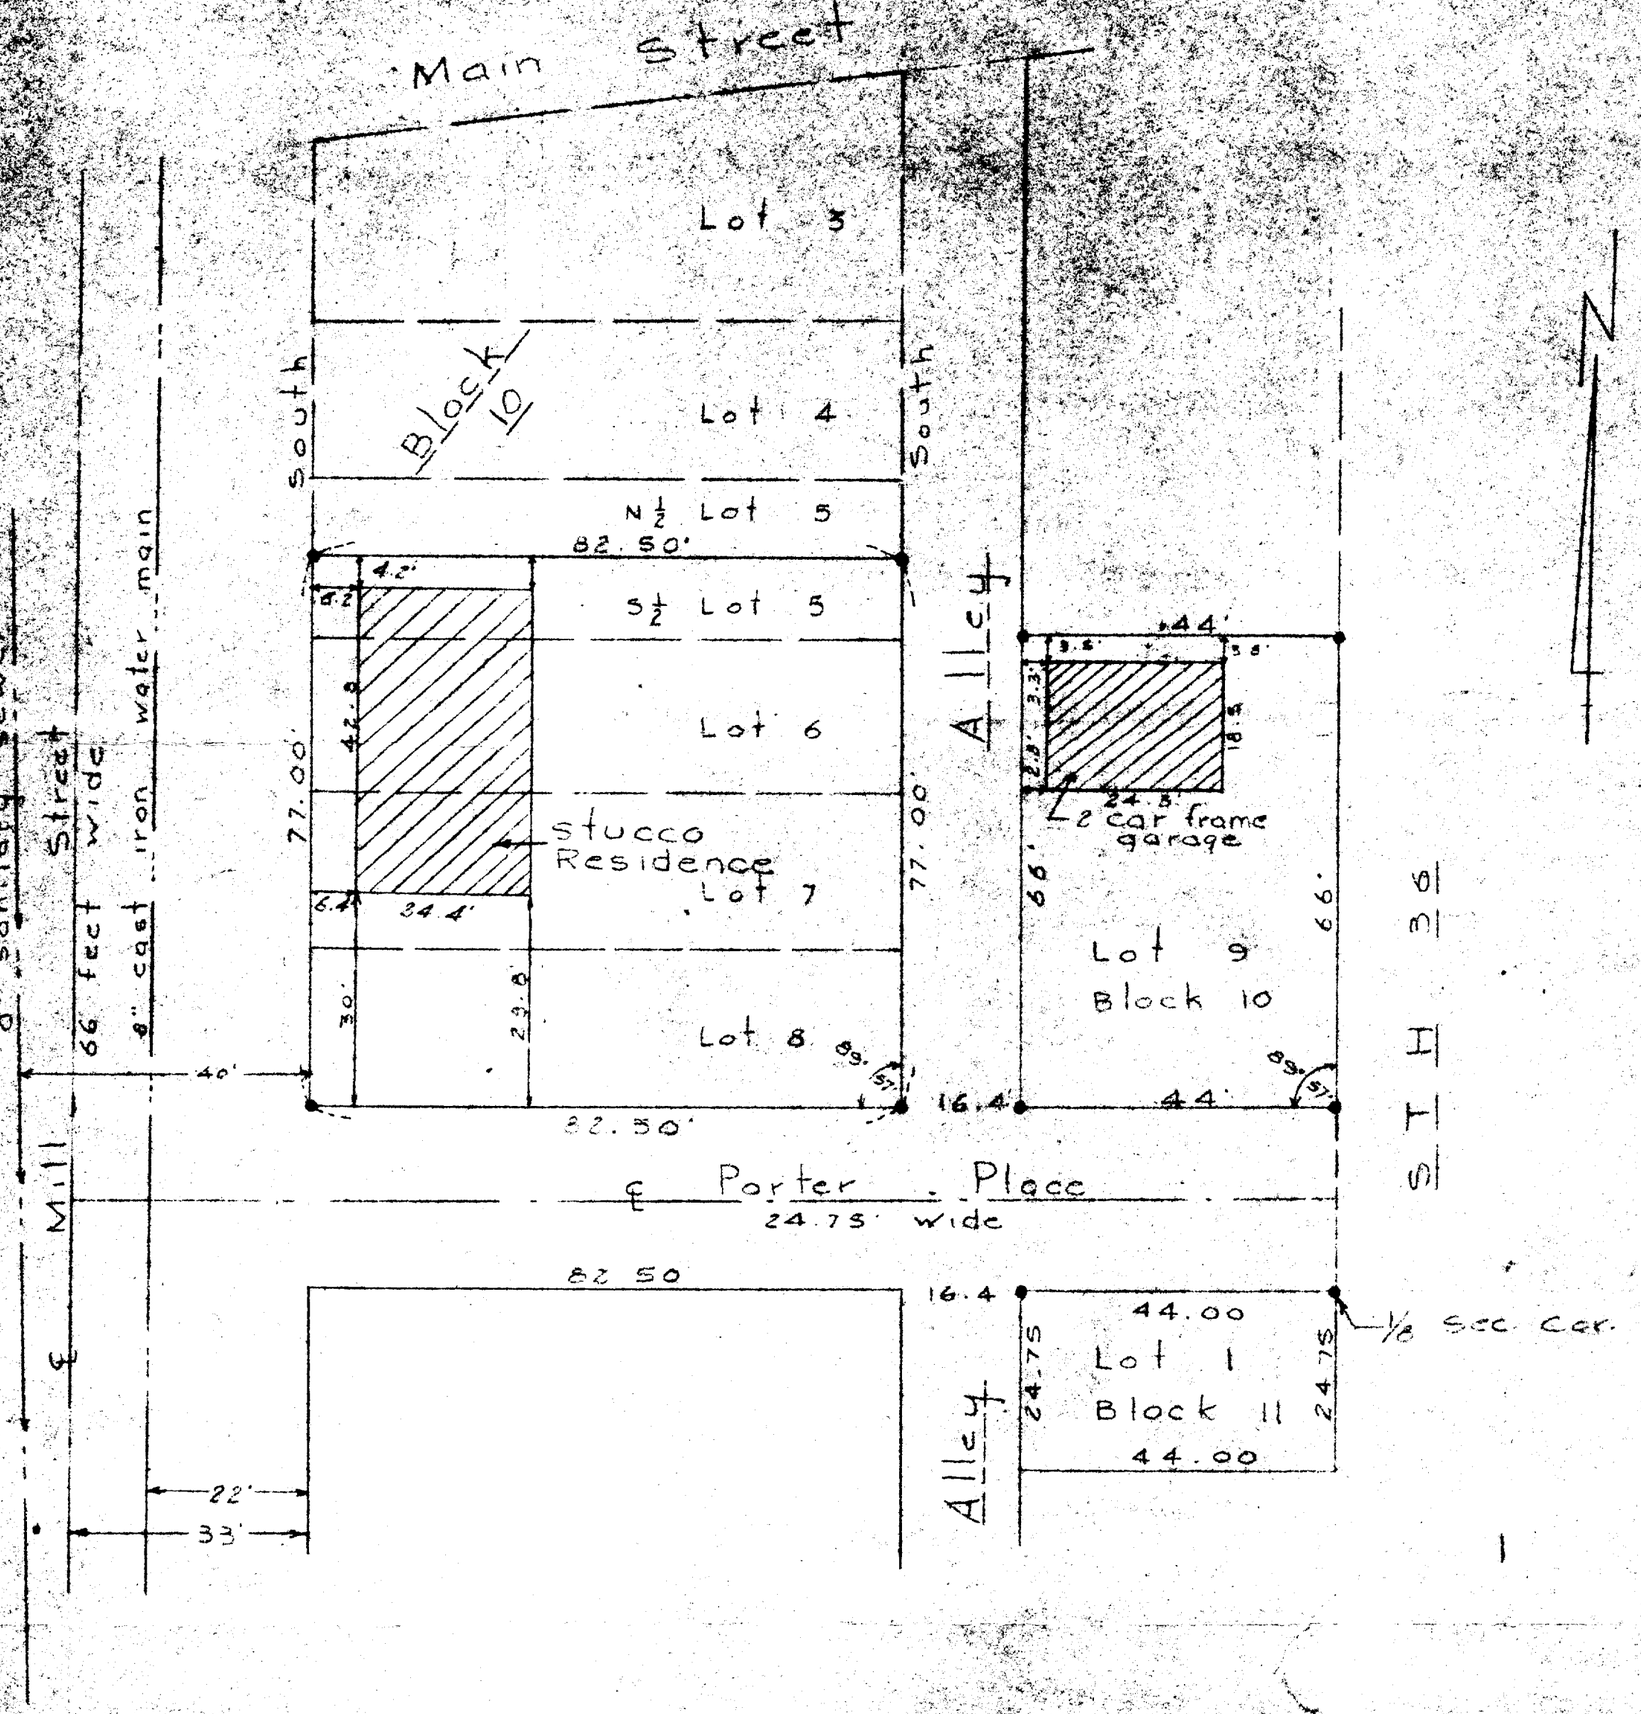


LEGEND

• = Concrete monument

PLAT OF SURVEY OF

S ½ Lot 5, all of Lots 5, 6, 7, 8, 9 Block 10 and Lot 1 Block 11 of the Original Plat of Fontana, T 1 N R 16 E Walworth County, Wis.