
HAROLD H. KOLB

REGISTERED PROFESSIONAL LAND SURVEYOR
LAKE GENEVA, WISCONSIN

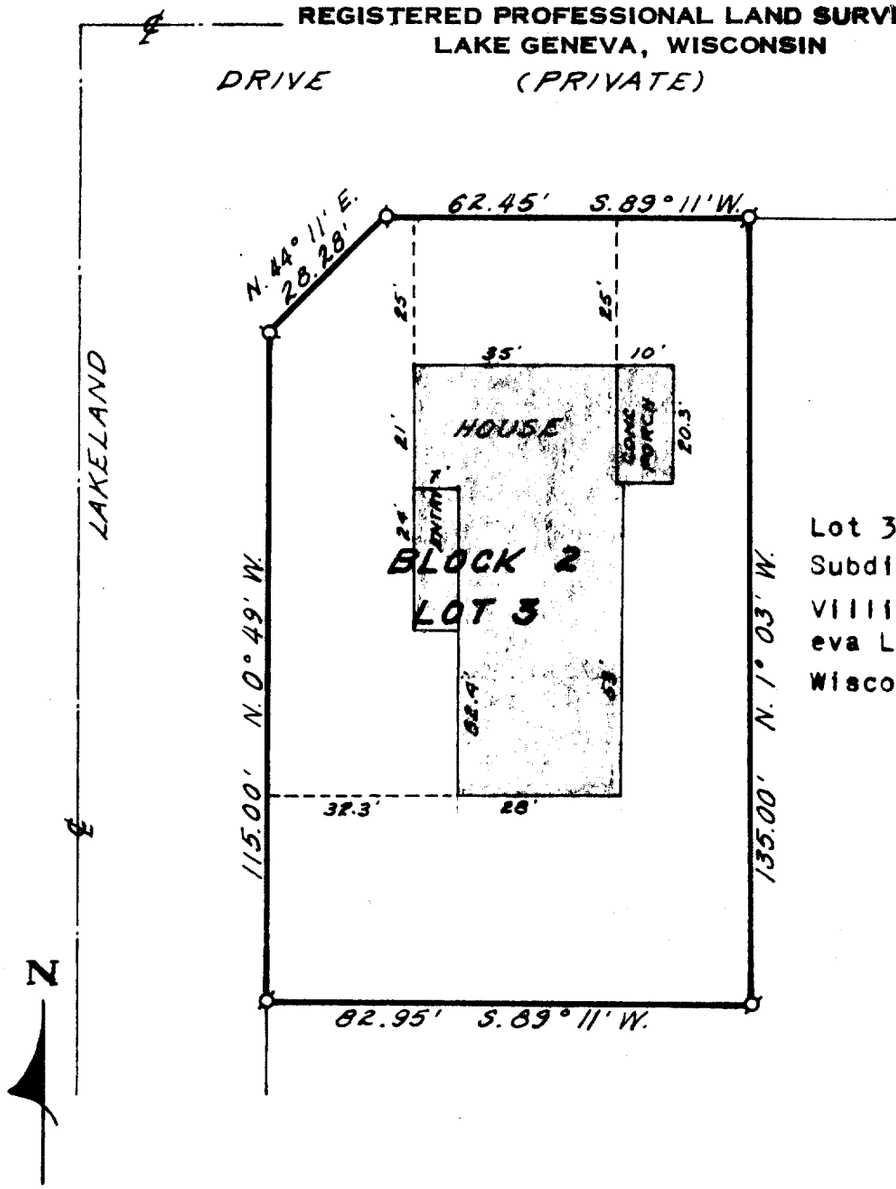

PLAT OF SURVEY OF

Lot 3, Block 2, Brookwood Subdivision, located in the Village of Fontana on Geneva Lake, Walworth County, Wisconsin.

LEGEND

- ⌀ — IRON PIPE FOUND
- o — IRON PIPE PLACED
- ● — CONCRETE MONUMENT
- x — SPIKE

SCALE: 1" = 30'

WISCONSIN
HAROLD H. KOLB
S-187
LAKE GENEVA, WIS.
LAND SURVEYOR

I, HAROLD H. KOLB, DO HEREBY CERTIFY THAT I HAVE SURVEYED THE PROPERTY HEREON DESCRIBED ACCORDING TO THE OFFICIAL RECORDS, AND THAT THE PLAT HEREON IS A CORRECT REPRESENTATION OF THE LOT LINES, and the principal lines of the buildings thereon.

Harold H. Kolb
HAROLD H. KOLB
WISCONSIN REGISTERED LAND SURVEYOR, S—187
DATE August 27, 1968

SBS-16

5-182