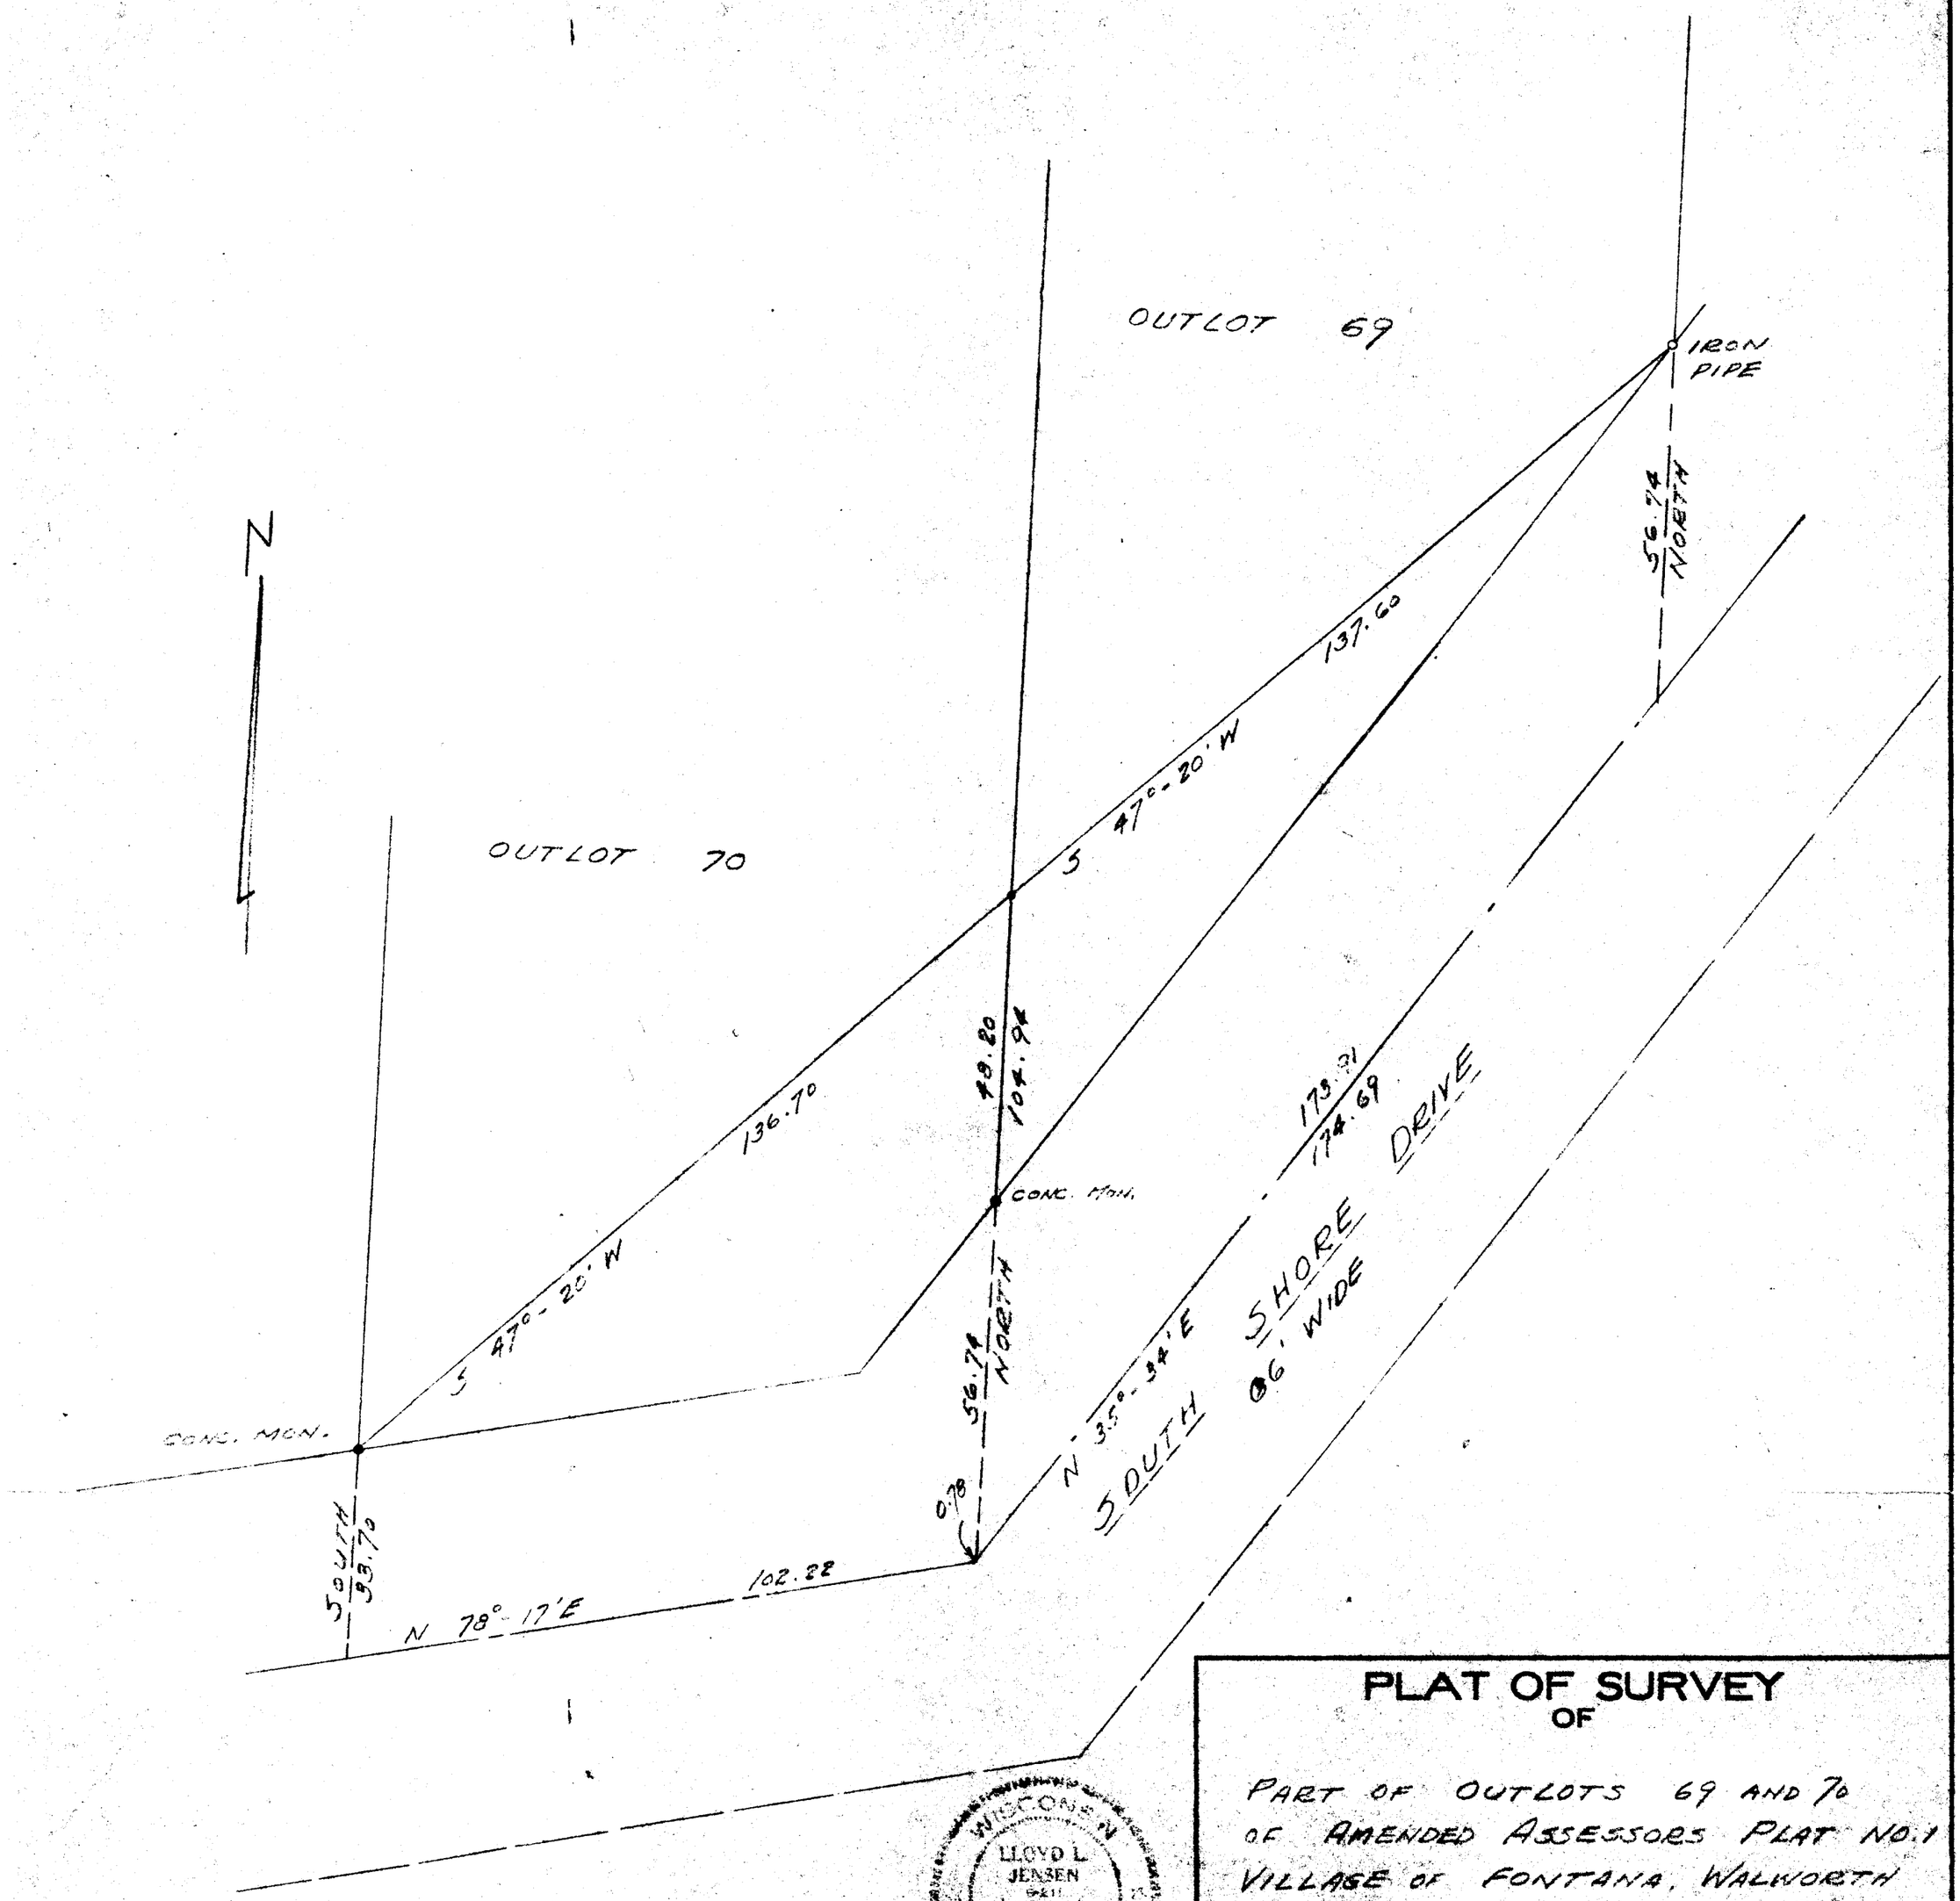

PLAT OF SURVEY
OF

PART OF OUTLOTS 69 AND 70
OF AMENDED ASSESSORS PLAT NO. 1
VILLAGE OF FONTANA, WALWORTH
COUNTY, WISCONSIN.

Lloyd L. Jensen

SCALE 1" = 20'

DATE Dec. 1966

WISCONSIN LLOYD L. JENSEN 9211 ELKHORN, WIS. REGISTERED LAND SURVEYOR

5-197J

S ST FV-109 + FV-111