

PLAT OF SURVEY

LOT 4 OF COUNTRY CLUB ESTATES ADDITION "K"
LOCATED IN THE VILLAGE OF FONTANA–ON–GENEVA LAKE
WALWORTH COUNTRY, WISCONSIN

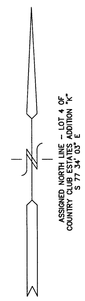

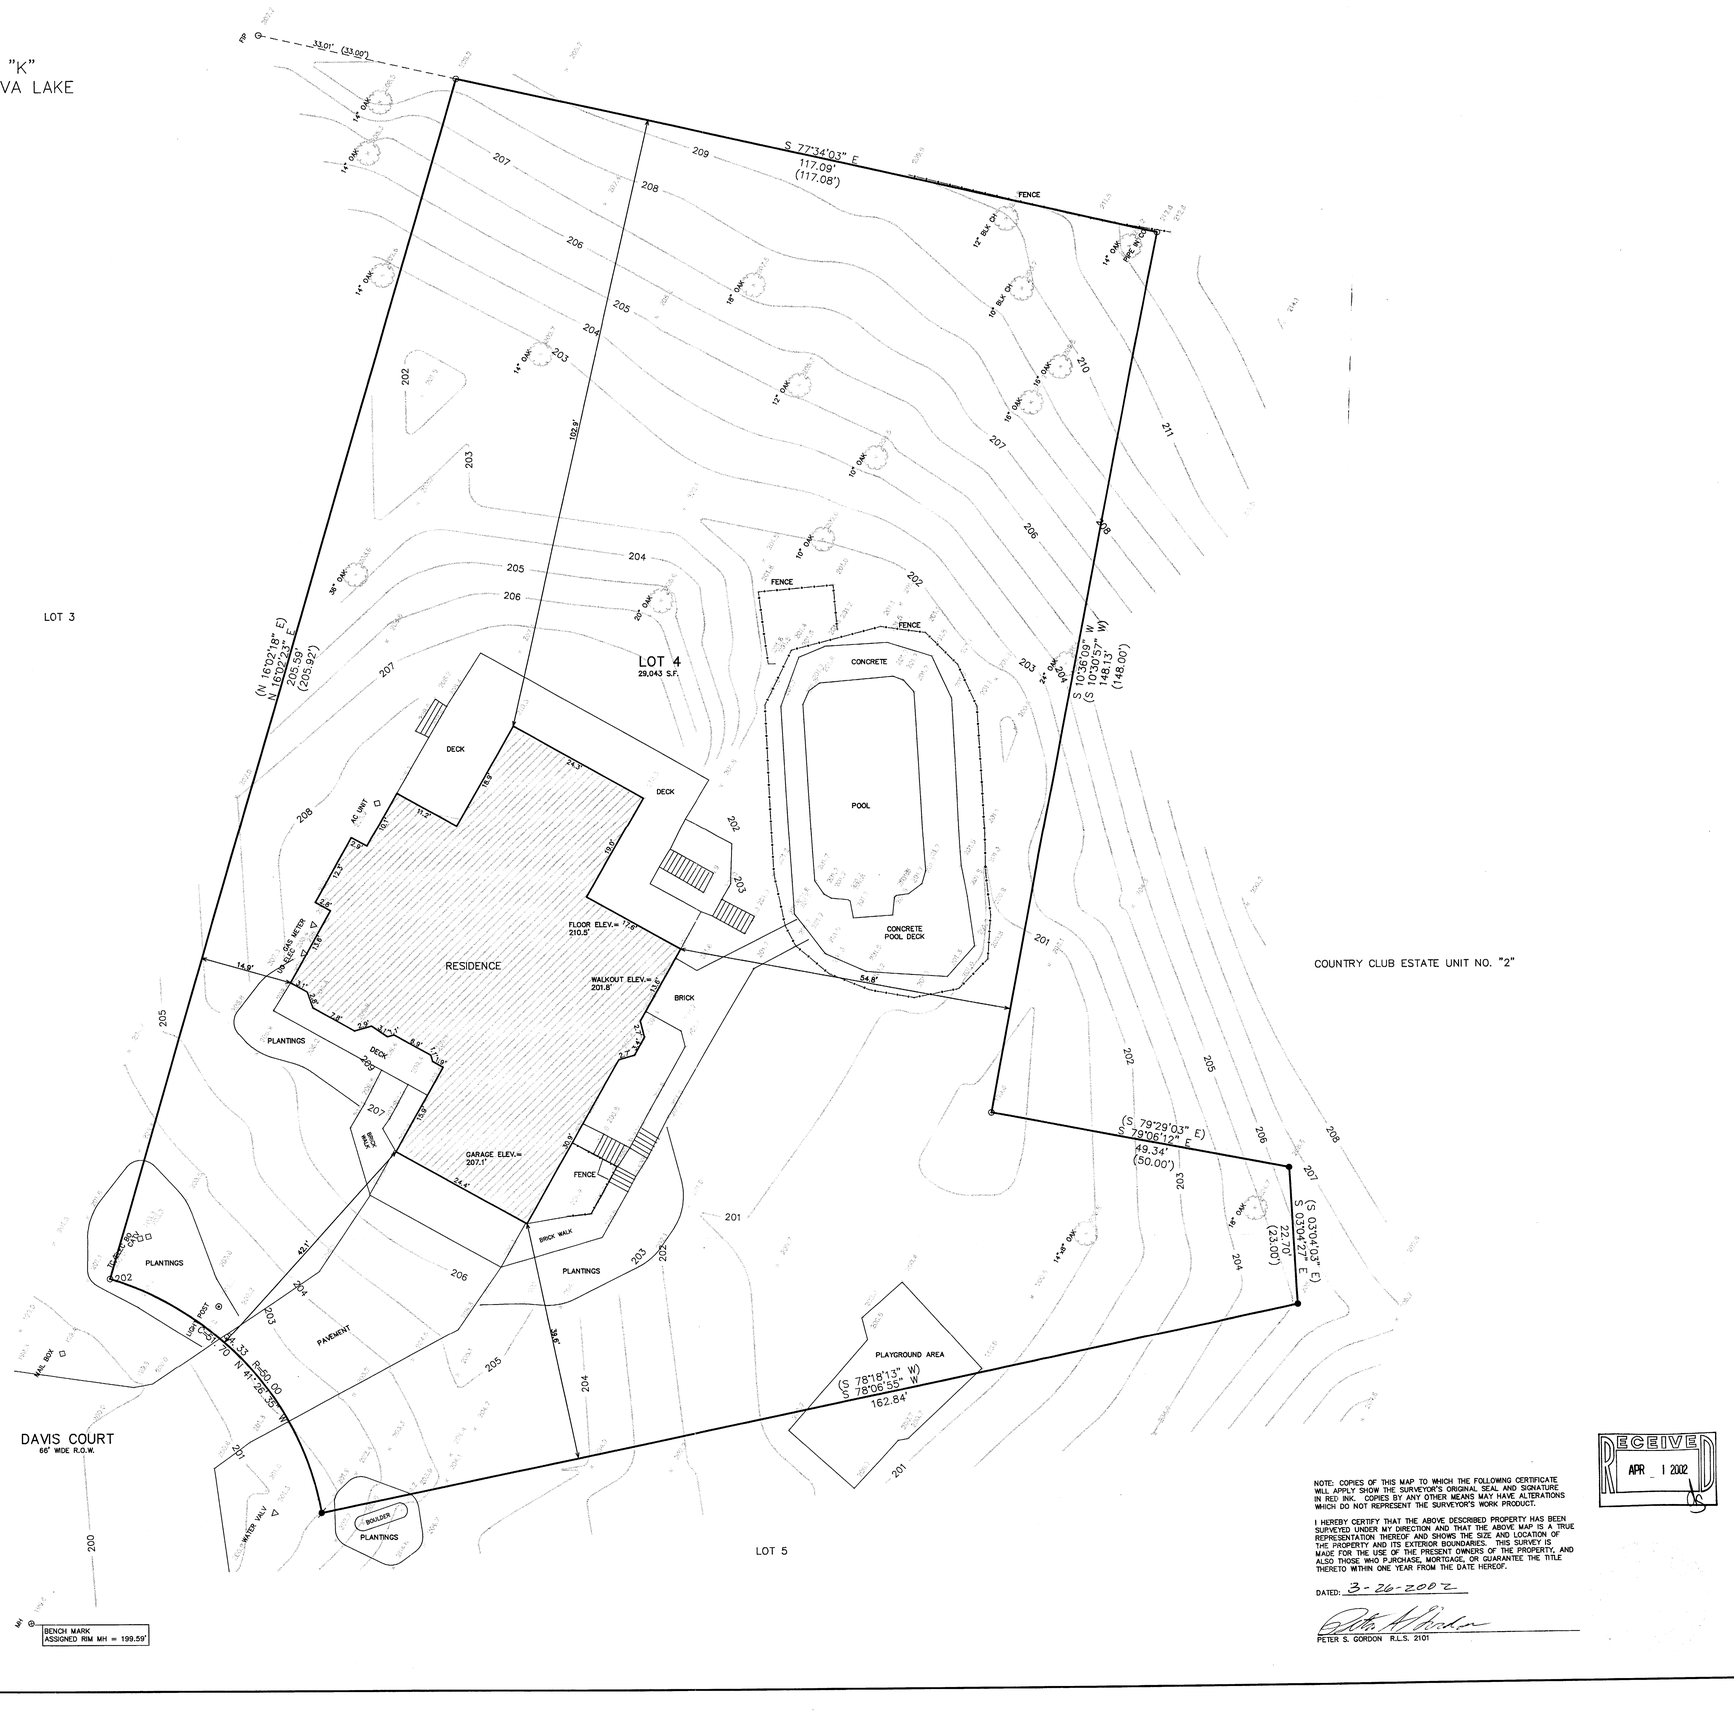

LEGEND

O = FOUND IRON PIPE STAKE
● = FOUND IRON REBAR STAKE
◉ = SET IRON REBAR STAKE
(XXXX) = RECORDRD AS

5 0 5 10 15 20 25 30 35 40 45 50
MAP SCALE IN FEET ORIGINAL 1" = 10'

NOTE: COPIES OF THIS MAP TO WHICH THE FOLLOWING CERTIFICATE WILL APPLY SHOW THE SURVEYOR'S ORIGINAL SEAL AND SIGNATURE IN RED INK. COPIES BY ANY OTHER MEANS MAY HAVE ALTERATIONS WHICH DO NOT REPRESENT THE SURVEYOR'S WORK PRODUCT.

I HEREBY CERTIFY THAT THE ABOVE DESCRIBED PROPERTY HAS BEEN SURVEYED UNDER MY DIRECTION AND THAT THE ABOVE MAP IS A TRUE REPRESENTATION THEREOF AND SHOWS THE SIZE AND LOCATION OF THE PROPERTY AND ITS EXTERIOR BOUNDARIES. THIS SURVEY IS MADE FOR THE USE OF THE PRESENT OWNERS OF THE PROPERTY, AND ALSO THOSE WHO PURCHASE, MORTGAGE, OR GUARANTEE THE TITLE THERETO WITHIN ONE YEAR FROM THE DATE HEREOF.

DATED: 3-26-2002

PETER S. GORDON R.L.S. 2101

RECEIVED
APR - 1 2002

– WORK ORDERED BY –
PAT MCINTOSH
MCCORMACK ETTEN
1003 DAVIS COURT
FONTANA, WI 53125

FARRIS, HANSEN & ASSOCIATES, INC.
ENGINEERING – ARCHITECTURE – SURVEYING
7 RIDGWAY COURT P.O. BOX 437
ELKHORN, WISCONSIN 53121
OFFICE: (262) 723–2098 FAX: (262) 723–5886

REVISIONS

PROJECT NO.
6004
DATE
03/22/02
SHEET NO.
1 OF 1

MAR 2 6 2002

SDTK-41 005-1969