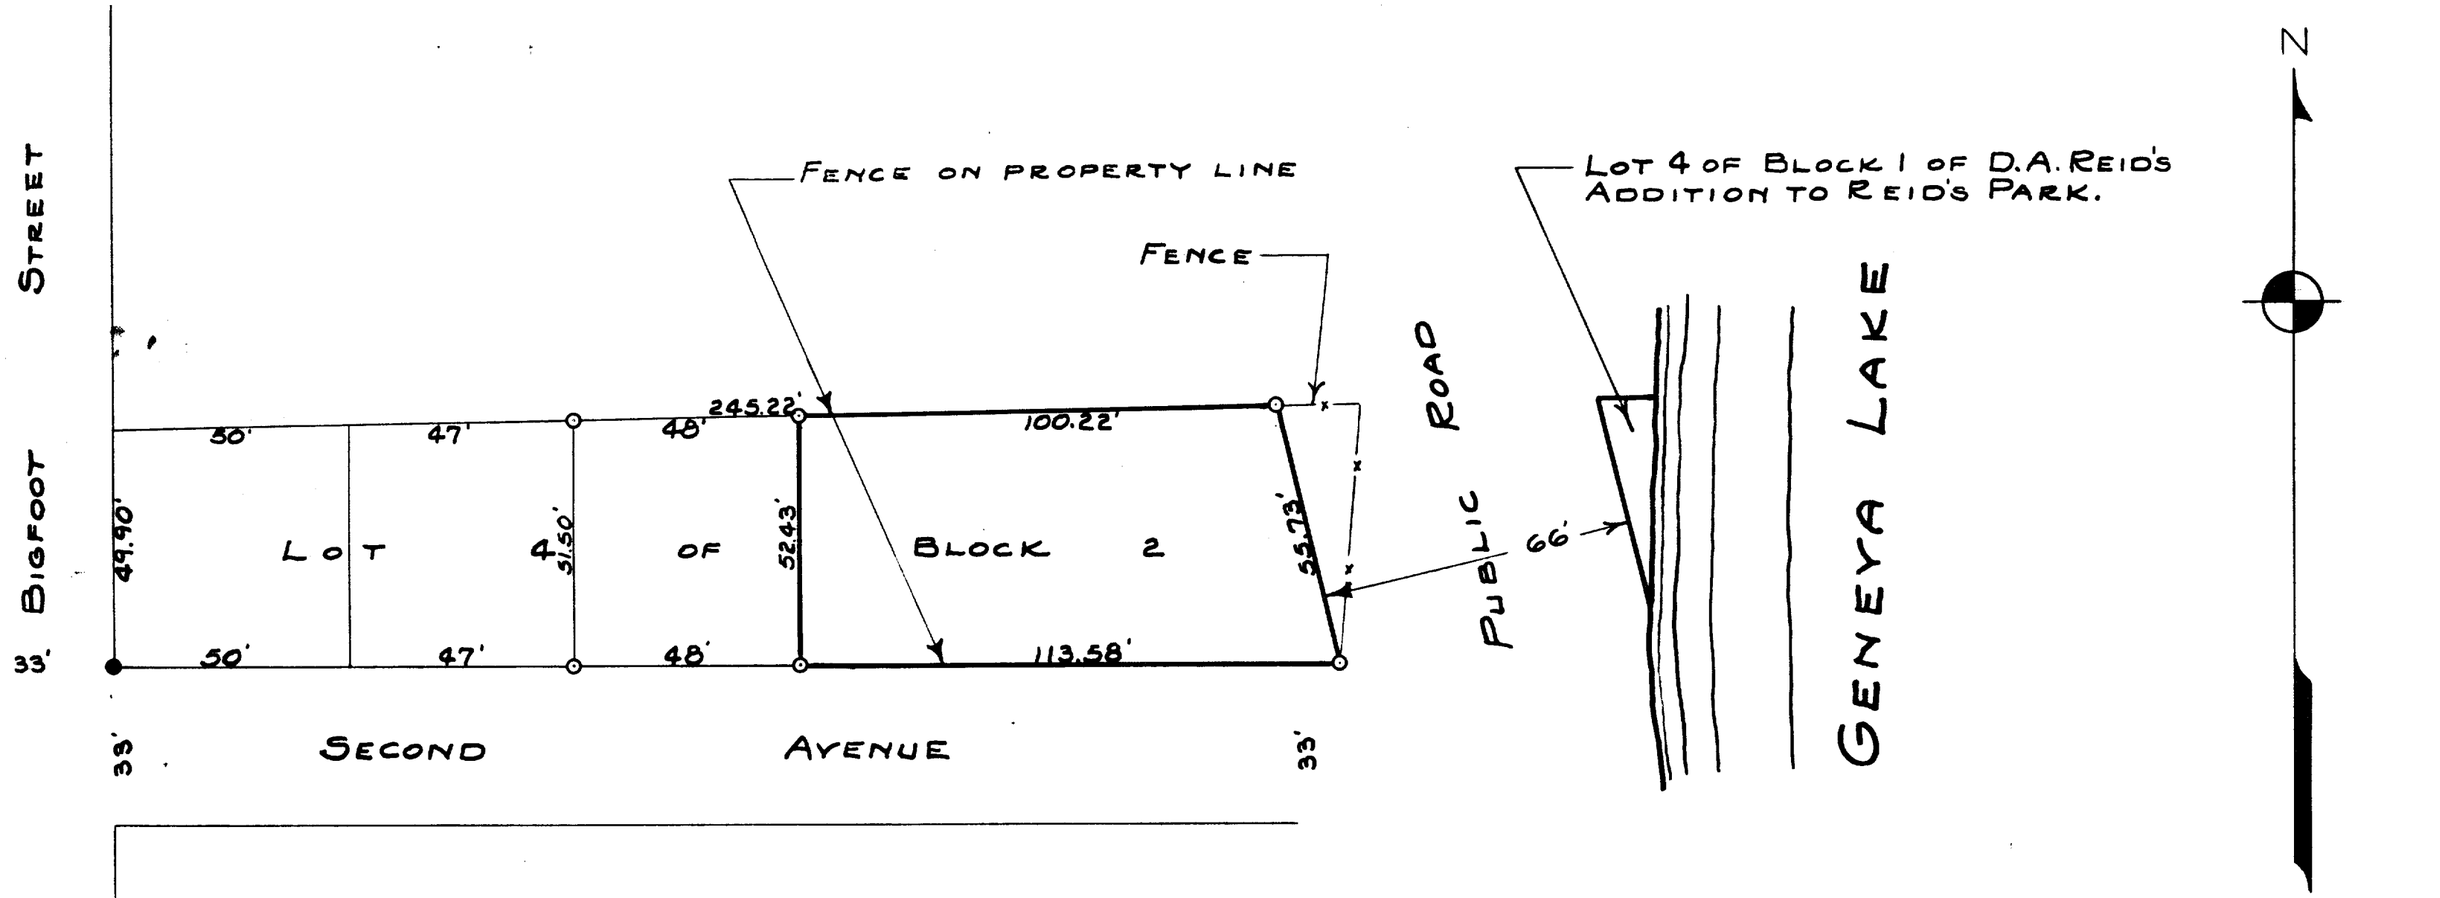


PLAT OF SURVEY OF LOT 4 OF BLOCK 2 OF D.A. REID'S ADDITION TO REID'S PARK LOCATED IN THE VILLAGE OF FONTANA-ON-GENEVA LAKE, WALWORTH COUNTY WISCONSIN.

Lloyd L. Jensen
COUNTY SURVEYOR

JUNE 1944

5-19 J