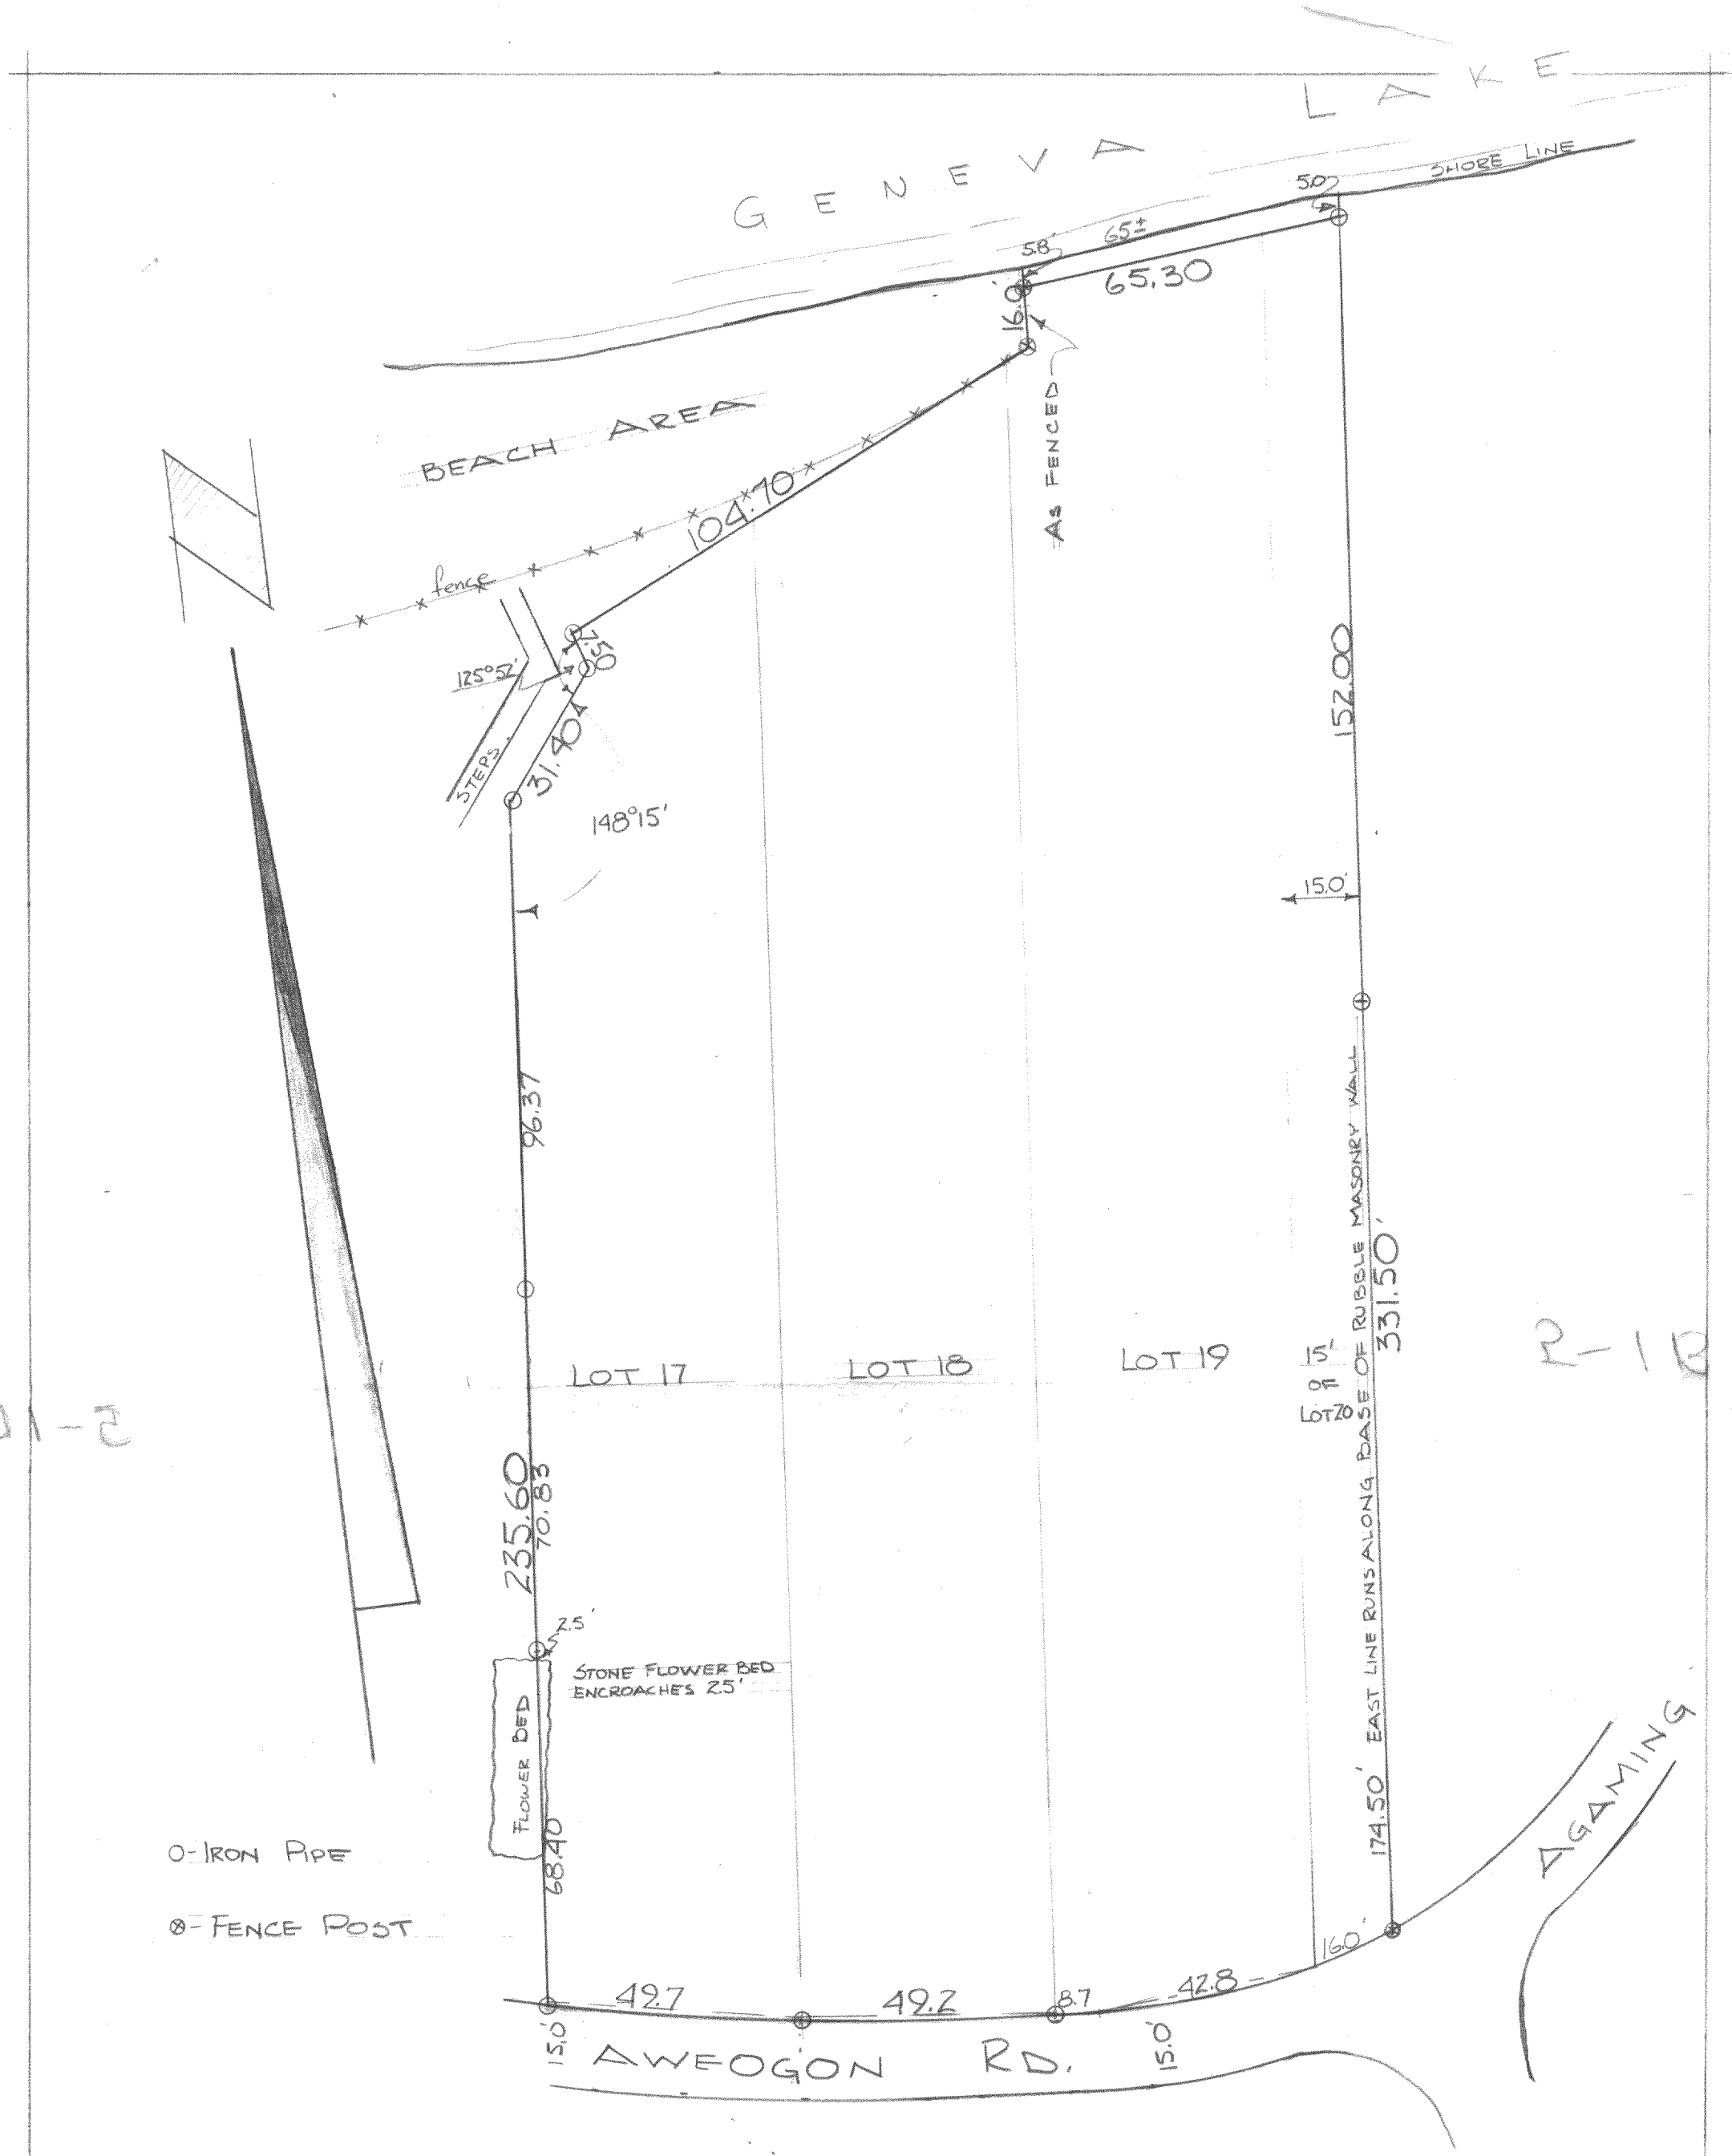

O- IRON PIPE

⊗- FENCE POST

DESCRIPTION: Lots 17, 18, 19, & the West ½ of Lot 20.00 excepting the East 10.00 feet thereof, in Block # 1, of Indian Hills Subdivision in the Village of Fontana, Walworth County, Wisconsin.

CERTIFICATE: I, James F. Biagi, surveyor, do hereby certify that I have surveyed the property hereon described on this 26th day of July, 1961.

WISCONSIN JAMES F. BIAGI MILWAUKEE, WIS. LAND SURVEYOR

James F. Biagi, (RLS 272)

S1H-18

5-1B