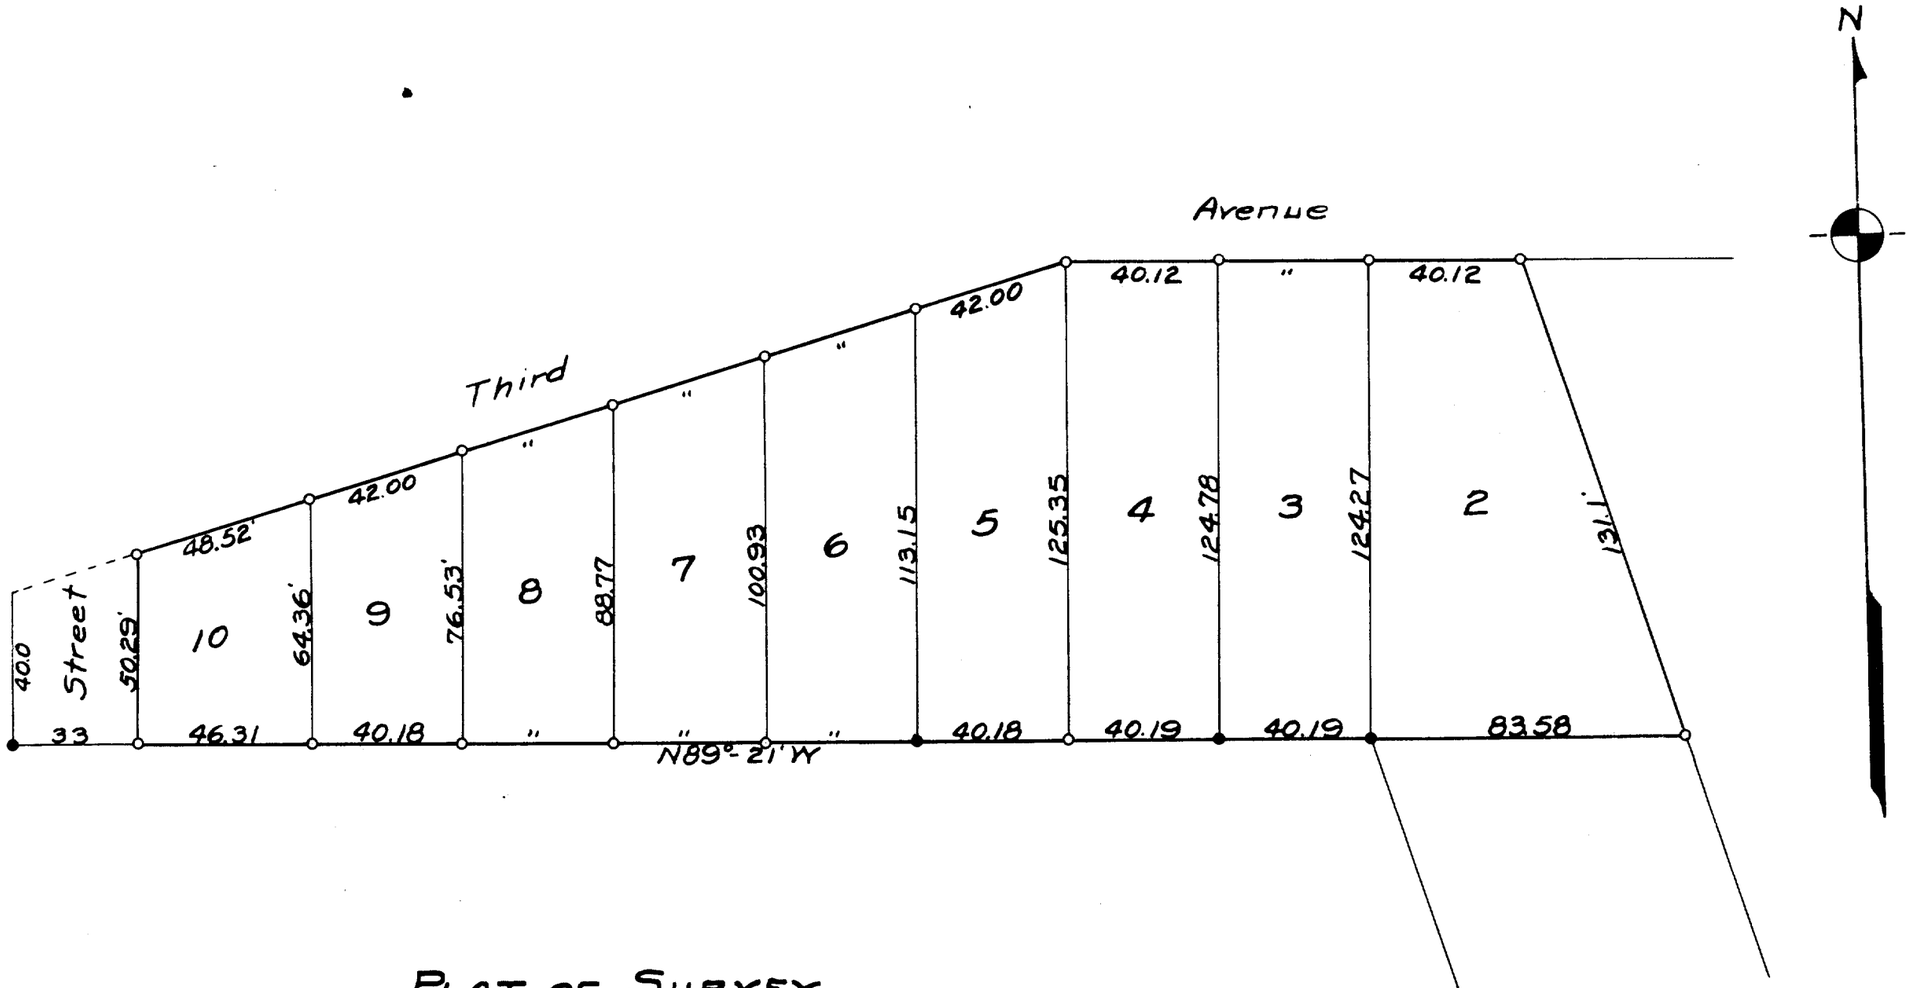


PLAT OF SURVEY

OF

BLOCK 6 OF D.A. REID'S ADDITION

TO THE VILLAGE OF FONTANA

Nov. 1935

Lloyd L. Jensen
County Surveyor

LEGEND
•-Conc. Monu.
o-Iron pipe
Scale 1" = 40'

5-1J