
HAROLD H. KOLB

REGISTERED PROFESSIONAL LAND SURVEYOR
LAKE GENEVA, WISCONSIN

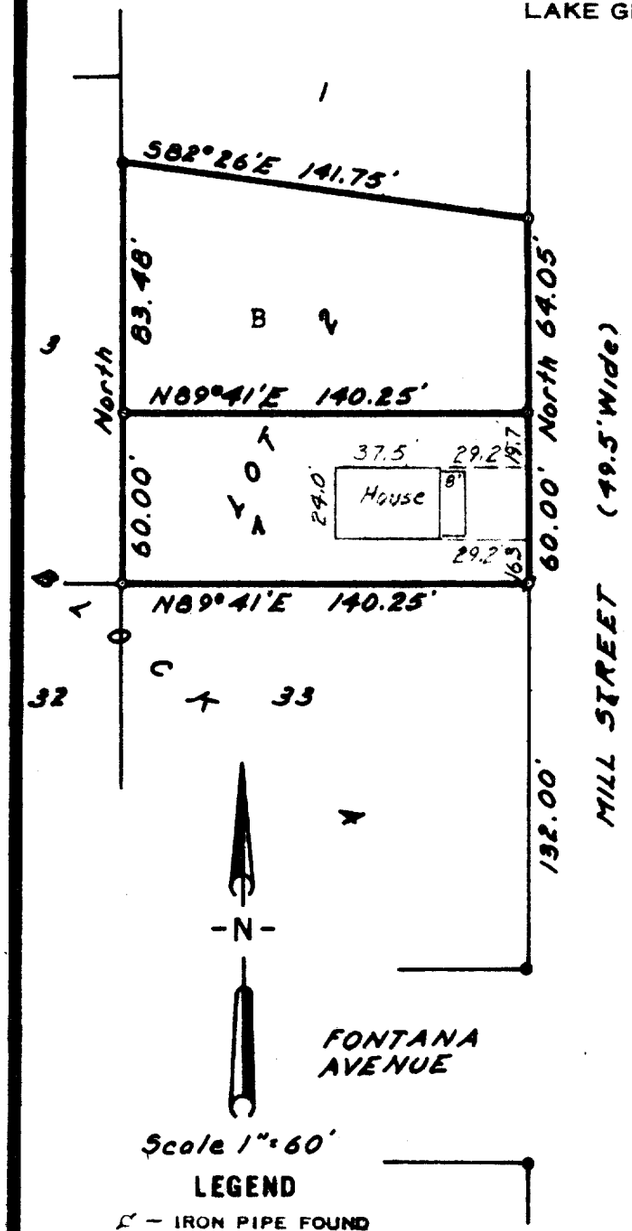

LEGEND

- ℄ — IRON PIPE FOUND
- ○ — IRON PIPE PLACED
- ● — CONCRETE MONUMENT
- X — SPIKE

PLAT OF SURVEY OF

Lot 2, Block 4, Assessor's Plat of C.L. Douglas Subdivision, Village of Fontana-on-Geneva Lake, Walworth County, Wisconsin and described as follows; towit:

PARCEL A

The South 60 feet of said Lot 2.

PARCEL B

All of said Lot 2 except the South 60 feet.

I, HAROLD H. KOLB, DO HEREBY CERTIFY THAT I HAVE SURVEYED THE PROPERTY HEREON DESCRIBED ACCORDING TO THE OFFICIAL RECORDS, AND THAT THE PLAT HEREON IS A CORRECT REPRESENTATION OF THE LOT LINES.

Harold H. Kolb
HAROLD H. KOLB
WISCONSIN REGISTERED LAND SURVEYOR, S—187
DATE October 28, 1964

STFV-205

5-204