


DUNHAM SURVEYING, S.C.
SURVEYING & SUBDIVIDING
DELAVER, WISCONSIN 53115

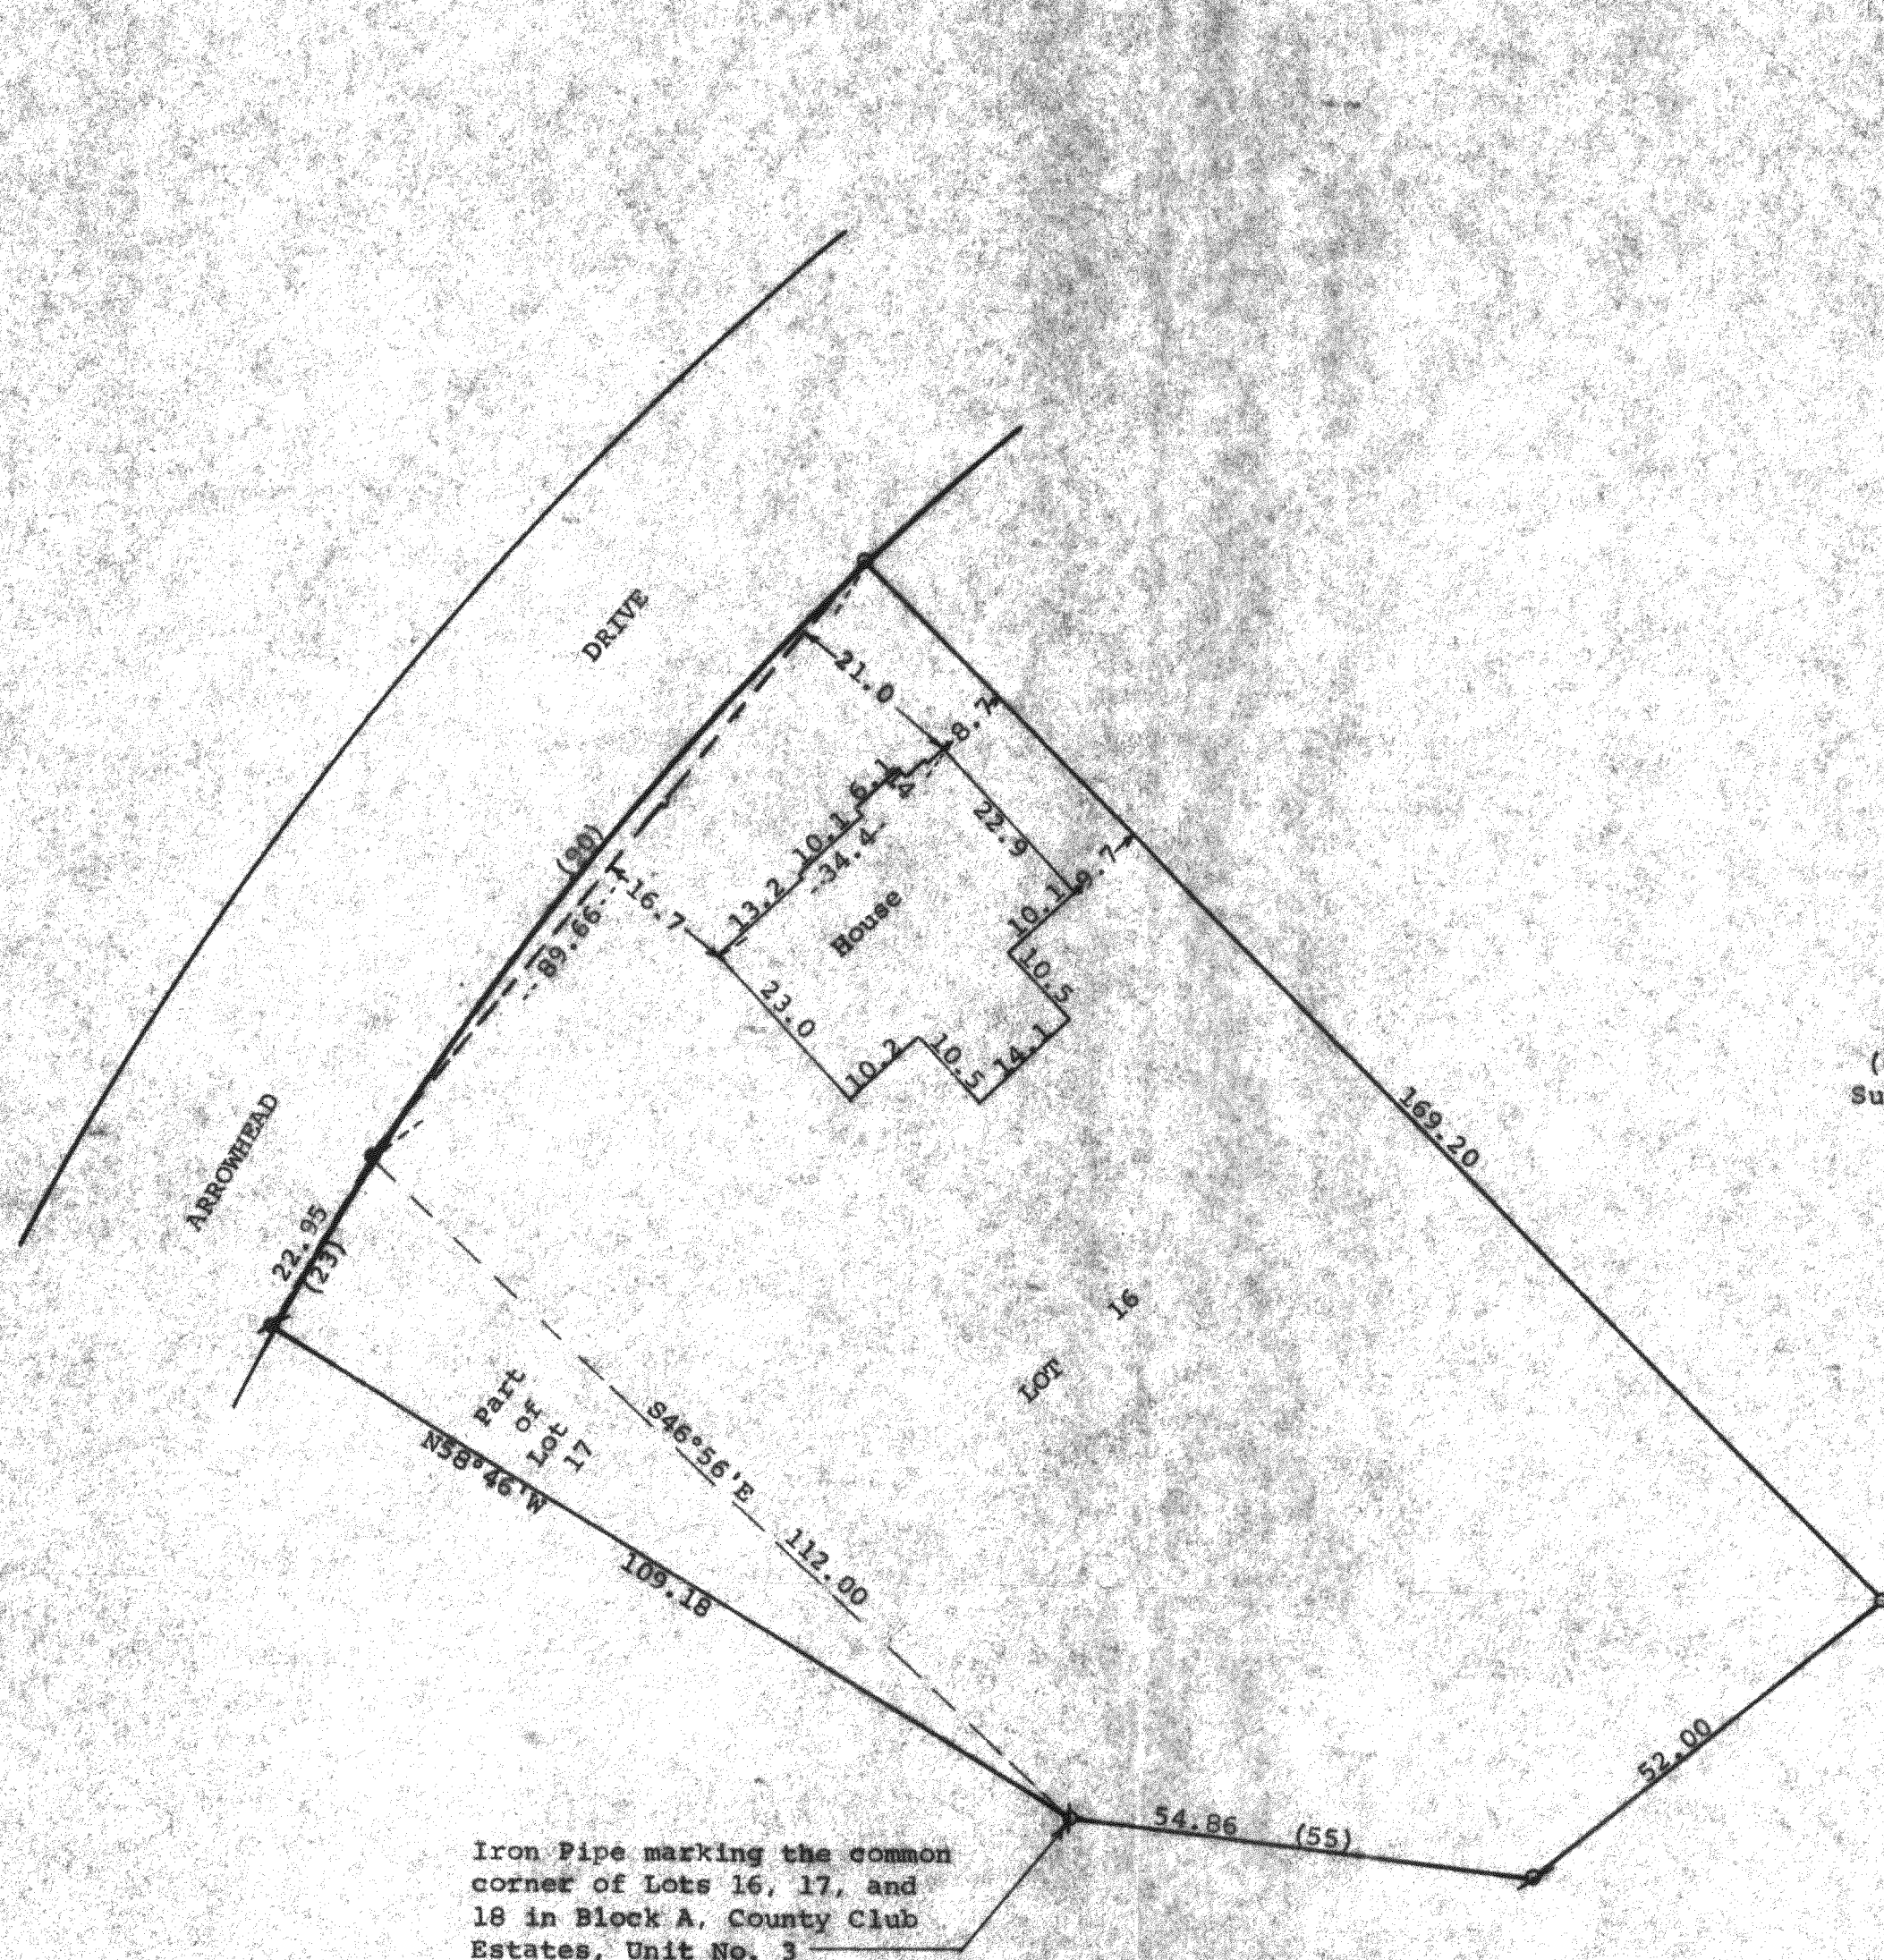

STATE OF WISCONSIN)
 COUNTY OF WALWORTH) SS

I, George T. Dunham, Surveyor, certify that I have surveyed the property described as follows:

Lot 16 in Block "A", Unit No. 3, Country Club Estates, Village of Fontana-on-Geneva Lake, Walworth County, Wisconsin. Also part of Lot 17, Block "A", Unit No. 3, Country Club Estates, Village of Fontana-on-Geneva Lake, Walworth County, Wisconsin, described as follows: Begin at the iron pipe marking the common corner of Lots 16, 17, and 18 of said Block A, Unit No. 3, Country Club Estates; thence N58°46'W 109.18 feet to the east line of Arrowhead Drive; thence northeasterly on the east line of Arrowhead Drive 23.00 feet more or less to a "PK" nail; thence S46°56'E 112.00 feet on the lot line between Lots 16 and 17 to the point of beginning.

and that the plat shown hereon is a correct representation thereof and shows the size and location of the property, its exterior boundaries, the location of all visible structures and dimensions of all principal buildings thereon, boundary fences, apparent easements, roadways and visible encroachments, if any, and that I have surveyed the property hereon described, according to the official records, to the best of my knowledge and belief.

August 18, 1998

George T. Dunham
 George T. Dunham, Surveyor

