
HAROLD H. KOLB
REGISTERED PROFESSIONAL LAND SURVEYOR
LAKE GENEVA, WISCONSIN

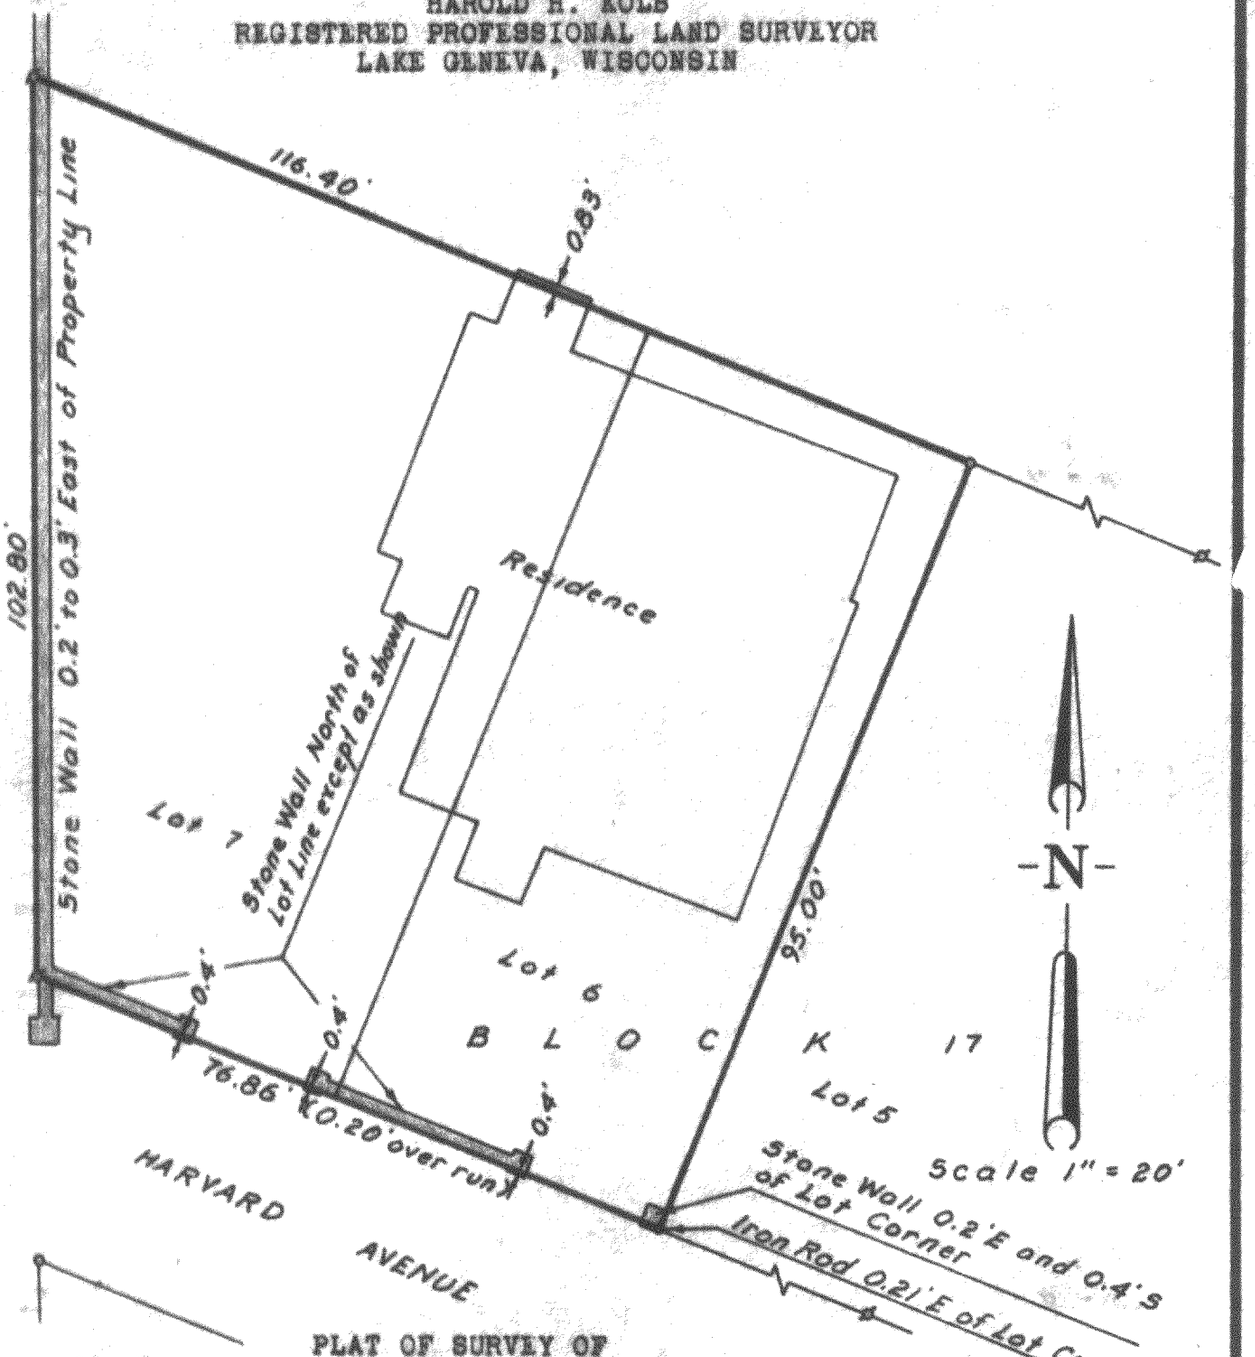

PLAT OF SURVEY OF
Lots 6 and 7, Block 17, Glenwood Springs Subdivision, Village of Fontana-on-Geneva Lake, Walworth County, Wisconsin.

Harold H. Kolb
Harold H. Kolb, Wisconsin Surveyor, S-187
DATE: April 21, 1964

NOTE: Village of Fontana has easement on Harvard Avenue, as shown in Vol. 404, page 463 of Deeds in the Walworth County Rgeister of Deeds Office.

- • Iron Rod Found
- # Iron Pipe Found
- ○ Iron Pipe Placed

5-209

SGS-127

F-30