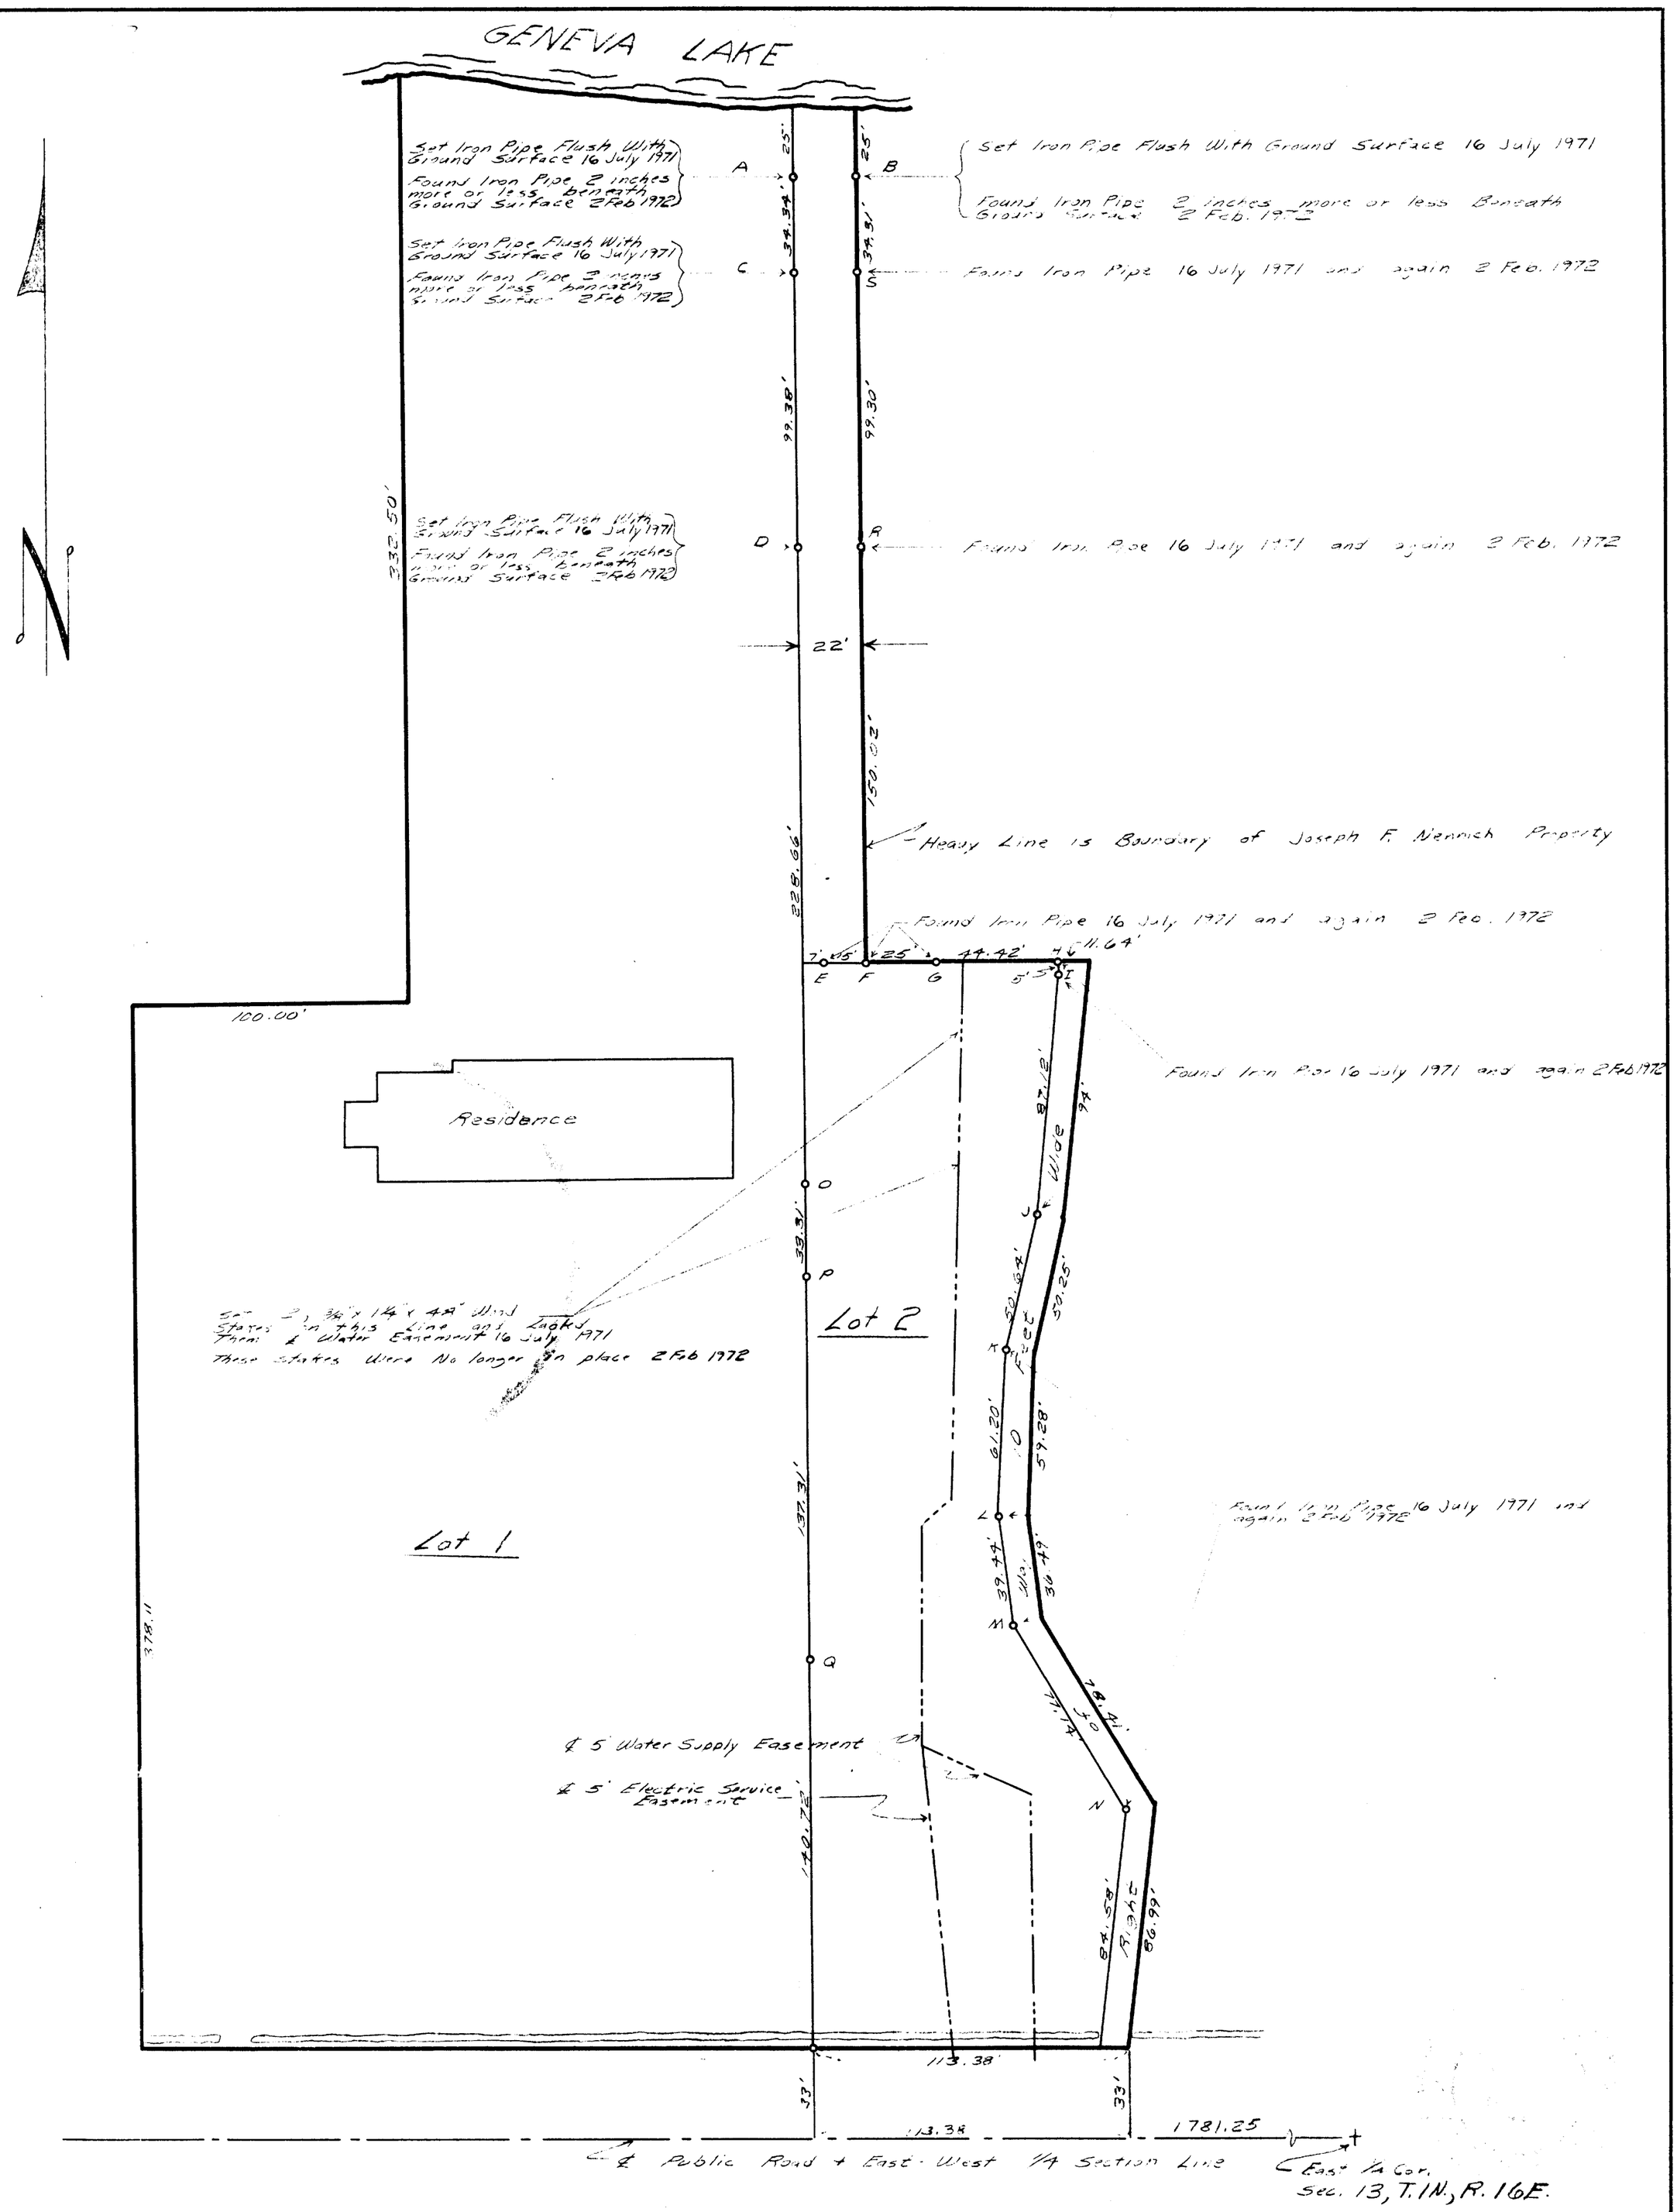

Set a 3/4" x 1 1/4" x 48" Wood Stake near each of the pipes labled A, B, C, D, F, L, O, and P. To permit the Owner to easily find the pipes which were flush with the ground surface 16 July 1971

On 2 Feb 1972 Found none of the above mentioned stakes. Set 3/8" x 1 1/4" x 48" Wood Stake near each of the pipes labled A, B, C, D, F, H, I, J, K, L, M, N, O, P, R, S

— Drawing of —

Certified Survey 113 Located in the N. 1/2 of Fractional Section 13, Township 1 North, Range 16 East, Village of Fontana-on-Geneva Lake, Walworth Co, Wis.

— Prepared For —

Joseph F. Nemnich

DRAWN BY	JENSEN & JOHNSON	SCALE:
R.A.F.	CIVIL ENGINEERS	1" = 40'
CHECKED BY Lloyd P. Jensen	ELKHORN, WIS.	REVISED
APPROVED BY	DATE 7 Feb. 1972	SHEET NO. 1 OF 1

STFU87

Cert. Survey — 113

5-209J