
HAROLD H. KOLB
REGISTERED PROFESSIONAL LAND SURVEYOR
LAKE GENEVA, WISCONSIN

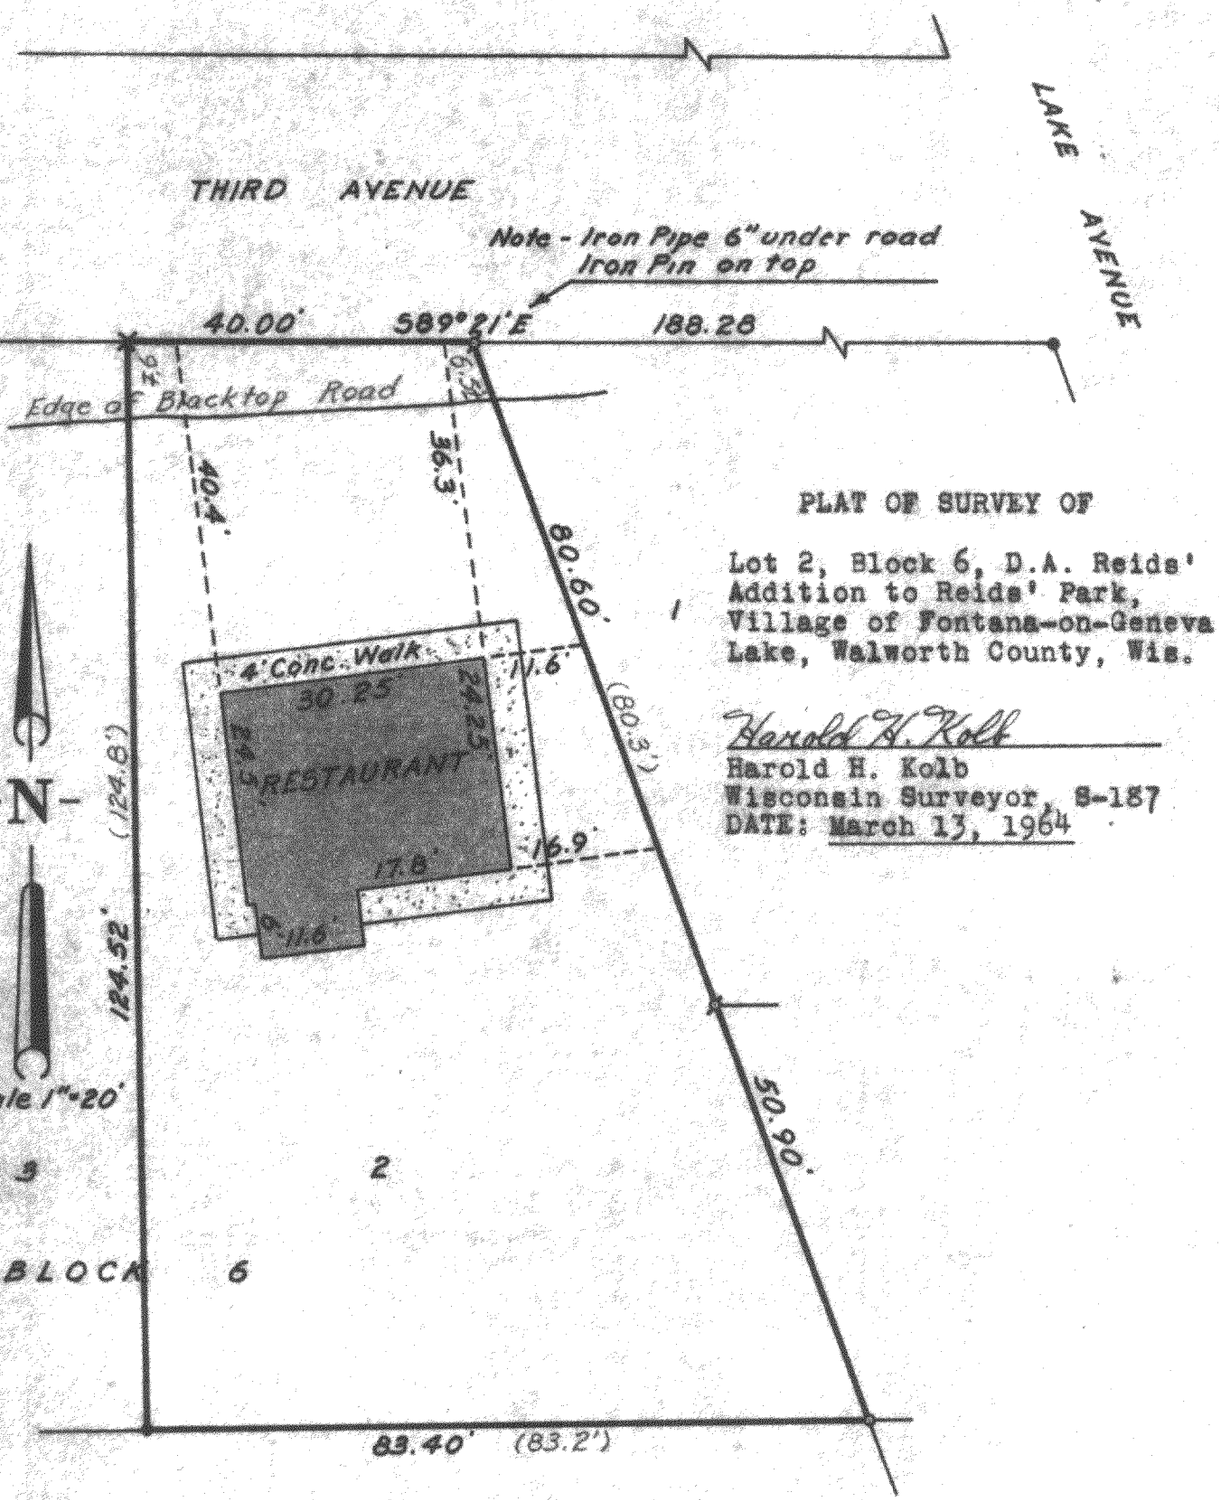

PLAT OF SURVEY OF

Lot 2, Block 6, D.A. Reids' Addition to Reids' Park, Village of Fontana-on-Geneva Lake, Walworth County, Wis.

Harold H. Kolb
Harold H. Kolb
Wisconsin Surveyor, S-157
DATE: March 13, 1964

(2') Platted Distance
x Railroad Spike Placed
● Concrete Monument Found
Ø Iron Pipe Found
○ Iron Pipe Placed

5-211

SRA-39

F-26