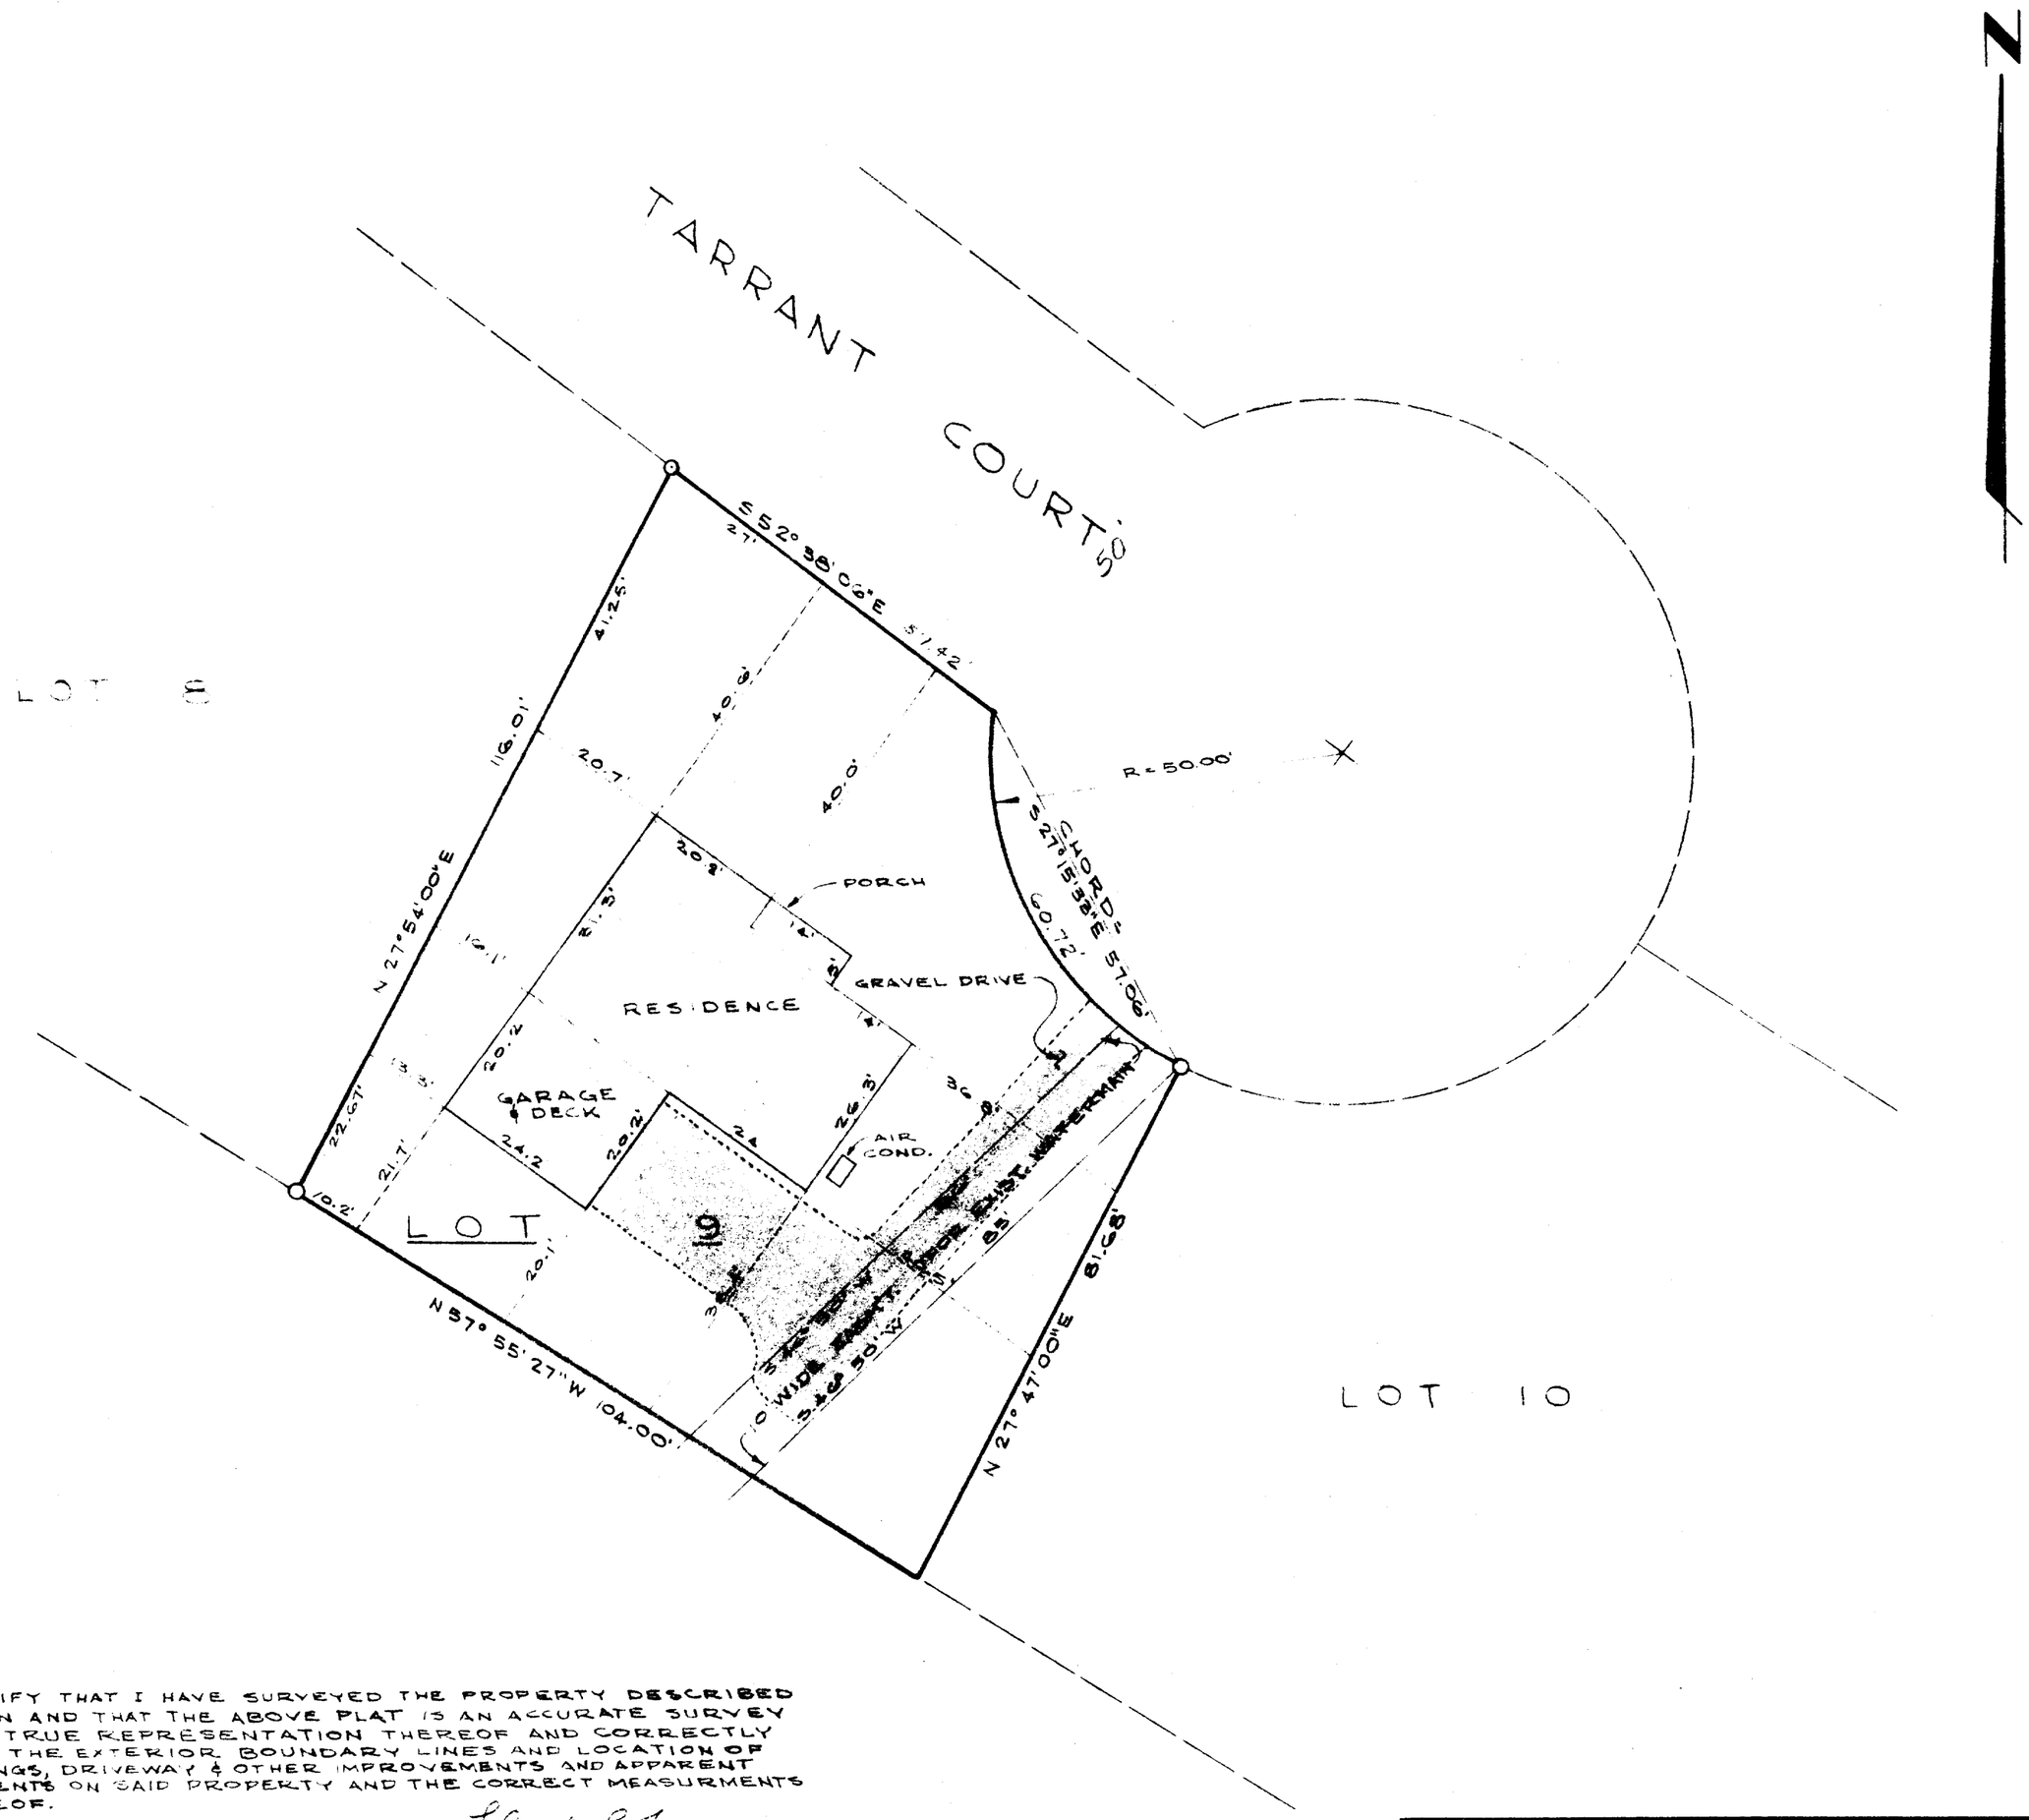

I CERTIFY THAT I HAVE SURVEYED THE PROPERTY DESCRIBED HEREON AND THAT THE ABOVE PLAT IS AN ACCURATE SURVEY AND A TRUE REPRESENTATION THEREOF AND CORRECTLY SHOWS THE EXTERIOR BOUNDARY LINES AND LOCATION OF BUILDINGS, DRIVEWAY & OTHER IMPROVEMENTS AND APPARENT EASEMENTS ON SAID PROPERTY AND THE CORRECT MEASURMENTS THEREOF.

APRIL 6, 1972

Floyd P. Jensen
SURVEYOR

Floyd P. Jensen

PLAT OF SURVEY
OF

LOT 9 OF
COUNTRY CLUB ESTATES, ADDITION "H"
FONTANA-ON-GENEVA LAKE
WALWORTH CO., WISCONSIN

Floyd P. Jensen
SURVEYOR

SCALE 1" = 20'

DATE APRIL 6, 1972

5-223

NO. 175H 300 9-68

SCTH-9

5-213