
ROBERS & FISCHER, INC.
CONSULTING ENGINEERS & LAND SURVEYORS
PHONE (414) 763-2652 116 E. CHESTNUT ST. BURLINGTON, WIS. 53105

PLAT OF SURVEY AND BUILDING LOCATION
OF

Part of Outlot 20, to Assessors Plat # 1, to the Village of Fontana on Geneva Lake, Walworth County, Wisconsin and more particularly described as follows: Commence at the SW corner of said Outlot 20 run thence South 89°36' East along the South line of said Outlot 20 75.62 feet to the point of beginning of the following described parcel, thence continue South 89°36' East along said South line 371.90 feet thence North 0°25' West 234.38 feet to the Southerly right-of-way line of State Trunk Highway 67, thence South 57°56' West along said Southerly right-of-way line 436.76 feet to the point of beginning.

Containing 1.000 acres more or less.

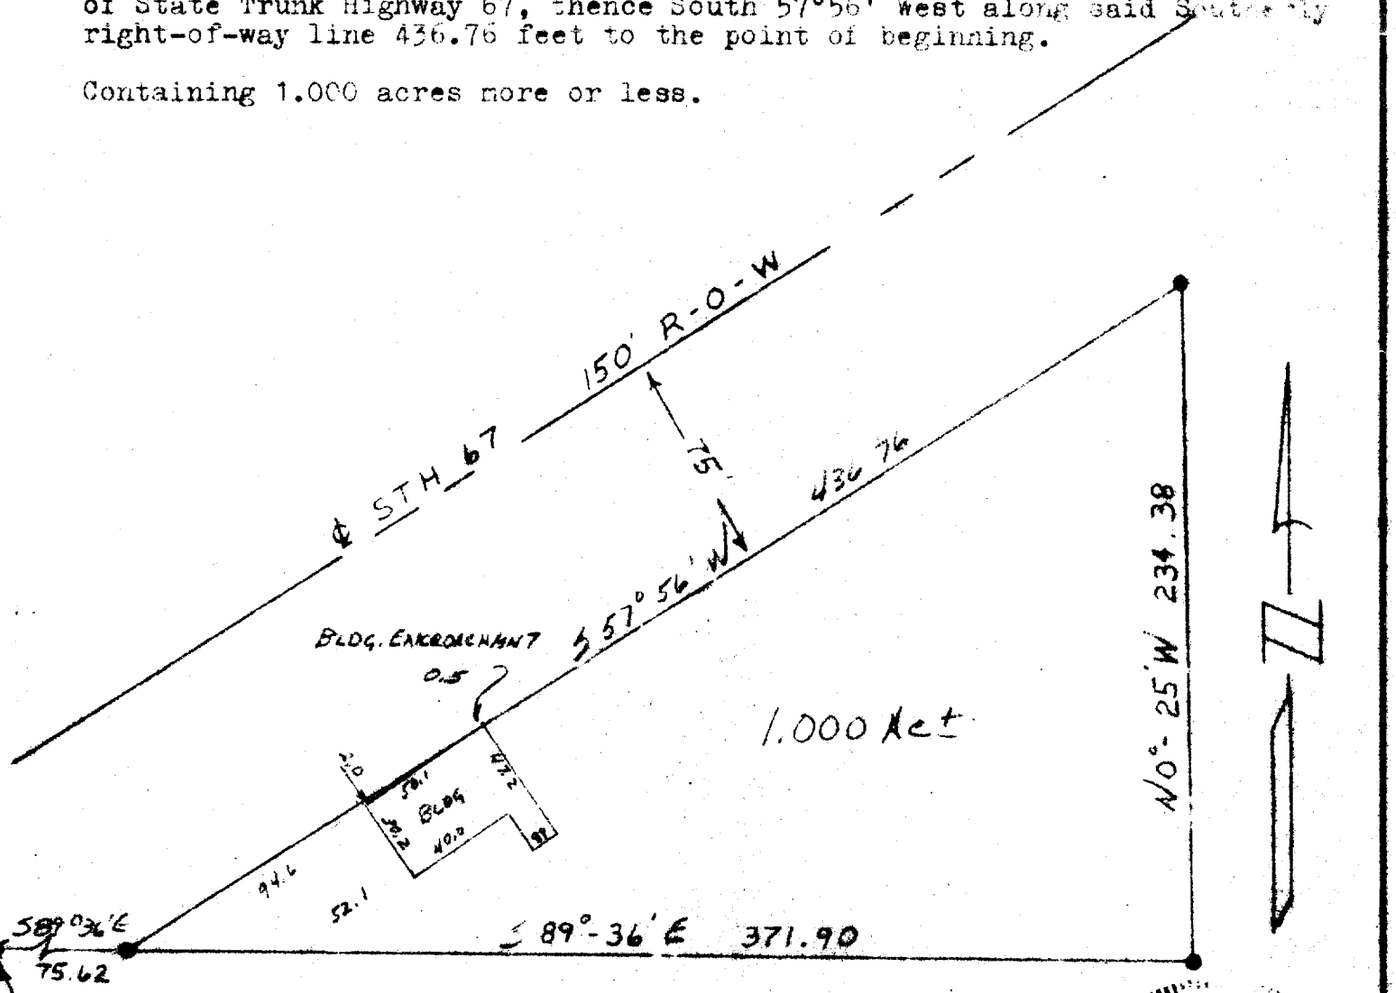

~ LEGEND ~
SCALE 1" = 60'
● - IRON PIPE FOUND
⊠ - CONCRETE MONUMENT

WISCONSIN
BURLINGTON, WIS.
LAND SURVEYOR

I HEREBY CERTIFY THAT WE HAVE SURVEYED THE LANDS DESCRIBED ABOVE ACCORDING TO OFFICIAL RECORDS AND THAT THE PLAT SHOWN HEREON IS A CORRECT REPRESENTATION OF SAID SURVEY.

Jonathan H. Roberts
WIS. REG. LAND SURVEYOR S00787

DATE 1-19-71

JOB NO. 7115b

K & E 10-5155 250-11-70

FV-35

5-228