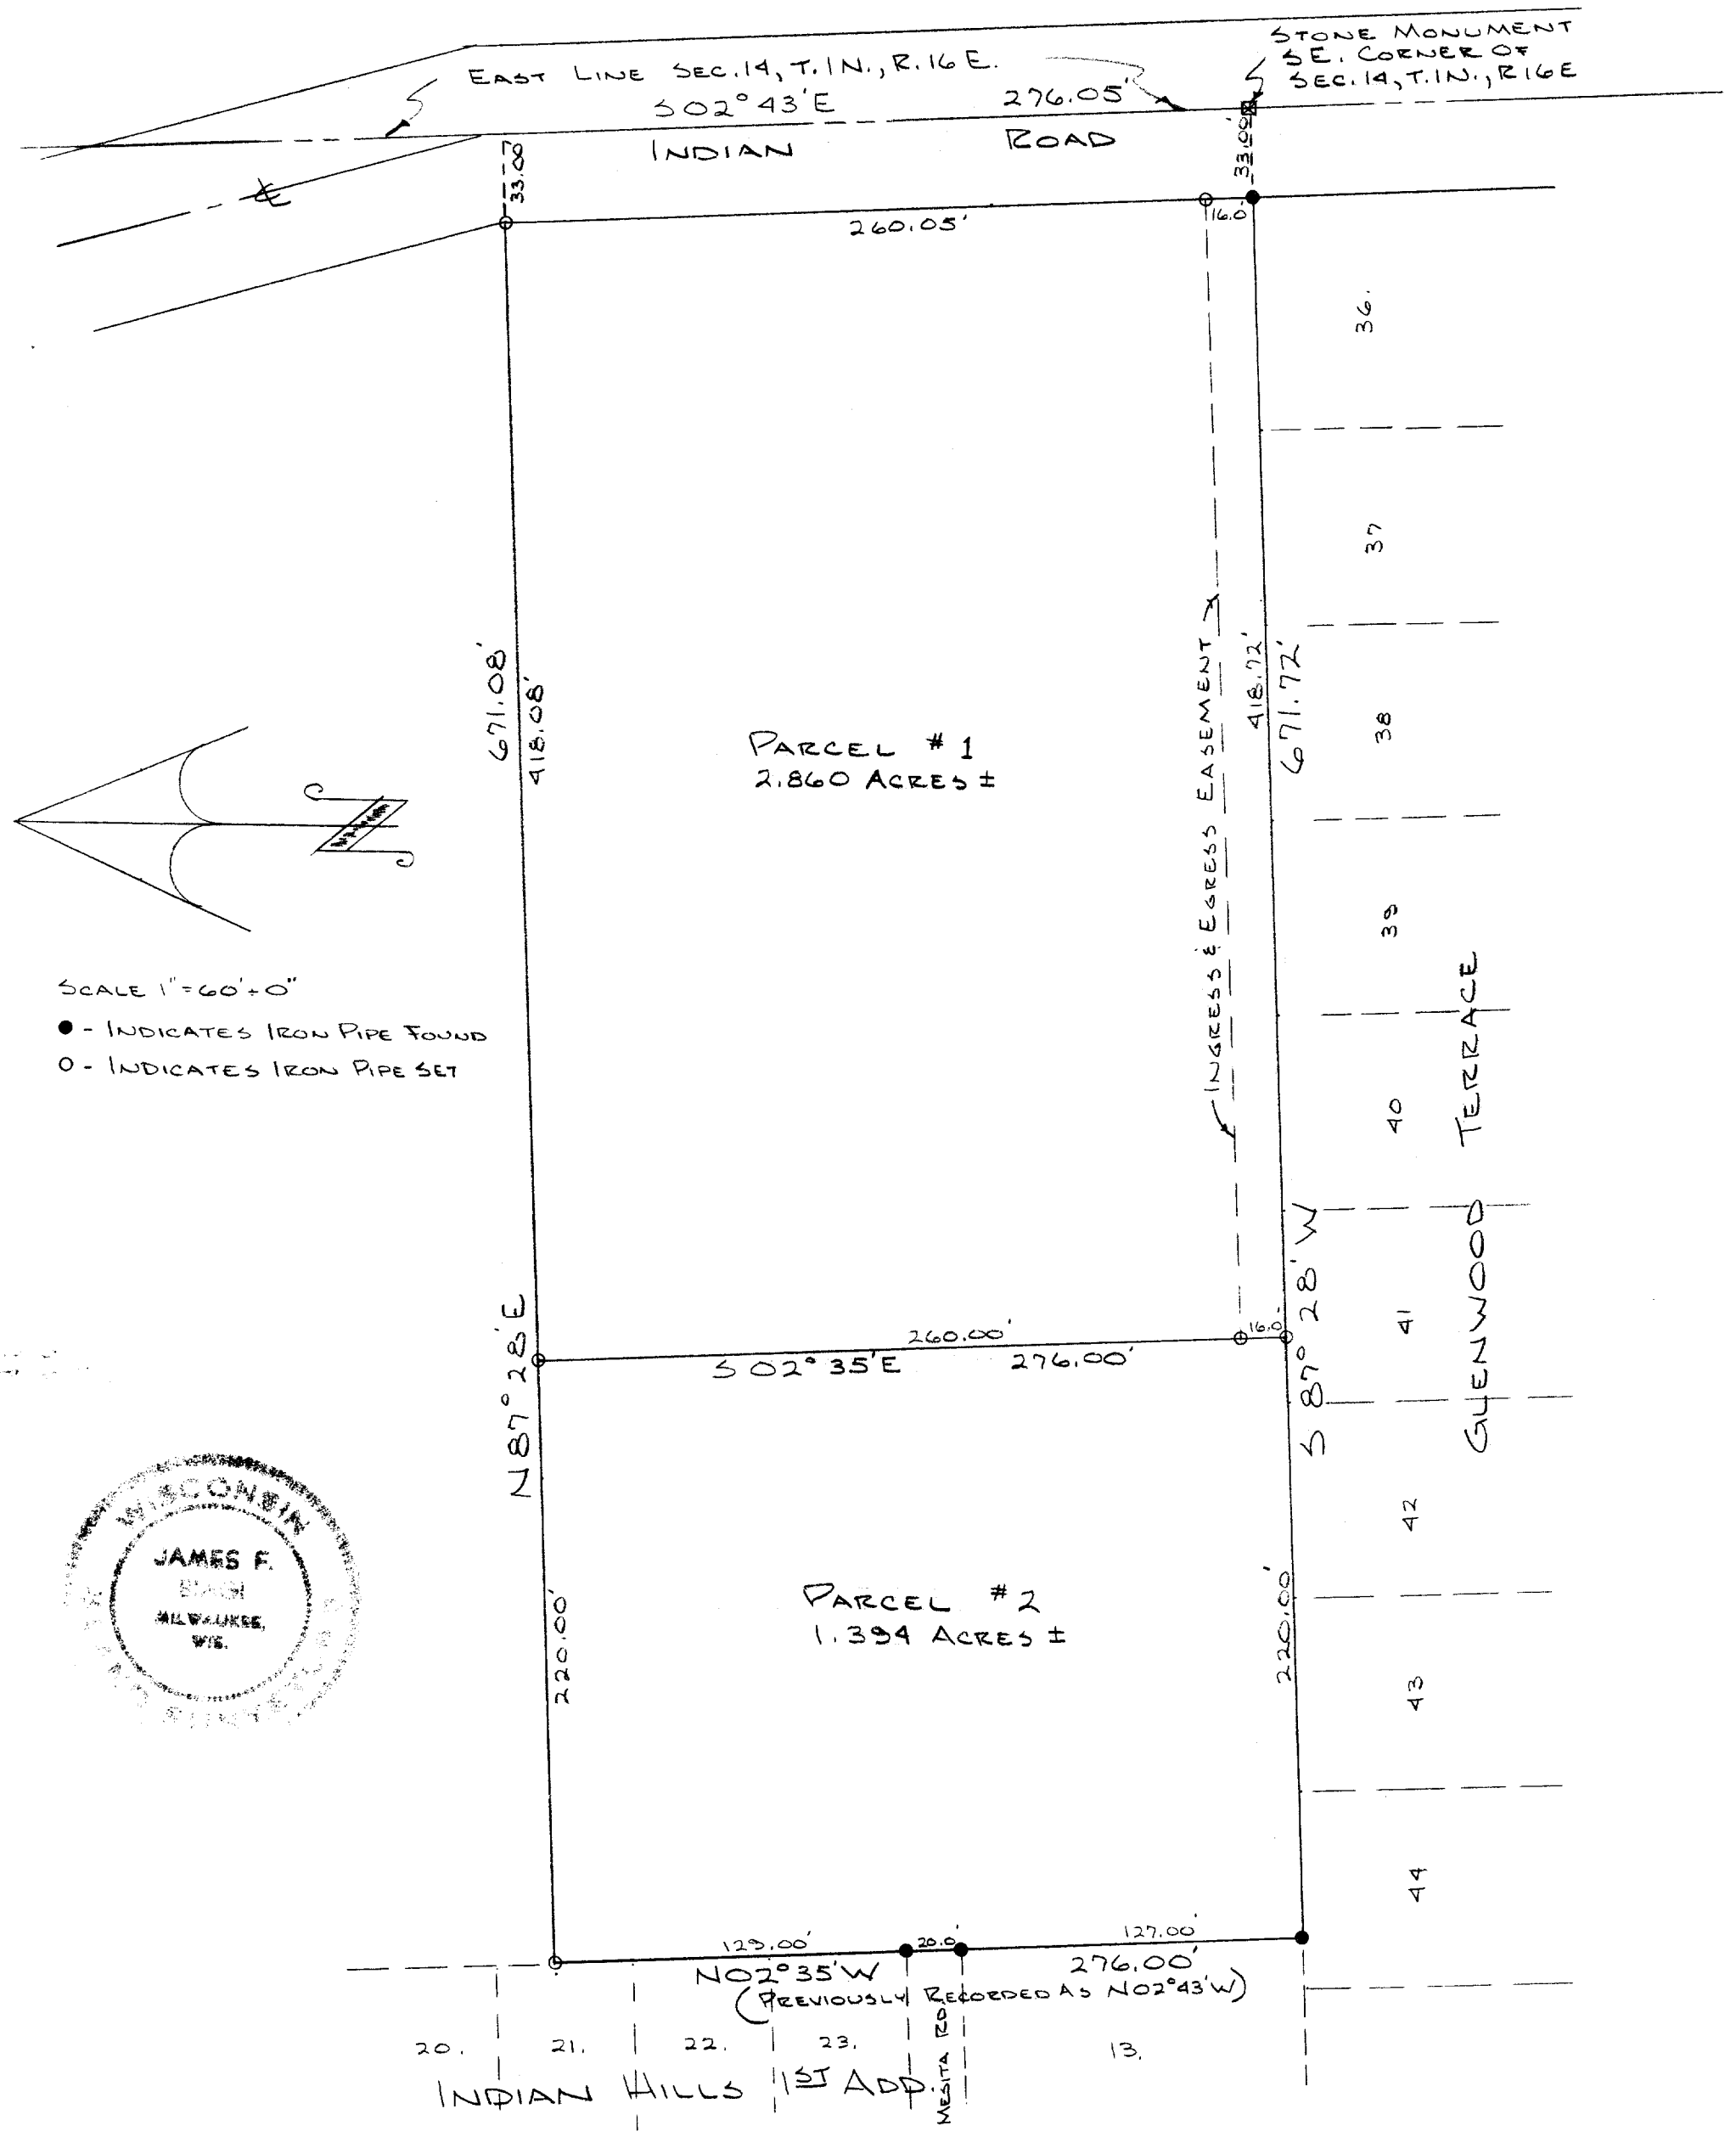



SCALE 1" = 60'-0"

● - INDICATES IRON PIPE FOUND

O - INDICATES IRON PIPE SET

WISCONSIN
JAMES F. BIAGI
MILWAUKEE, WIS.

DESCRIPTION PARCEL #1

Commencing at the Southeast corner of Section 14, Town 1 North, Range 16 East, Walworth County, Wisconsin; thence S87° 28'W 451.72 feet along the North line of Glenwood Terrace Subdivision, thence N02° 35'W 276.00 feet, thence N87° 28'E 451.08 feet to a point on the East line of Section 14, thence S02° 43'E 276.05 feet along said East Section line to the place of beginning containing 2.860 acres of land more or less.

DESCRIPTION PARCEL #2

Commencing at the Southeast corner of Section 14, Town 1 North, Range 16 East, Walworth County, Wisconsin; thence S87°28'W 451.72 feet along the North line of Glenwood Terrace Subdivision, to the place of beginning of the lands hereinafter described to-wit: thence continue S87° 28'W 220.00 feet along said North line of Glenwood Terrace to the SE. corner of Indian Hills First Addition, thence N02° 35'W 276.00 feet (previously recorded as N02° 43'W) along the East line of said Indian Hills First Addition, thence N87° 28'E 220.00 feet , thence S02° 35'E 276.00 feet to the place of beginning containing 1.394 acres of land more or less together with an ingress and egress easement over the South 16.00 feet of Parcel #1.

CERTIFICATE I, James F. Biagi, Surveyor, due hereby certify that I have surveyed the lands here on described,

April 14, 1972

James F. Biagi RLS 272

K+E ALBANENE ® 10 5455 ARCHITECTS' STANDARD FORM

STFV-129

5-22B