
HAROLD H. KOLB

REGISTERED PROFESSIONAL LAND SURVEYOR
LAKE GENEVA, WISCONSIN

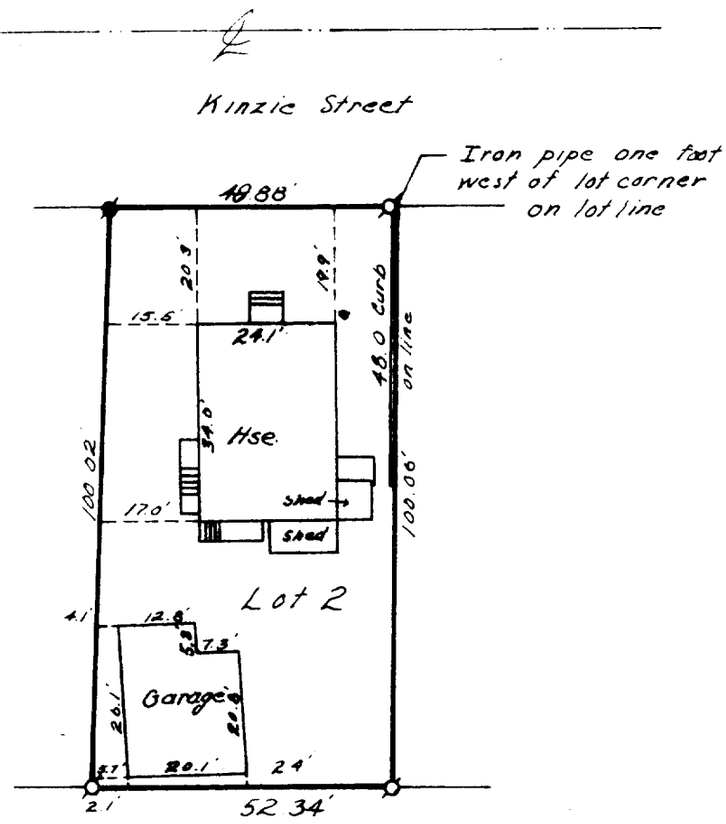

N

Scale = 1"=30'

LEGEND

- ϕ — IRON PIPE FOUND
- O — IRON PIPE PLACED
- ● — CONCRETE MONUMENT
- x — SPIKE

PLAT OF SURVEY OF

Lot 2, Block 4, O.A. Reids Subdivision, T 1 N, R 16 E, Walworth County, Wisconsin.

I. HAROLD H. KOLB, DO HEREBY CERTIFY THAT I HAVE SURVEYED THE PROPERTY HEREON DESCRIBED ACCORDING TO THE OFFICIAL RECORDS, AND THAT THE PLAT HEREON IS A CORRECT REPRESENTATION OF THE LOT LINES.

WISCONSIN HAROLD H. KOLB S-187 LAKE GENEVA, WIS

Harold H. Kolb

HAROLD H. KOLB
WISCONSIN REGISTERED LAND SURVEYOR, S-187
DATE October 24, 1971

SRA-21A

5-232

BRUNING 40 105 1M 8 71