
HAROLD H. KOLB

REGISTERED PROFESSIONAL LAND SURVEYOR
LAKE GENEVA, WISCONSIN

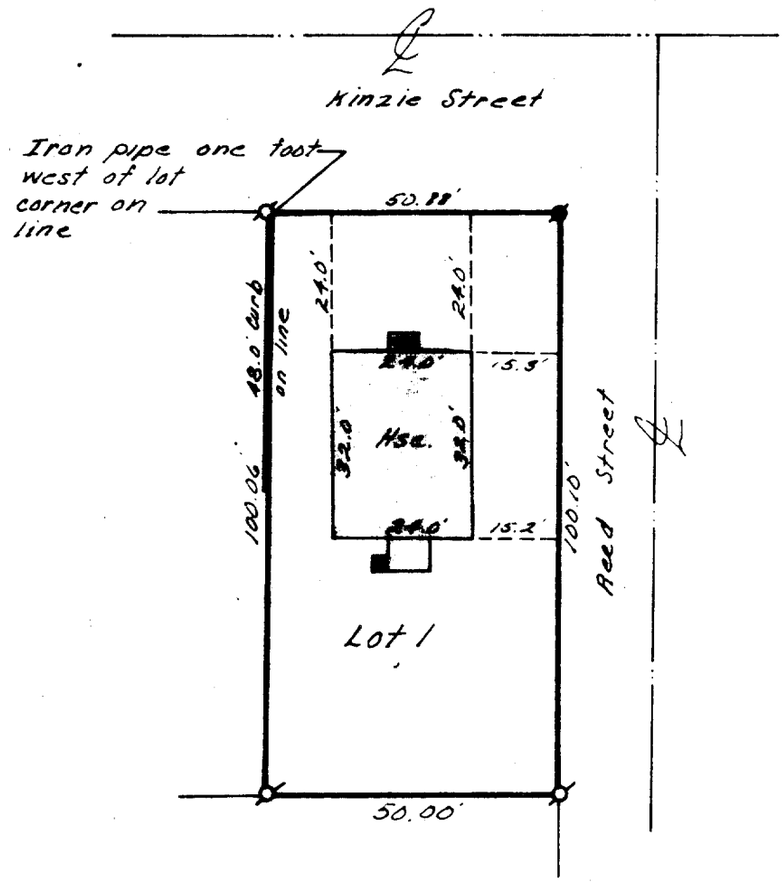

N

Scale : 1" = 30'

PLAT OF SURVEY OF

Lot 1, Block 4, O.A. [illegible] Subdivision, [illegible], Walworth County, Wisconsin

LEGEND

- ϕ — IRON PIPE FOUND
- O — IRON PIPE PLACED
- ● — CONCRETE MONUMENT
- x — SPIKE

CONSIN
HAROLD H. KOLB
S-187
LAKE GENEVA, WIS.

I, HAROLD H. KOLB, DO HEREBY CERTIFY THAT I HAVE SURVEYED THE PROPERTY HEREON DESCRIBED ACCORDING TO THE OFFICIAL RECORDS, AND THAT THE PLAT HEREON IS A CORRECT REPRESENTATION OF THE LOT LINES.

Harold H. Kolb

HAROLD H. KOLB
WISCONSIN REGISTERED LAND SURVEYOR, S-187
DATE October 29, 1971

SRA-21

S-233

BRUNING 40-109 1M-8 71