

1631

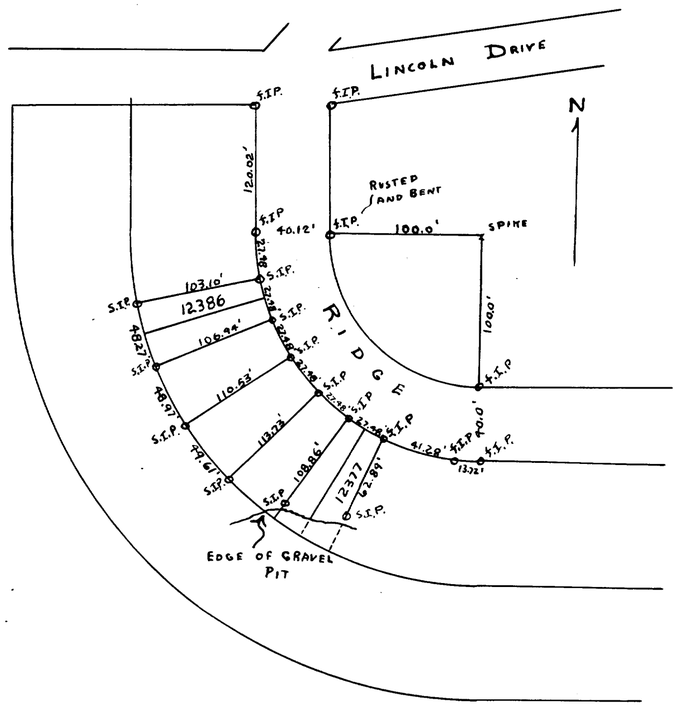

Plat of Survey of Lots 12377 to 12386 of Lake Como Beach Subdivisions, Walworth County, Wisconsin
Nov. 1946

Lloyd L. Jensen
County Surveyor
G.T.D.

1632

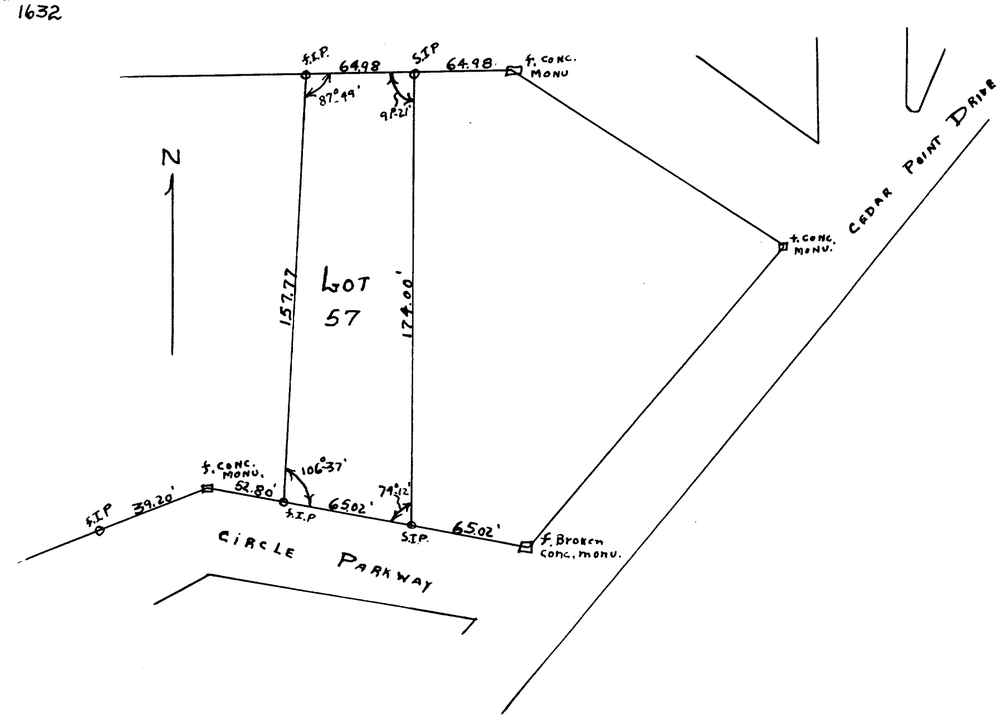


Plat of Survey of Lot 57 Cedar Point Park 3rd addition in the Village of Williams Bay, Walworth County, Wisconsin
Dec. 1946

Lloyd L. Jensen
County Surveyor
G.T.D.

VS Pg 237

HAROLD H. KOLB

REGISTERED PROFESSIONAL LAND SURVEYOR
LAKE GENEVA, WISCONSIN

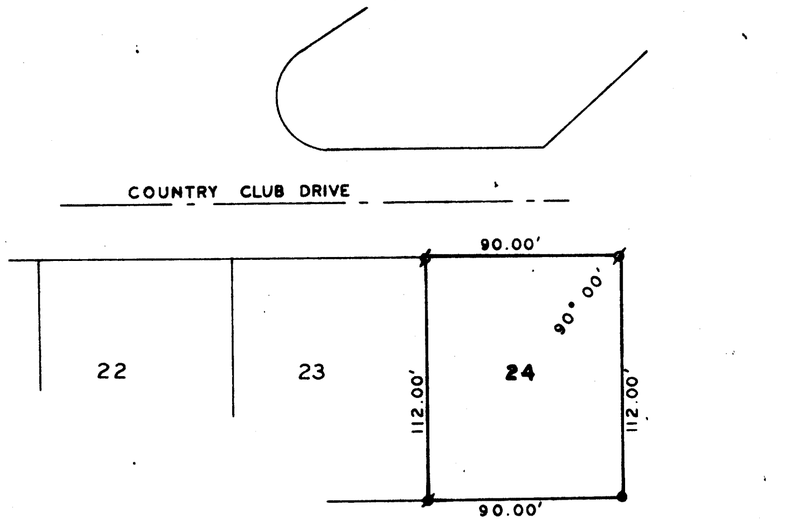

PLAT OF SURVEY OF

Lot 24, Country Club Estates Addition E, Village of Fontana, Walworth County, Wisconsin.

N

SCALE: 1"=50'

LEGEND

- ϕ — IRON PIPE FOUND
- O — IRON PIPE PLACED
- ● — CONCRETE MONUMENT FOUND
- x — SPIKE

I, HAROLD H. KOLB, DO HEREBY CERTIFY THAT I HAVE SURVEYED THE PROPERTY HEREON DESCRIBED ACCORDING TO THE OFFICIAL RECORDS, AND THAT THE PLAT HEREON IS A CORRECT REPRESENTATION OF THE LOT LINES.

WISCONSIN HAROLD H. KOLB S-187 LAKE GENEVA, WIS. LAND SURVEYOR

Harold H. Kolb

HAROLD H. KOLB
WISCONSIN REGISTERED LAND SURVEYOR, S-187
DATE JULY 7, 1972

SCTE-24

5-237