
50-50

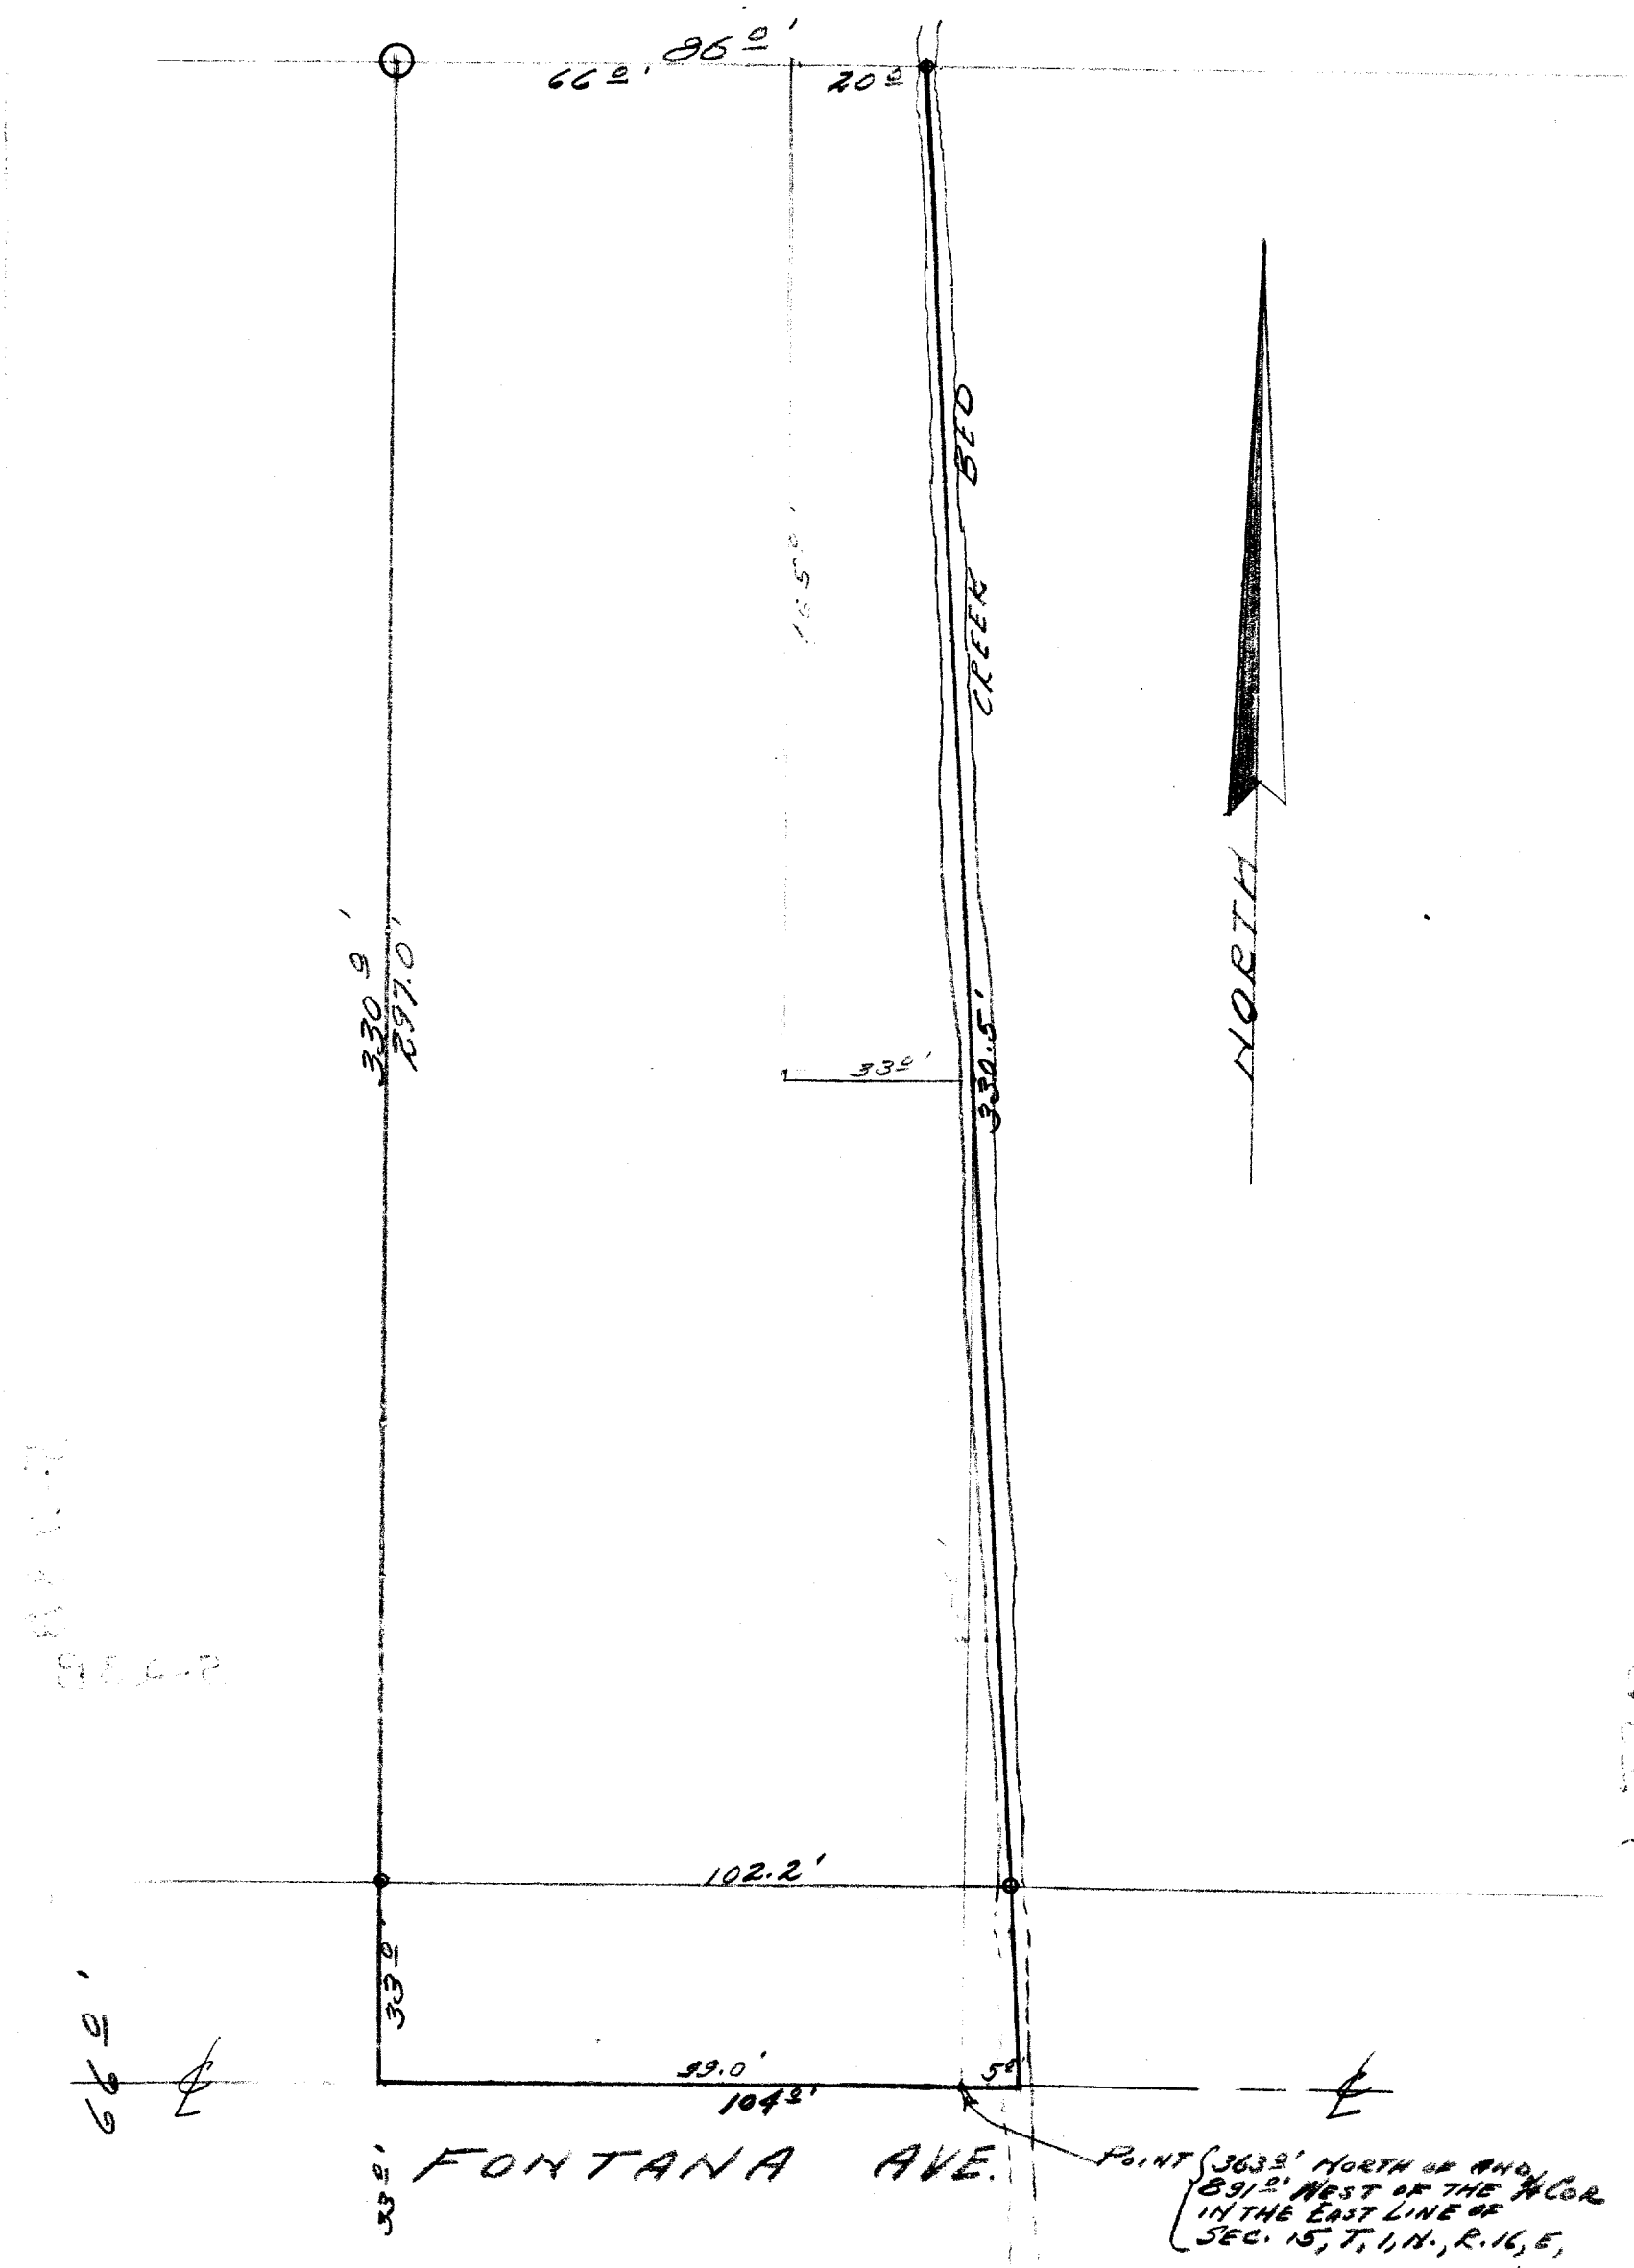

DESCRIPTION:

Commencing at a point in the centerline of Fontana Avenue of the Village of Fontana, Walworth County, Wisconsin, that is 363.0 feet North of and 891.0 feet West of the quarter section corner in the east side of Section 15, Township 1 north, Range 16 east of the 4th Principal Meridian, thence West 99.0 feet to a point, thence North 330.0 feet to a point, thence East 86.0 feet to a point in the center of a creek bed and water course, thence southeasterly to a point in the centerline of Fontana Avenue that is 5.0 feet east of the place of beginning, thence West 5.0 feet to the place of beginning.

CERTIFICATE:

I, hereby, certify that I, have on this the 29th day of August 1950, surveyed the above described property, according to the official records on file in the office of the Recorder of Deeds in and for Walworth County, Wisconsin,and find that the measurements andbearings of the boundary lines of said property as taken at the site on this day substantially agree with those in said official record and that no encroachments exist.

SIGNED AND SEALED ON THIS THE 8TH DAY OF SEPTEMBER 1950.

Joseph M. Biagi. Professional Engineer.
Elkhorn Wisconsin.

STFV 213, 214
STFV= 219, 220

5-23B