PLAT OF SURVEY

LOT 2 OF CERTIFIED SURVEY MAP 3902


RECORDED IN VOL. 24 OF C.S.M.'S ON PG. 1 AS DOC. NO. 668628


LOCATED IN PART OF THE SW 1/4 OF THE NW 1/4 OF SECTION 11,
TOWN 1 NORTH, RANGE 16 EAST, TOWN OF WALWORTH, WALWORTH COUNTY, WISCONSIN

GRID NORTH
WISCONSIN STATE PLANE COORDINATE SYSTEM – SOUTH ZONE

ASSIGNED W. LINE OF THE NW 1/4
SECTION 11-1-16
S 01°55'30" E

LINE	BEARING	DISTANCE
L1	N 01°11'50" E	43.69'

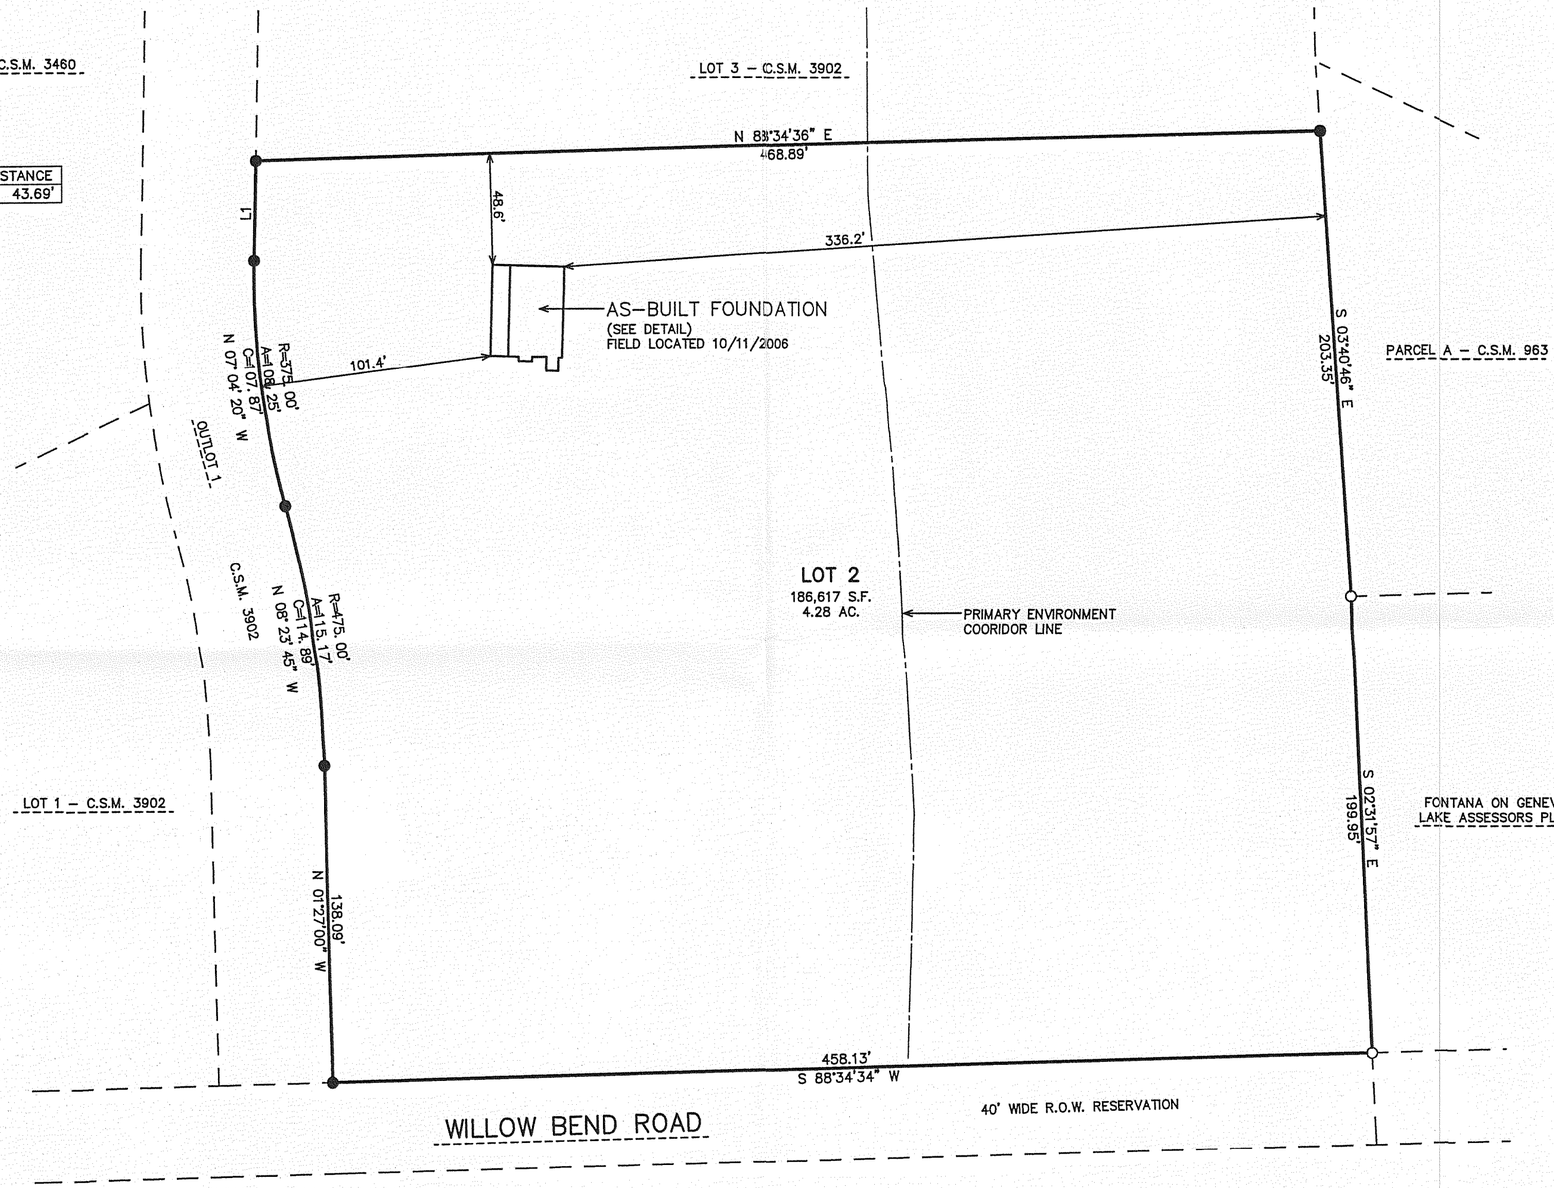

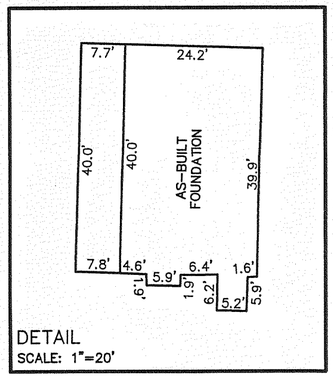

LEGEND
- ○ = FOUND IRON PIPE STAKE
- ● = FOUND IRON REBAR STAKE
- (XXX) = RECORDED AS

100 90 80 70 60 50 40 30 20 10 0 50 100
MAP SCALE IN FEET ORIGINAL 1" = 50'

NOTE: COPIES OF THIS MAP TO WHICH THE FOLLOWING CERTIFICATE WILL APPLY SHOW THE SURVEYOR'S ORIGINAL SEAL AND SIGNATURE IN RED INK. COPIES BY ANY OTHER MEANS MAY HAVE ALTERATIONS WHICH DO NOT REPRESENT THE SURVEYOR'S WORK PRODUCT.

I HEREBY CERTIFY THAT THE ABOVE DESCRIBED PROPERTY HAS BEEN SURVEYED UNDER MY DIRECTION AND THAT THE ABOVE MAP IS A TRUE REPRESENTATION THEREOF AND SHOWS THE SIZE AND LOCATION OF THE PROPERTY AND ITS EXTERIOR BOUNDARIES. THIS SURVEY IS MADE FOR THE USE OF THE PRESENT OWNERS OF THE PROPERTY, AND ALSO THOSE WHO PURCHASE, MORTGAGE, OR GUARANTEE THE TITLE THERETO WITHIN ONE YEAR FROM THE DATE HEREOF.

DATED: MAY 23, 2006

PETER S. GORDON R.L.S. 2101

WISCONSIN PETER S. GORDON S-2101 ELKHORN, WI LAND SURVEYOR

RECEIVED NOV 14 2006

– WORK ORDERED BY –
CRAIG WORKMAN
FONTANA HOLDING CO.
FONTANA, WI 53125

FARRIS, HANSEN & ASSOCIATES, INC.
ENGINEERING – ARCHITECTURE – SURVEYING
7 RIDGWAY COURT P.O. BOX 437
ELKHORN, WISCONSIN 53121
OFFICE: (262) 723-2098 FAX: (262) 723-5886

REVISIONS
10/13/2006– TO SHOW SIZE AND LOCATION OF AS–BUILT FOUNDATION

PROJECT NO. 5269.05
DATE: 05/23/06
SHEET NO. 1 OF 1

10/12/2006 X:\Projects\5269\DCAD\ASBLT_LOT2

SA3902-2

005-2425