
PREPARED FOR:
CONSTANTINE AVDALAS
BROADWAY BANK
5960 N. BROADWAY
CHICAGO, IL 60660

PLAT OF SURVEY

-OF-


LOT 2, BLOCK 4, D.A. REID'S ADDITION TO REID'S PARK
LOCATED IN THE VILLAGE OF FONTANA-ON-GENEVA LAKE,
WALWORTH COUNTY, WISCONSIN.

KROTT SURVEYING INC.
N3705 WILLOW BEND LANE
LAKE GENEVA WI. 53147
PHONE # (262)248-3697
FAX # (262)249-0639

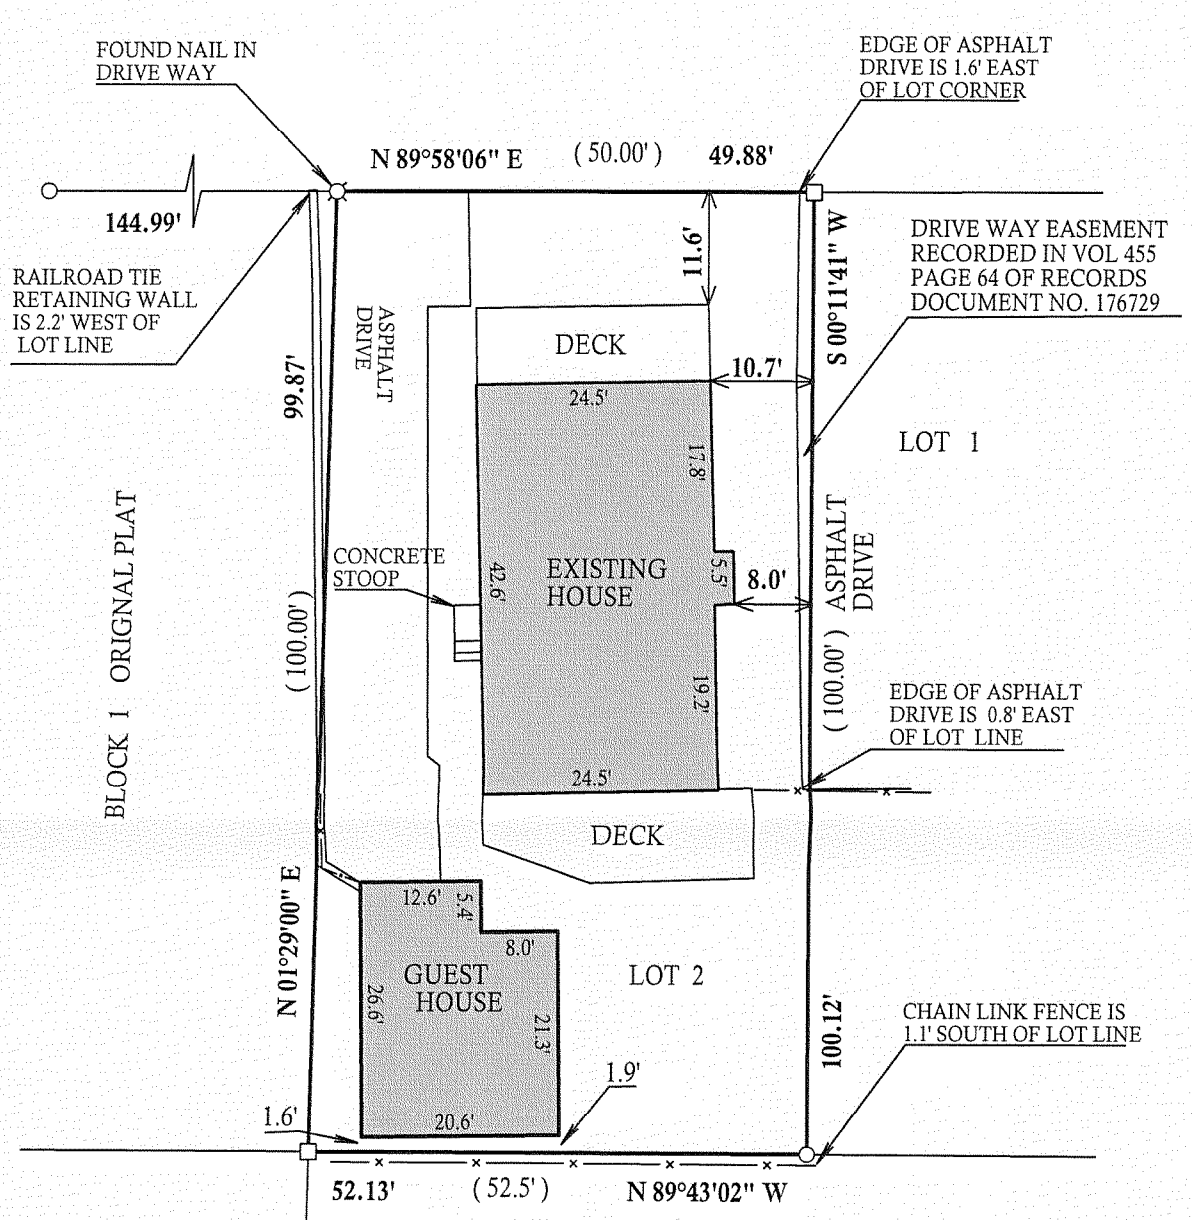


LEGEND

- ○ FOUND IRON PIPE
- □ FOUND IRON BAR
- ⓤ UTILITY PEDISTALS
- (XX) RECORDED AS
- —×— FENCE

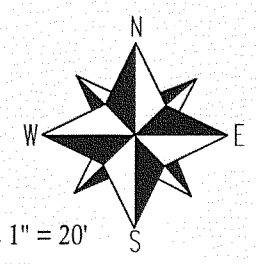

SCALE 1" = 20'

RECEIVED
APR 18 2008

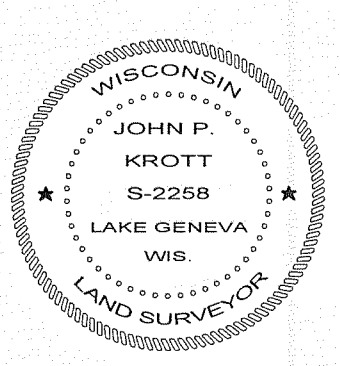

COMPARE LEGAL DESCRIPTION ABOVE AND DRAWING WITH DEED. FOR BUILDING RESTRICTIONS AND EASEMENTS NOT SHOWN,REFER TO DEED, ABSTRACT SOURCES AND LOCAL MUNICIPAL CODES. NOTIFY THE SURVEYOR IMMEDIATELY OF ANY DISCREPANCY.

"I hereby certify that I have surveyed the above described property and that the above map is a true representation thereof and shows the size and location of all visible structures, apparent easements and encroachments if any."

This survey is made for the present owners of the property, and those who purchase, mortgage, or guarentee the title thereto, within one year from the date hereof.

DATED THIS 1st, DAY OF APRIL, 2008

JOHN KROTT S - 2258
Wisconsin Registered Land Surveyor
(original if signed in red)

JOB # 08-064

TAX ID # SRA00021A

005-2568