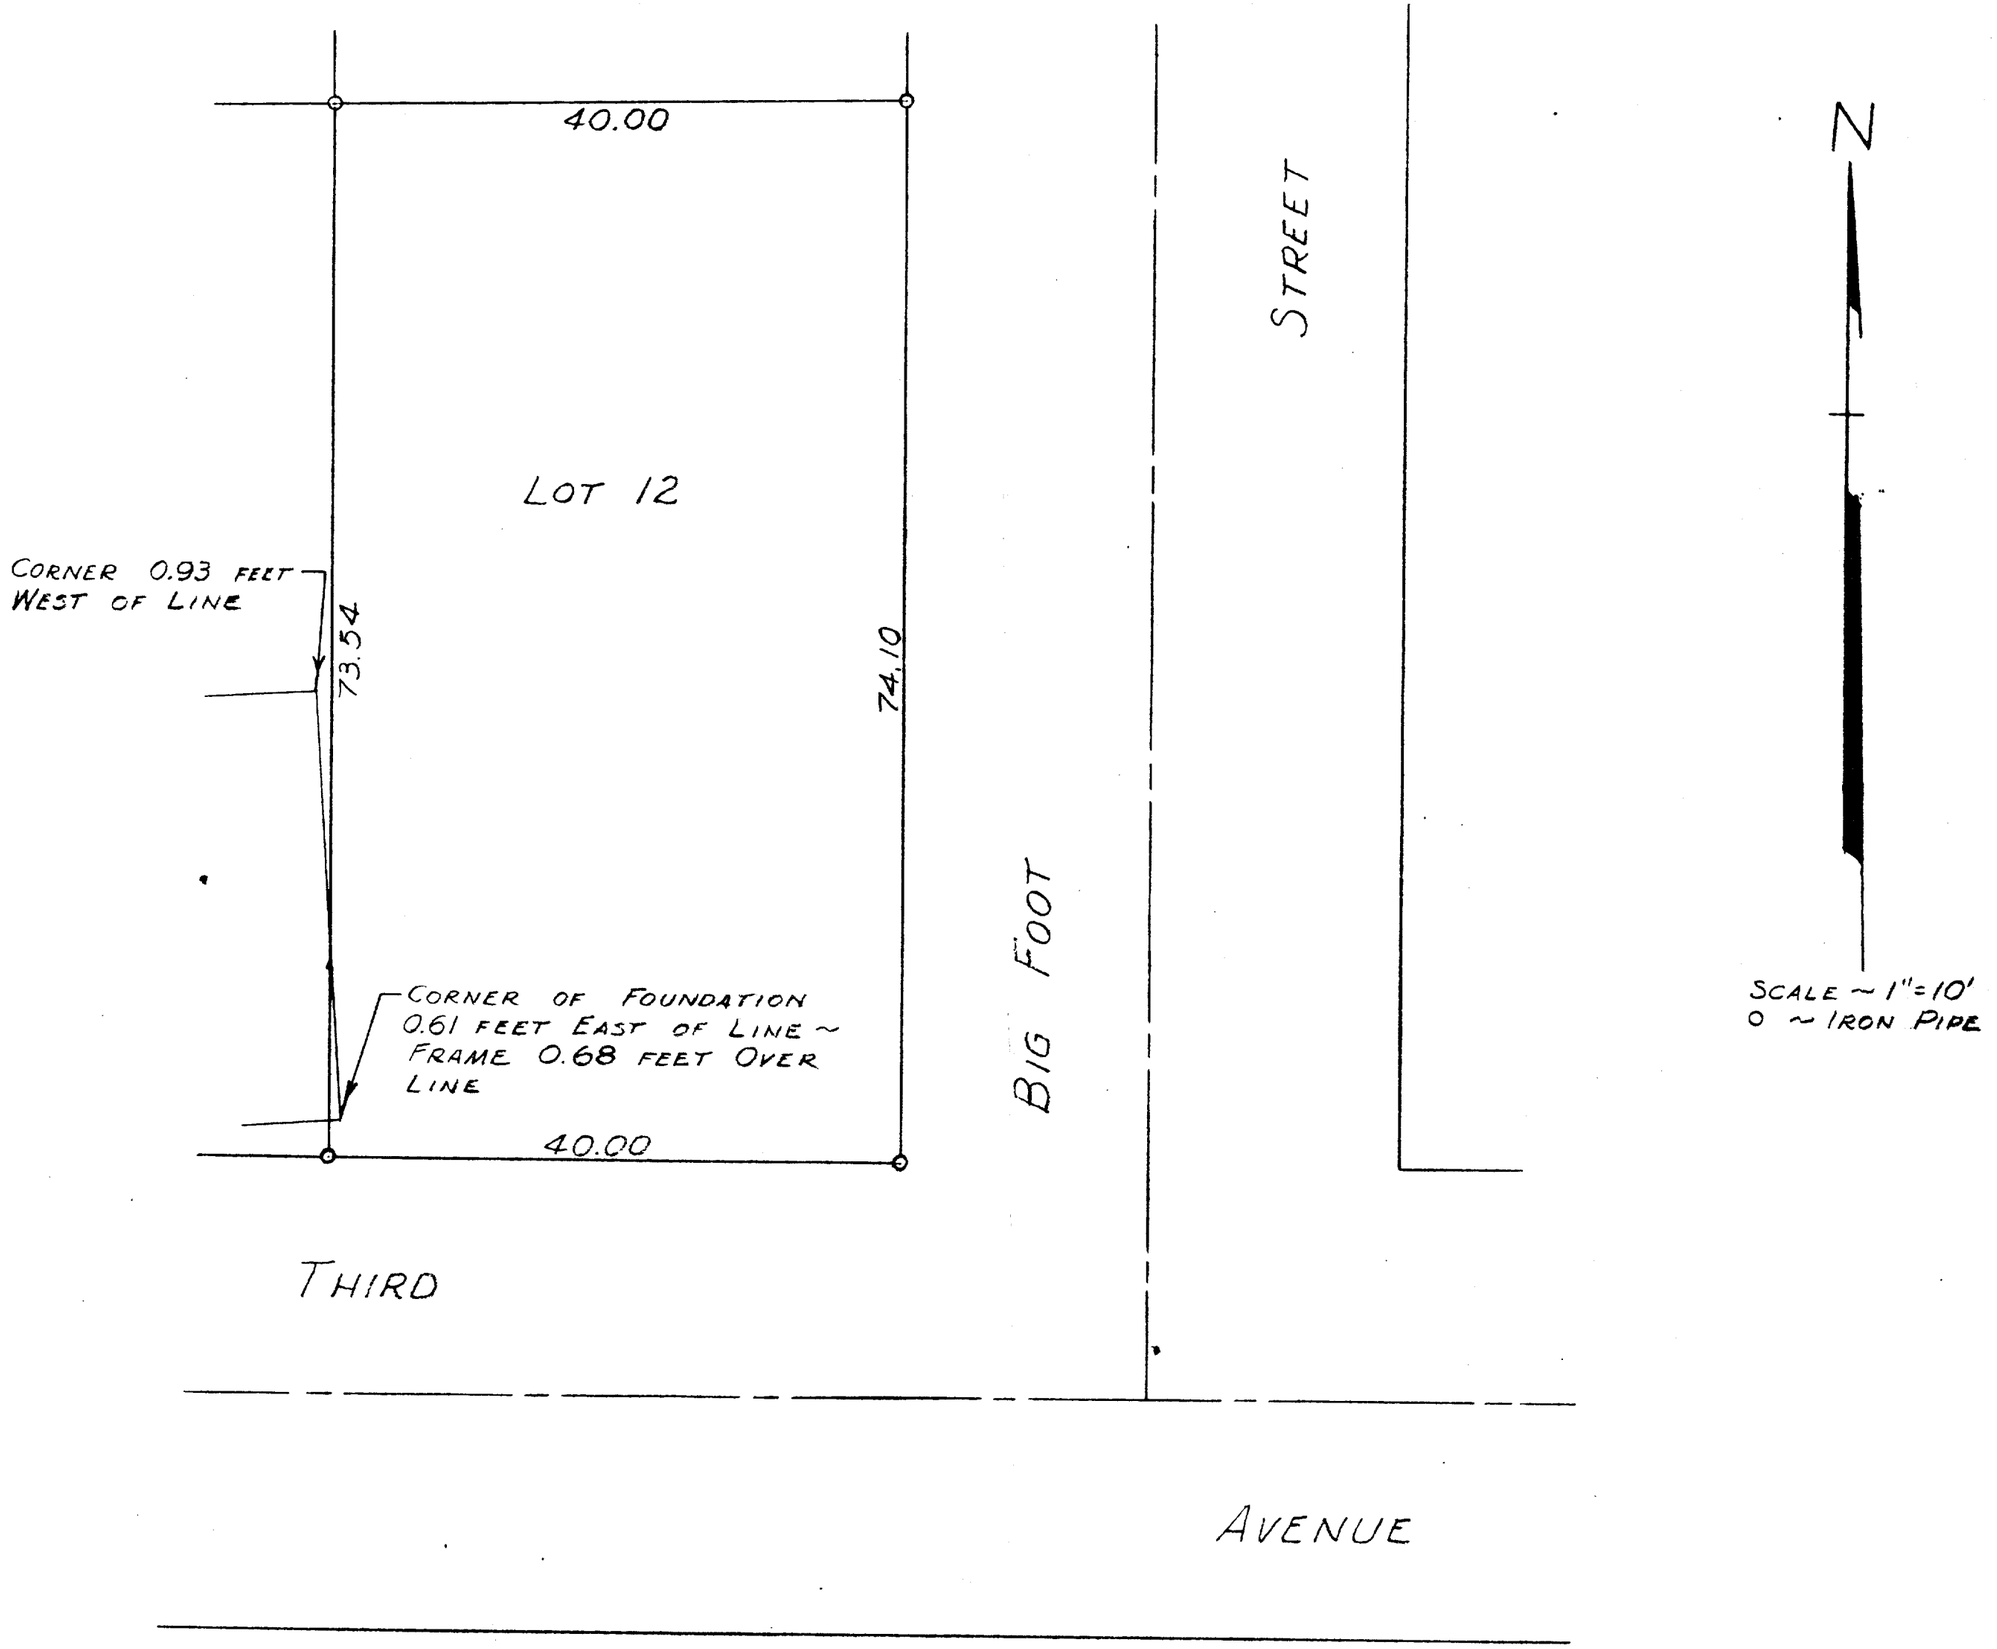


PLAT OF SURVEY OF LOT 12, BLOCK 5 OF D.A. REID'S ADDITION TO REID'S PARK, A SUBDIVISION LOCATED IN THE VILLAGE OF FONTANA, WALWORTH COUNTY, WISCONSIN.
AUGUST 13, 1958

George F. Dunham

GEORGE F. DUNHAM, SURVEYOR
DELAVAN, WISCONSIN.

5-28

SRA-37