


THIRD AVENUE

## RIPARIAN RIGHTS SURVEY

-OF-

LOT 3 OF REID'S PARK SUBDIVISION, LOCATED IN THE VILLAGE OF FONTANA  
WALWORTH COUNTY, WISCONSIN.

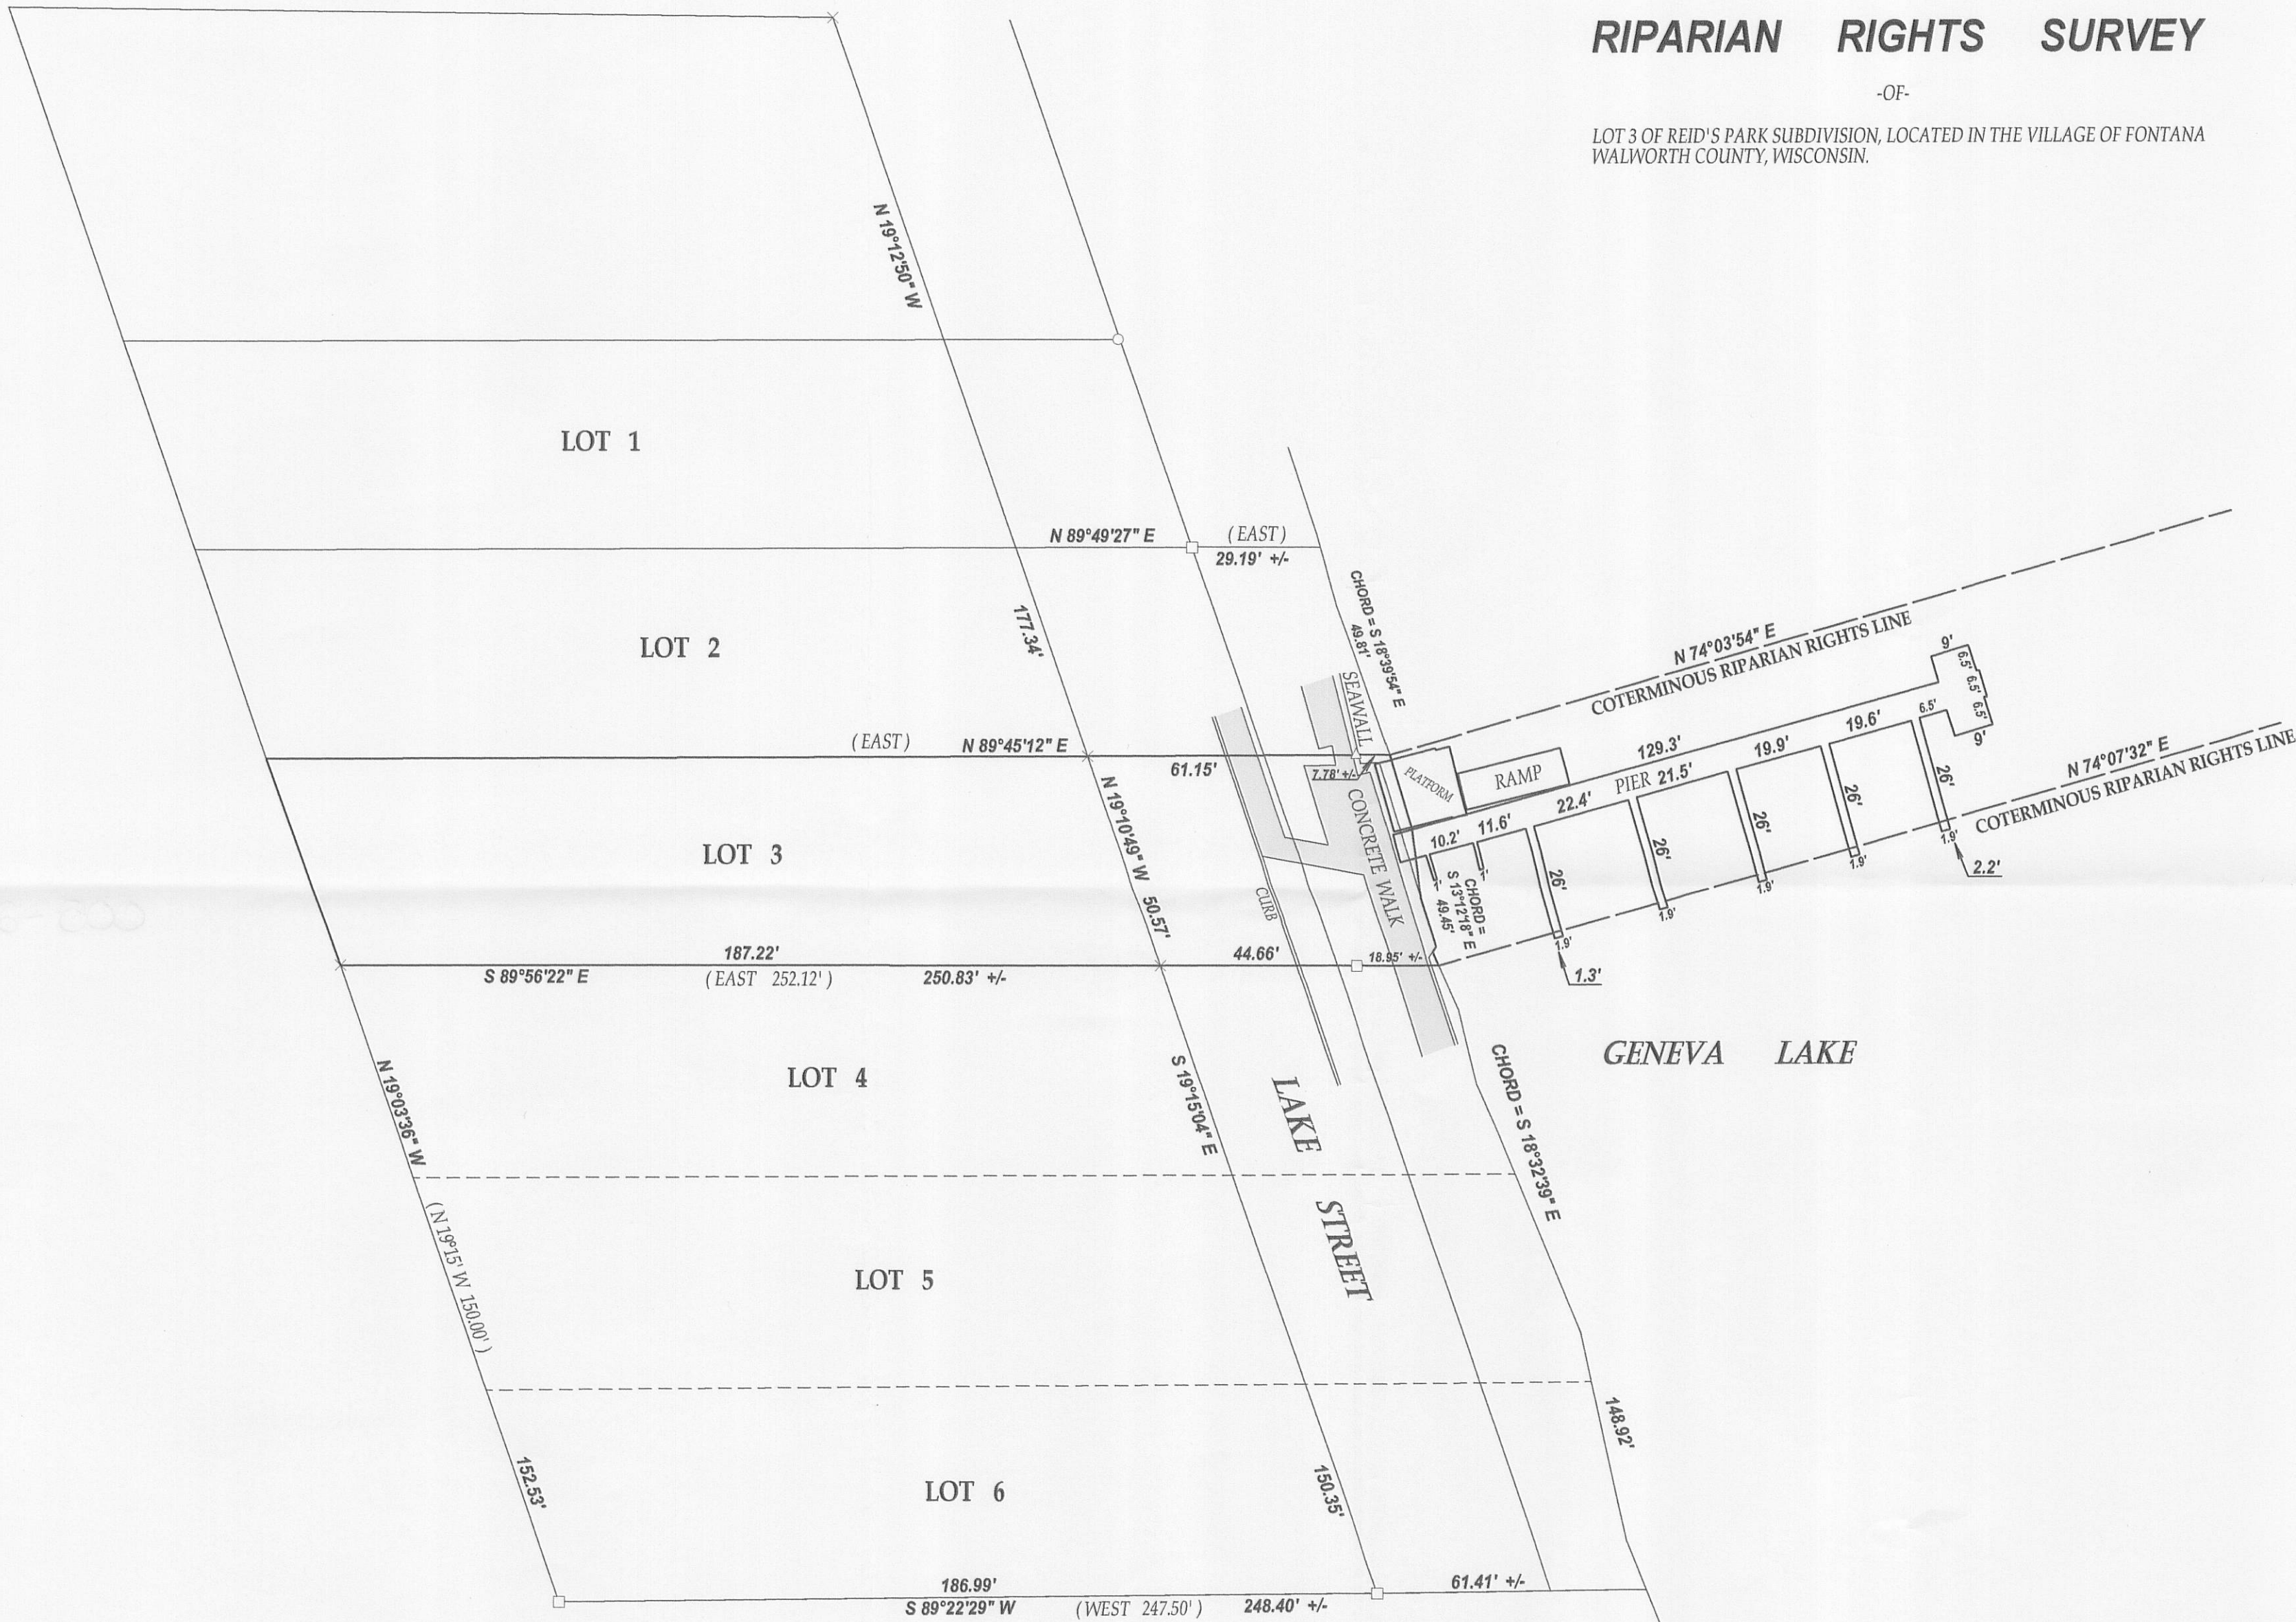


### LEGEND

- FOUND IRON PIPE
- FOUND IRON BAR
- × FOUND CUT CROSS
- △ FOUND MASONARY NAIL




(XX) RECORDED AS

TAX ID # SR00003

JOB # 11-136

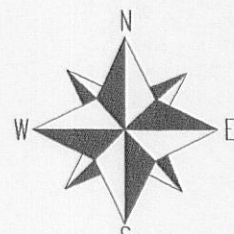

SCALE 1"=30'

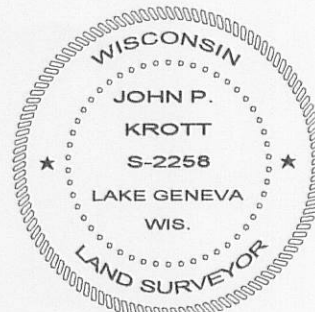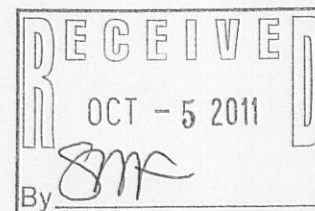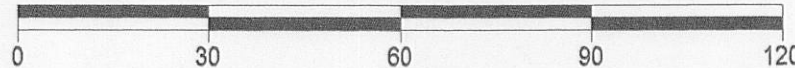

DATED THIS 20th DAY OF SEPTEMBER 2011.

*John P. Krott*

JOHN KROTT S - 2258  
Wisconsin Registered Land Surveyor  
(original if signed in red)

005-2856