
PREPARED FOR
AUSTIN PIER SERVICE INC.
N 1398 US. HIGHWAY 14
WALWORTH, WI. 53184

KROTT SURVEYING INC.
N3705 WILLOW BEND LANE
LAKE GENEVA WI. 53147
PHONE # (262)248-3697
FAX # (262)249-0639

# RIPARIAN RIGHTS SURVEY

-OF-

LOT 3 OF REID'S PARK SUBDIVISION, LOCATED IN THE VILLAGE OF FONTANA
WALWORTH COUNTY, WISCONSIN.

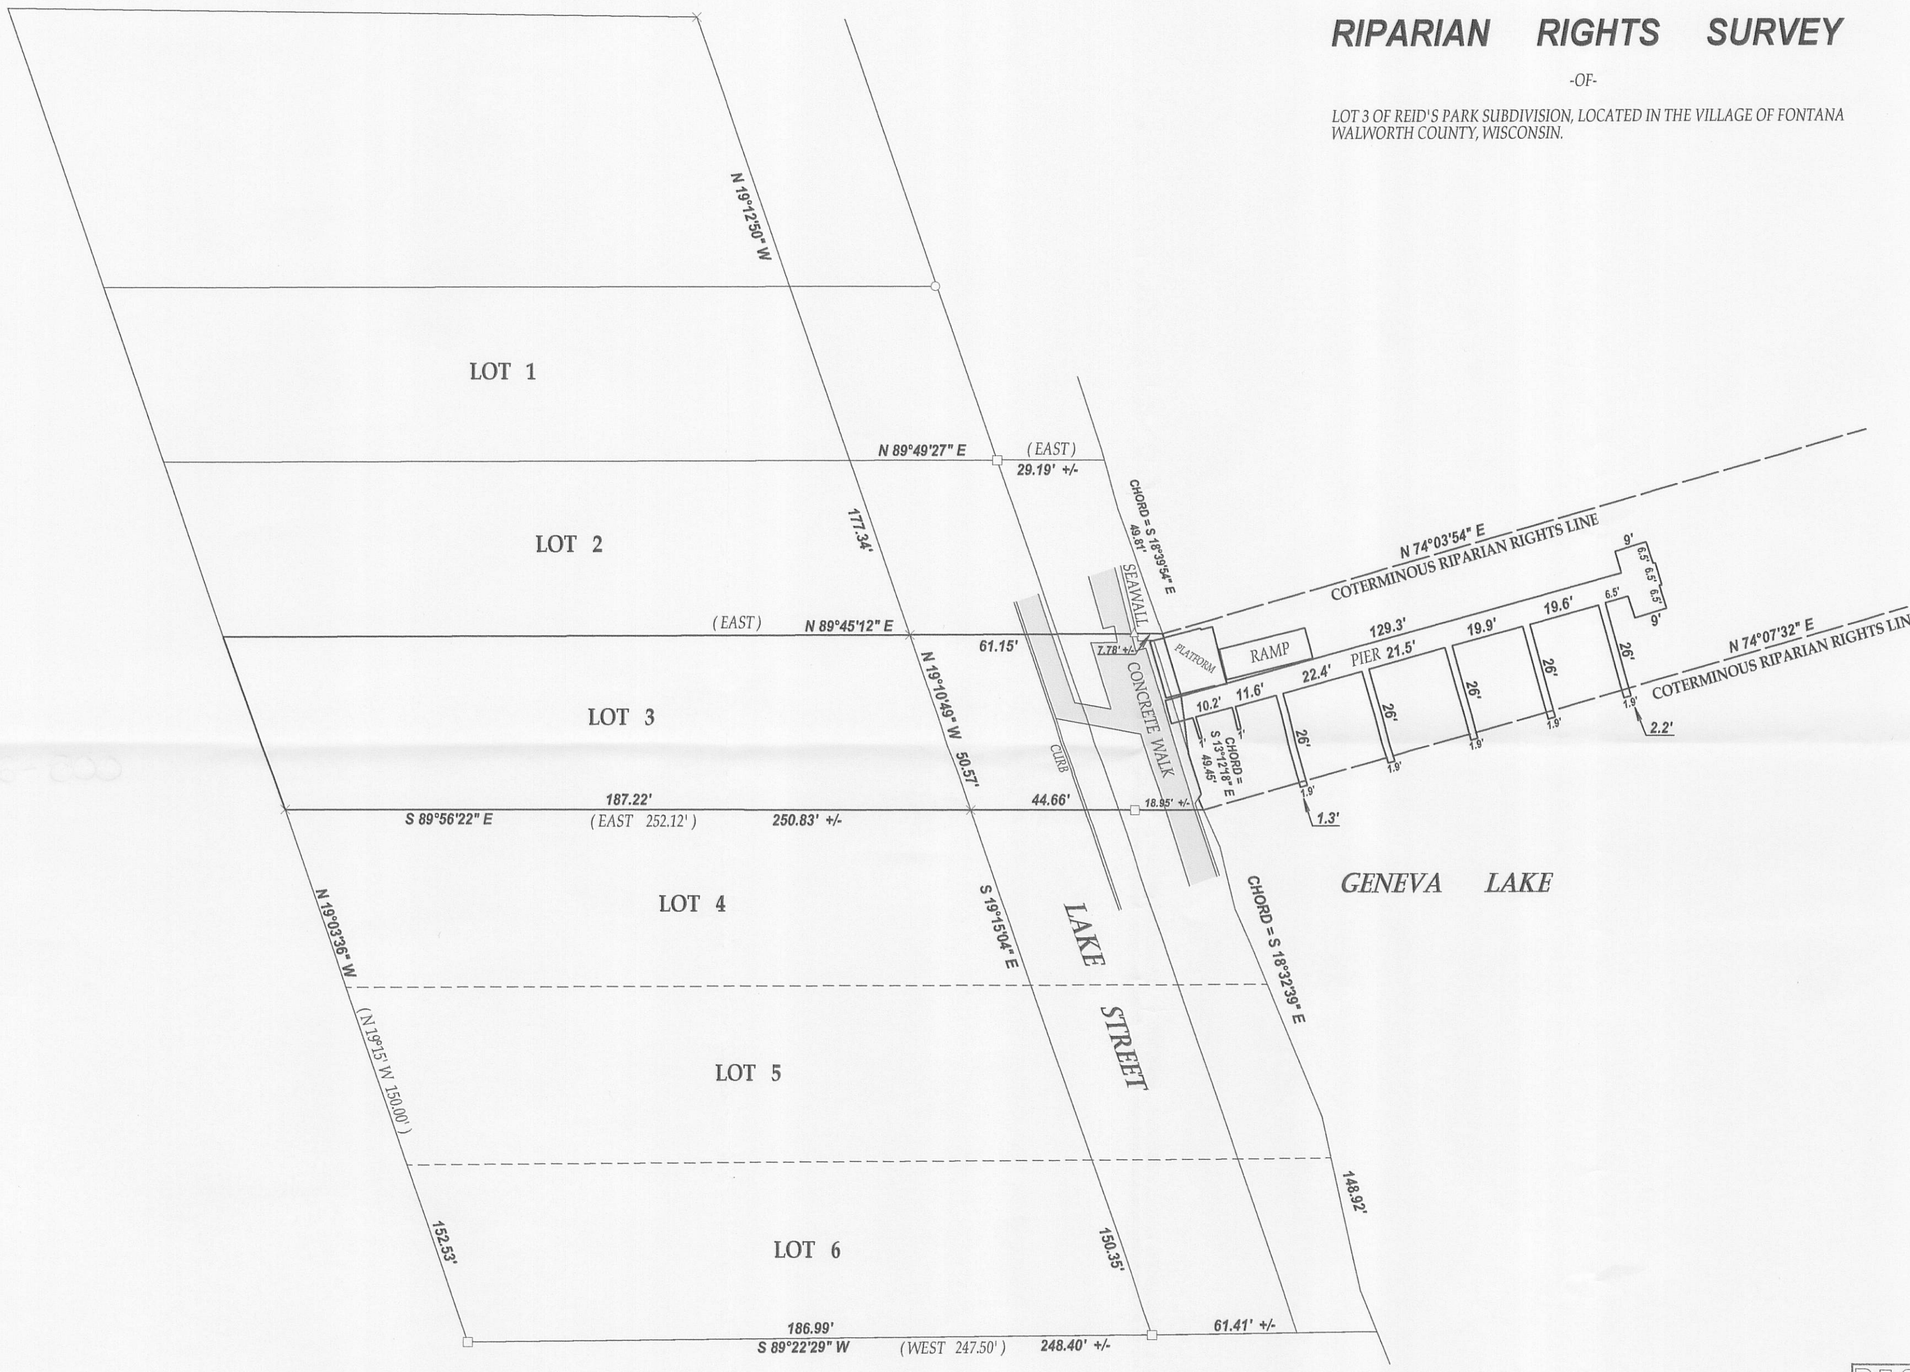


LEGEND

- ○ FOUND IRON PIPE
- □ FOUND IRON BAR
- × FOUND CUT CROSS
- △ FOUND MASONARY NAIL
- (xx) RECORDED AS

TAX ID # SR00003
JOB # 11-136

N
W E
S

SCALE 1"=30'

0 30 60 90 120

RECEIVED
OCT - 5 2011
By

WISCONSIN
JOHN P.
KROTT
S-2258
LAKE GENEVA
WIS.
LAND SURVEYOR

DATED THIS 20th DAY OF SEPTEMBER 2011.

JOHN KROTT S - 2258
Wisconsin Registered Land Surveyor
( original if signed in red )

005-2856