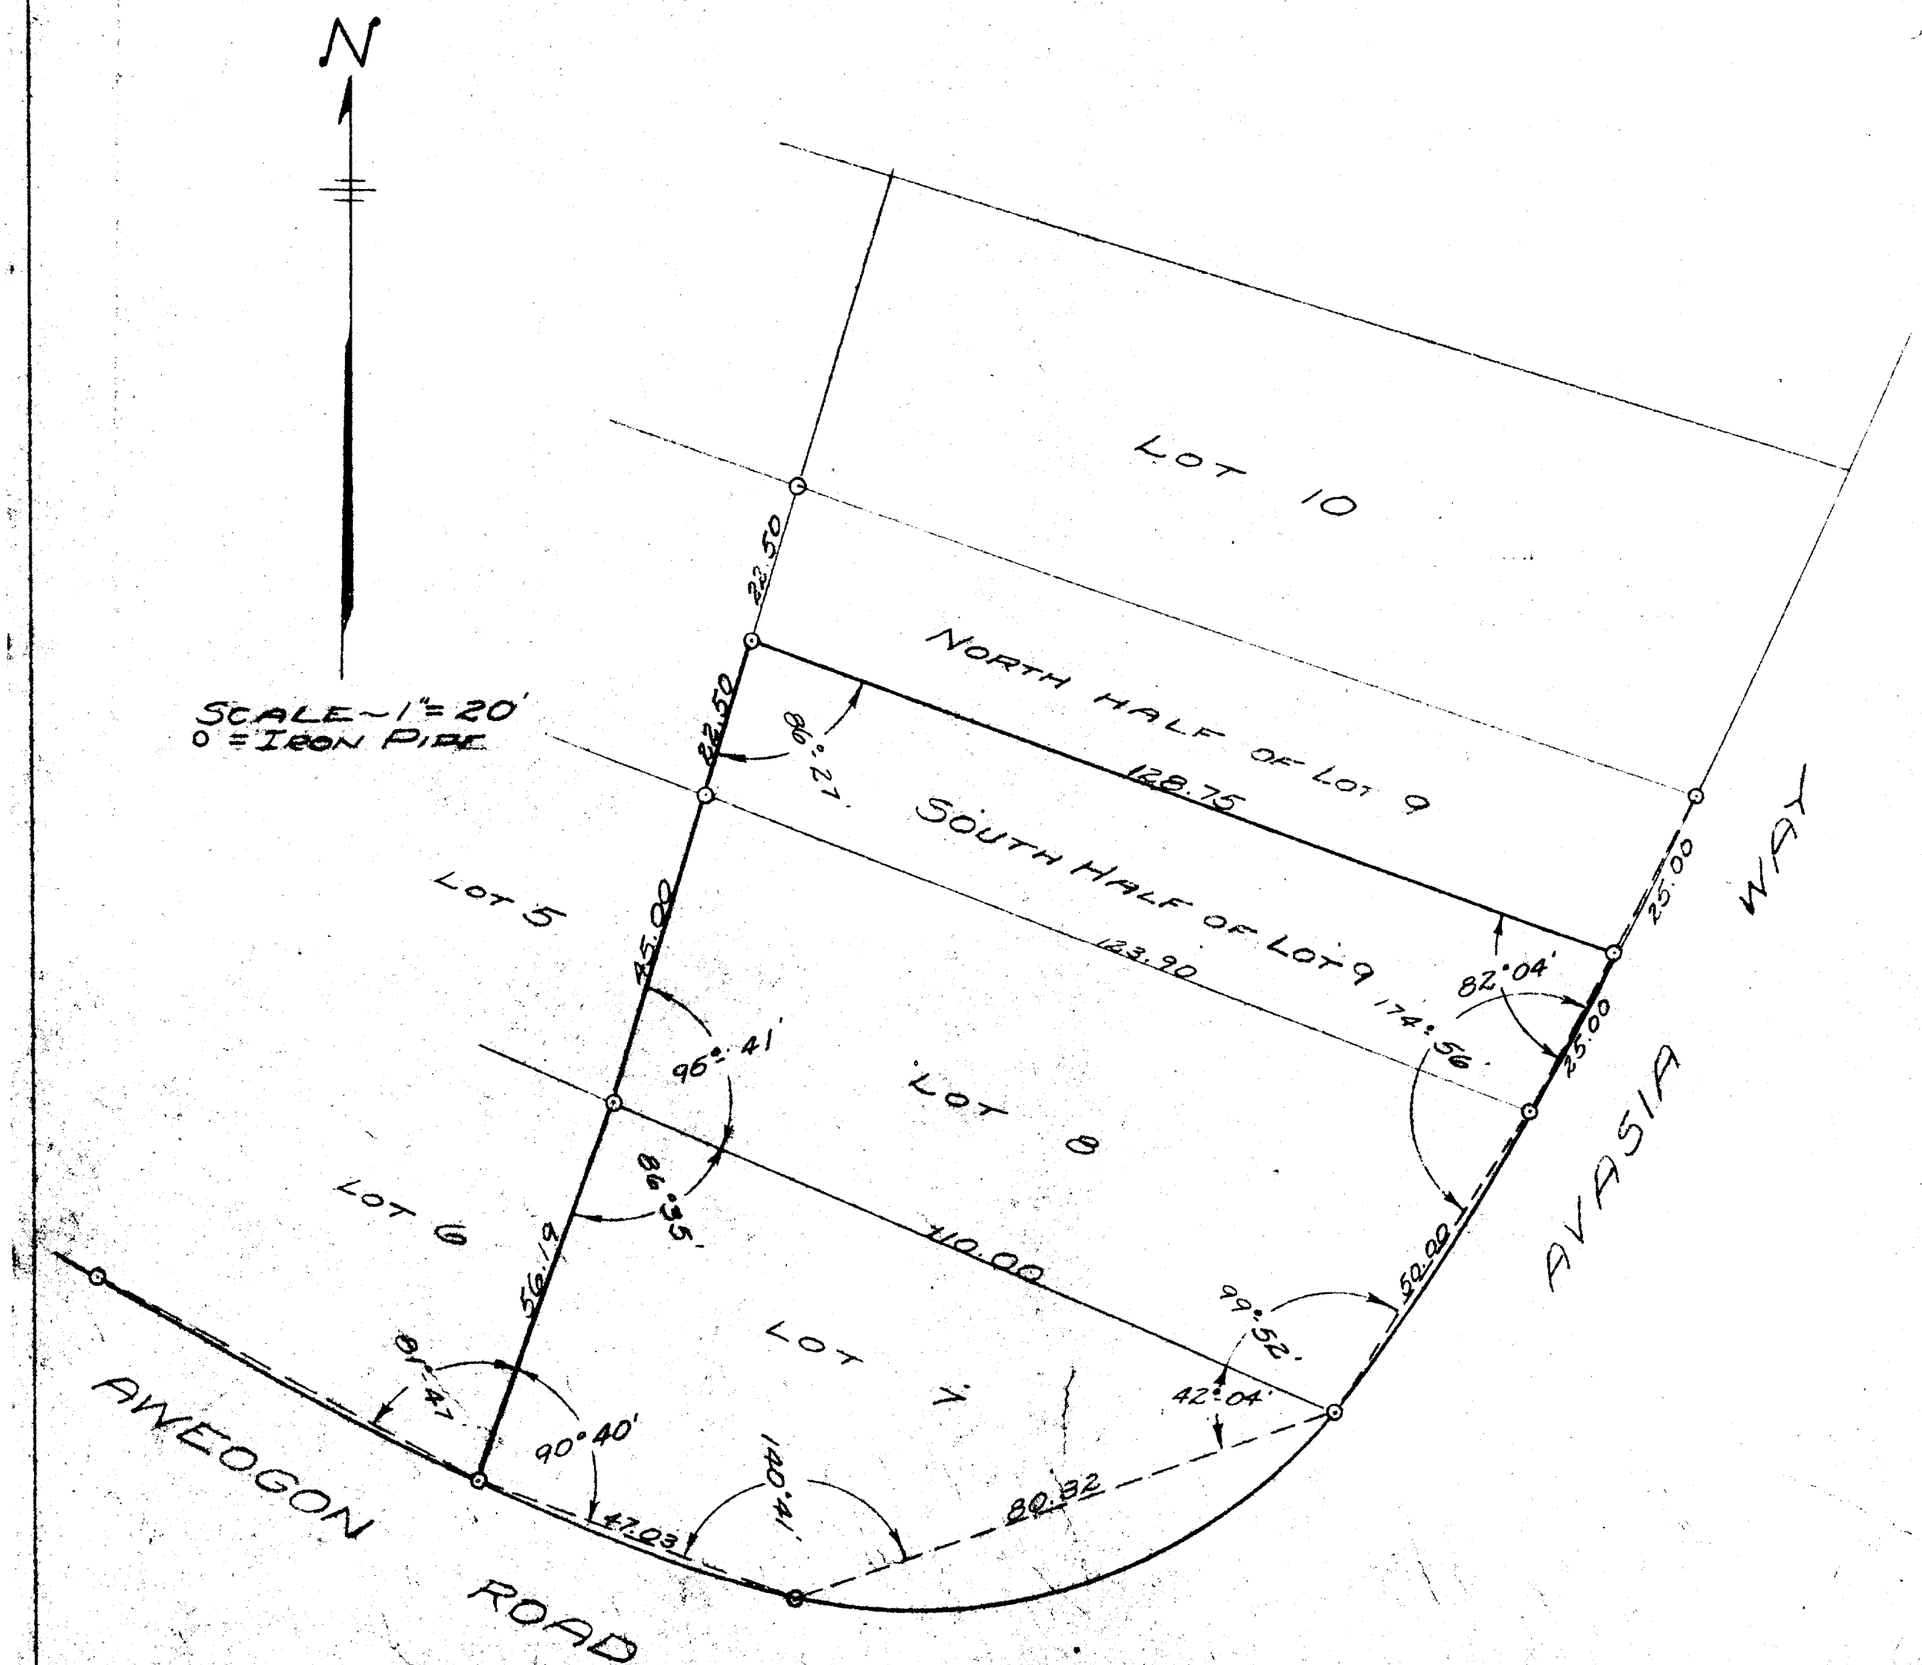

I HEREBY CERTIFY THAT THE PLAT SHOWN HEREON IS A CORRECT REPRESENTATION OF A SURVEY OF LOTS 7 AND 8 AND THE SOUTH HALF OF LOT 9 OF BLOCK 3 OF INDIAN HILLS SUBDIVISION, IN THE VILLAGE OF FONTANA-ON-GENEVA LAKE, WALWORTH COUNTY, WISCONSIN AND THAT THE ORIGINAL STAKES OF THE SUBDIVISION WERE FOUND AT THE CORNERS OF SAID LOTS 7 8 AND 9.

NOV. 28, 1945

Lloyd L. Jensen
COUNTY SURVEYOR

S14-52, S14-53 + 55

5-18 J