
#31-63.

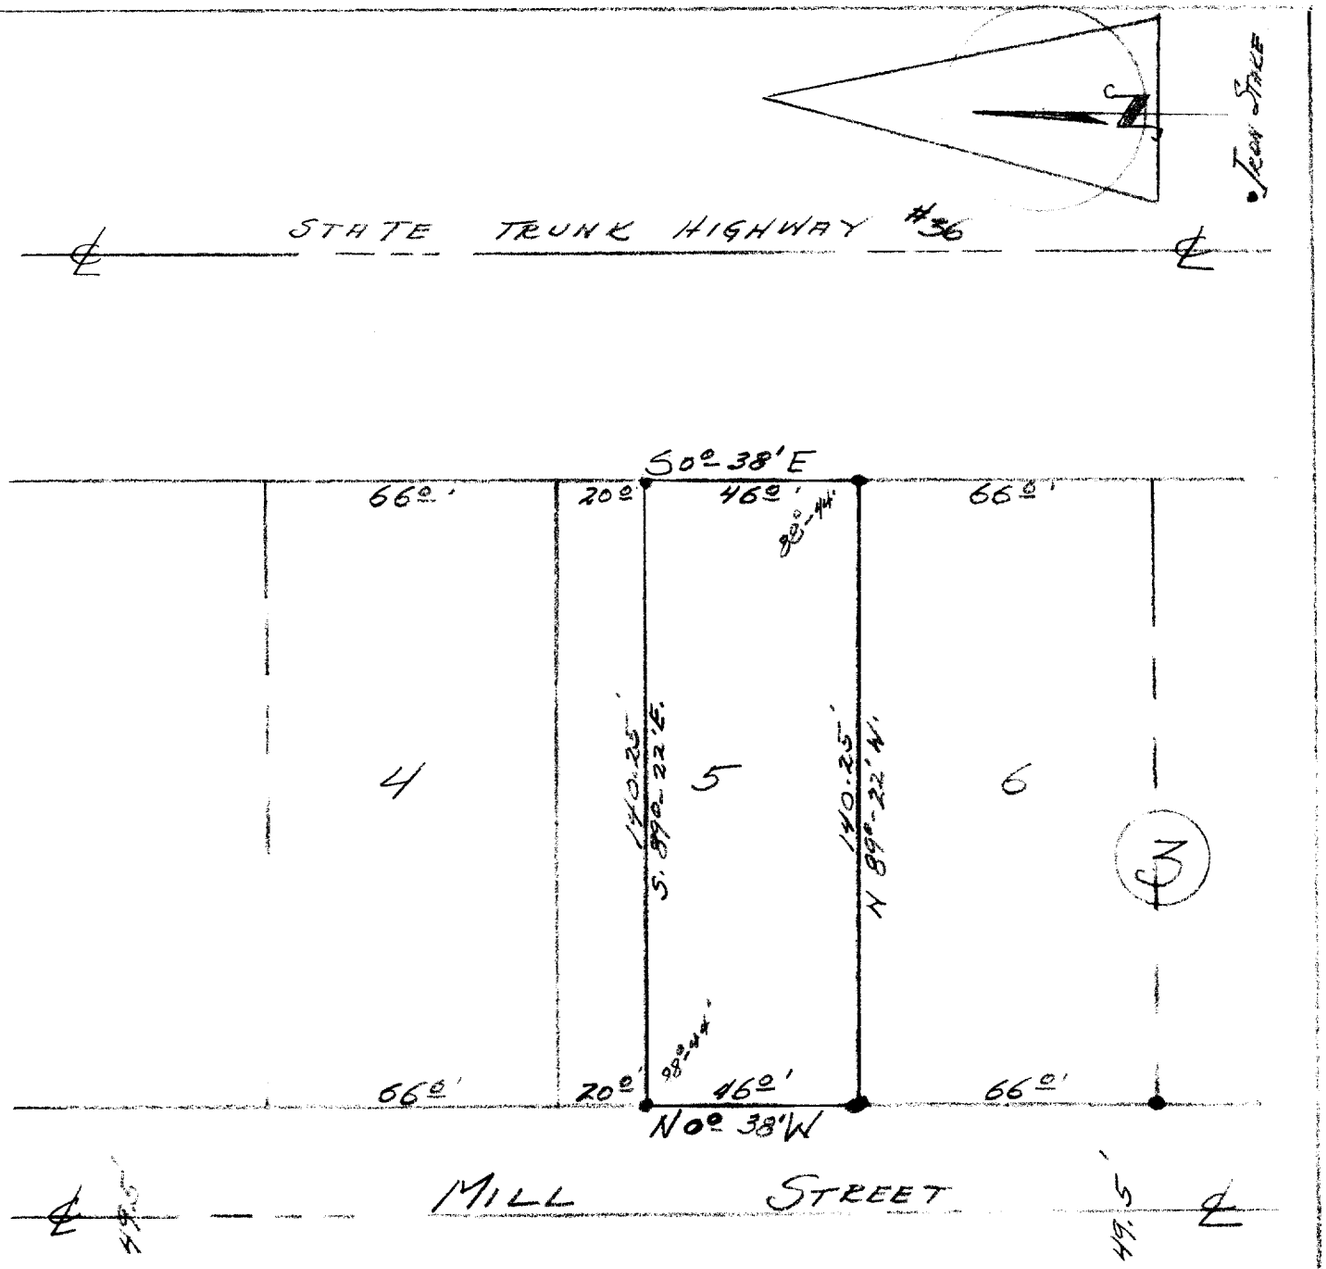

DESCRIPTION: The South 46.00 feet of Lot 5, Block 3, Assessor's Plat #1, C.L. Douglass Addition to the Village of Fontana, Walworth, County, Wisconsin.

CERTIFICATE: I, James F. Biagi, Surveyor, do hereby certify that I have surveyed the property hereon described, on this the 27th day of March, 1963.

James F. Biagi

James F. Biagi. (RLS 272)
Elkhorn, Wisconsin.

5-2B

STEV - 1994