**FARRIS, HANSEN & ASSOC. INC.**
7 RIDGWAY COURT– P.O. BOX 437
ELKHORN, WISCONSIN 53121
PHONE (262) 723–2098
FAX (262) 723–5886


ORDERED BY: RASMUSSEN LAW OFFICES
113 KENOSHA STREET
WALWORTH, WI. 53184

# PLAT OF SURVEY
## THE WEST 50 FEET OF LOT 3 BLOCK 5
## ORIGINAL PLAT OF THE VILLAGE OF FONTANA–ON–GENEVA LAKE
## WALWORTH COUNTY, WISCONSIN

The West Fifty (50) feet of Lot Three (3), Block Five (5), Original Plat of the Village of Fontana, in the Village of Fontana, Walworth County, Wisconsin.

Tax Parcel Number: SOP 00029


Property Address:
221 2nd Street
Fontana, WI 53125

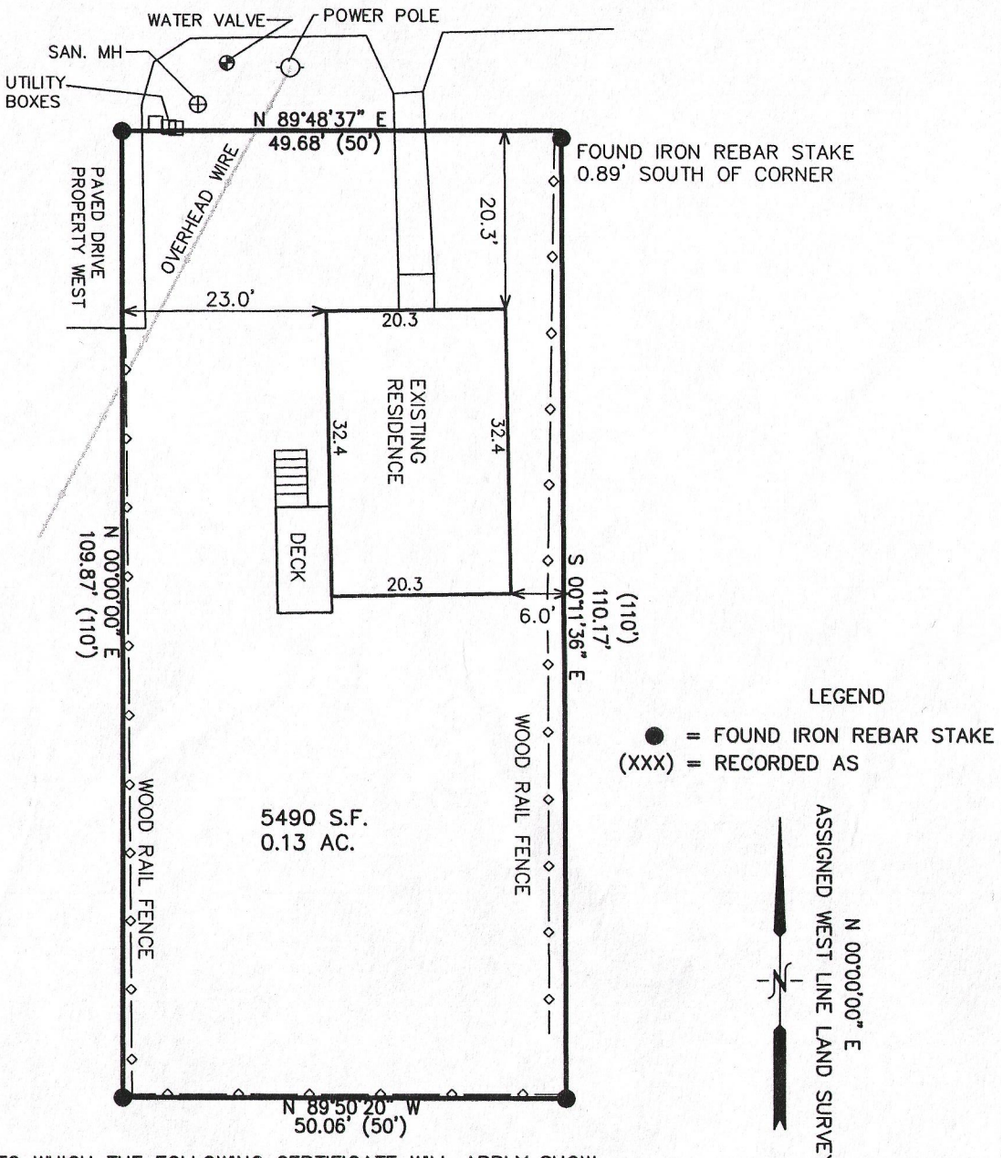


RECEIVED
SEP 11 2013
By jc

NOTE: COPIES OF THIS MAP TO WHICH THE FOLLOWING CERTIFICATE WILL APPLY SHOW THE SURVEYOR'S ORIGINAL SEAL AND SIGNATURE IN RED INK. COPIES BY ANY OTHER MEANS MAY HAVE ALTERATIONS WHICH DO NOT REPRESENT THE SURVEYOR'S WORK PRODUCT.

I HEREBY CERTIFY THAT THE ABOVE DESCRIBED PROPERTY HAS BEEN SURVEYED UNDER MY DIRECTION AND THAT THE ABOVE MAP IS A TRUE REPRESENTATION THEREOF AND SHOWS THE SIZE AND LOCATION OF THE PROPERTY, ITS EXTERIOR BOUNDARIES, THE LOCATION OF ALL VISIBLE STRUCTURES, AND DIMENSIONS OF ALL PRINCIPLE BUILDINGS THEREON, BOUNDARY FENCES, APPARENT EASEMENTS, ROADWAYS, AND VISIBLE ENCROACHMENTS, IF ANY. THIS SURVEY IS MADE FOR THE USE OF THE PRESENT OWNERS OF THE PROPERTY, AND ALSO THOSE WHO PURCHASE, MORTGAGE, OR GUARANTEE THE TITLE THERETO WITHIN ONE YEAR FROM THE DATE HEREOF.

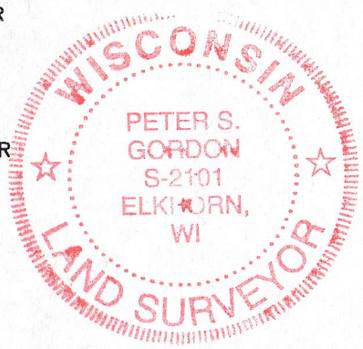


DATED: SEPTEMBER 6, 2013

PETER S. GORDON

PROJECT NO. 8878
DATED: 09–06–2013
SHEET 1 OF 1 SHEETS

10 5 0 10 20 30 40 50 60 70 80 90 100
MAP SCALE IN FEET ORIGINAL 1" = 20'

SEP 09 2013

SOP -29 005-3003