
PREPARED FOR
LOWELL MANAGEMENT
401 GENEVA NATIONAL AVE. SO.
LAKE GENEVA WI. 53147

PLAT OF SURVEY

-OF-

LOT 1, BLOCK 1 BROOKWOOD SUBDIVISION, LOCATED IN THE VILLAGE OF FONTANA - ON - GENEVA LAKE, WALWORTH COUNTY, WISCONSIN.

KROTT SURVEYING INC.
N3705 WILLOW BEND LANE
LAKE GENEVA WI. 53147
PHONE # (262)248-3697
FAX # (262)249-0639

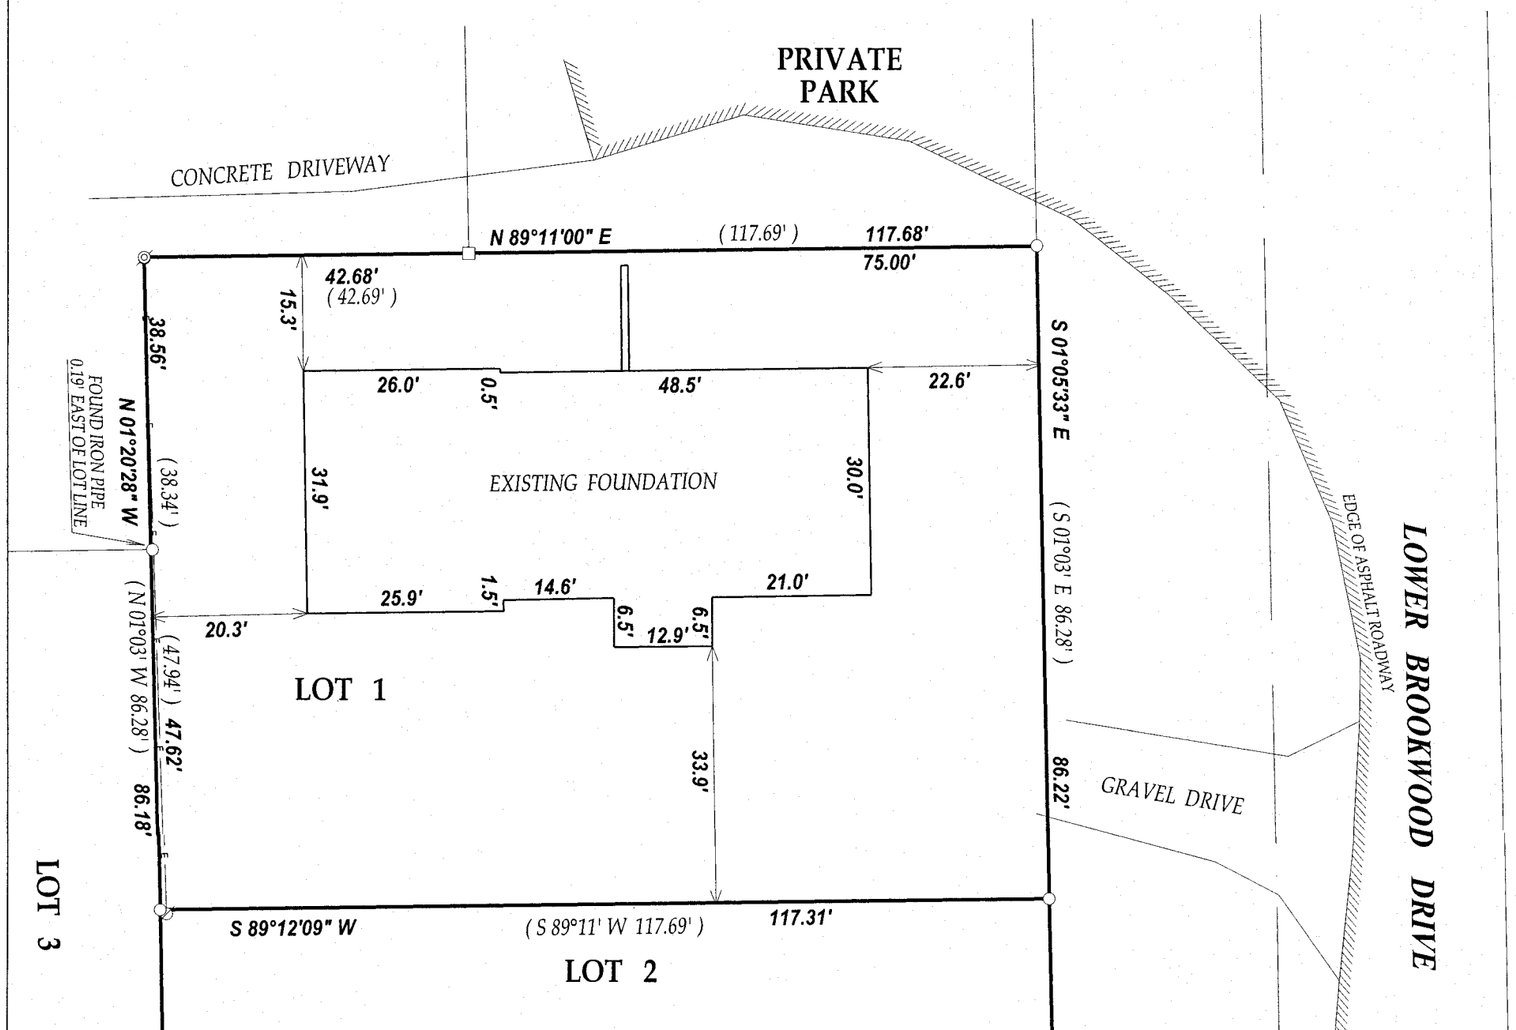

RECEIVED
JAN 21 2014
By

LEGEND

- FOUND 1" DIA. IRON PIPE
- FOUND 2" DIA. IRON PIPE
- FOUND IRON BAR
- ELECTRIC METER
- GAS METER
- UTILITY POLE
- OVERHEAD WIRES
- DECIDUOUS TREE
- CONIFER TREE
- (XX) RECORDED AS

TAX ID # SBS00001
JOB # 12-011PH

N
W E
S

SCALE 1"=20'

0 20 40 60

NOTE : BEARINGS ARE REFRENCED TO THE RECORD PLAT

I have surveyed the above-described property and the above map is a true representation thereof and shows the size and location of the property, its exterior boundaries, the location and dimensions of all structures thereon, fences apparent easements and roadways and visible encroachments. if any.

This survey is made for the exclusive use of the present owners of the property, and also those who puchase, mortgage,or insure the title therto within one (1) year from date hereof; and as to them I warrant the accuracy of said survey map.

WISCONSIN
JOHN P.
KROTT
S-2258
LAKE GENEVA
WIS.
LAND SURVEYOR

DATED THIS 15th DAY OF FEBRUARY 2012.
DATE OF LAST REVISION 12/09/2013
REVISED 10/23/2013

JOHN KROTT S - 2258
Wisconsin Registered Land Surveyor
(original if signed in red)

SBS-1 005-3036