
DUNHAM & RASMUSSEN
SURVEYING & ENGINEERING
DELAVAN, WISCONSIN

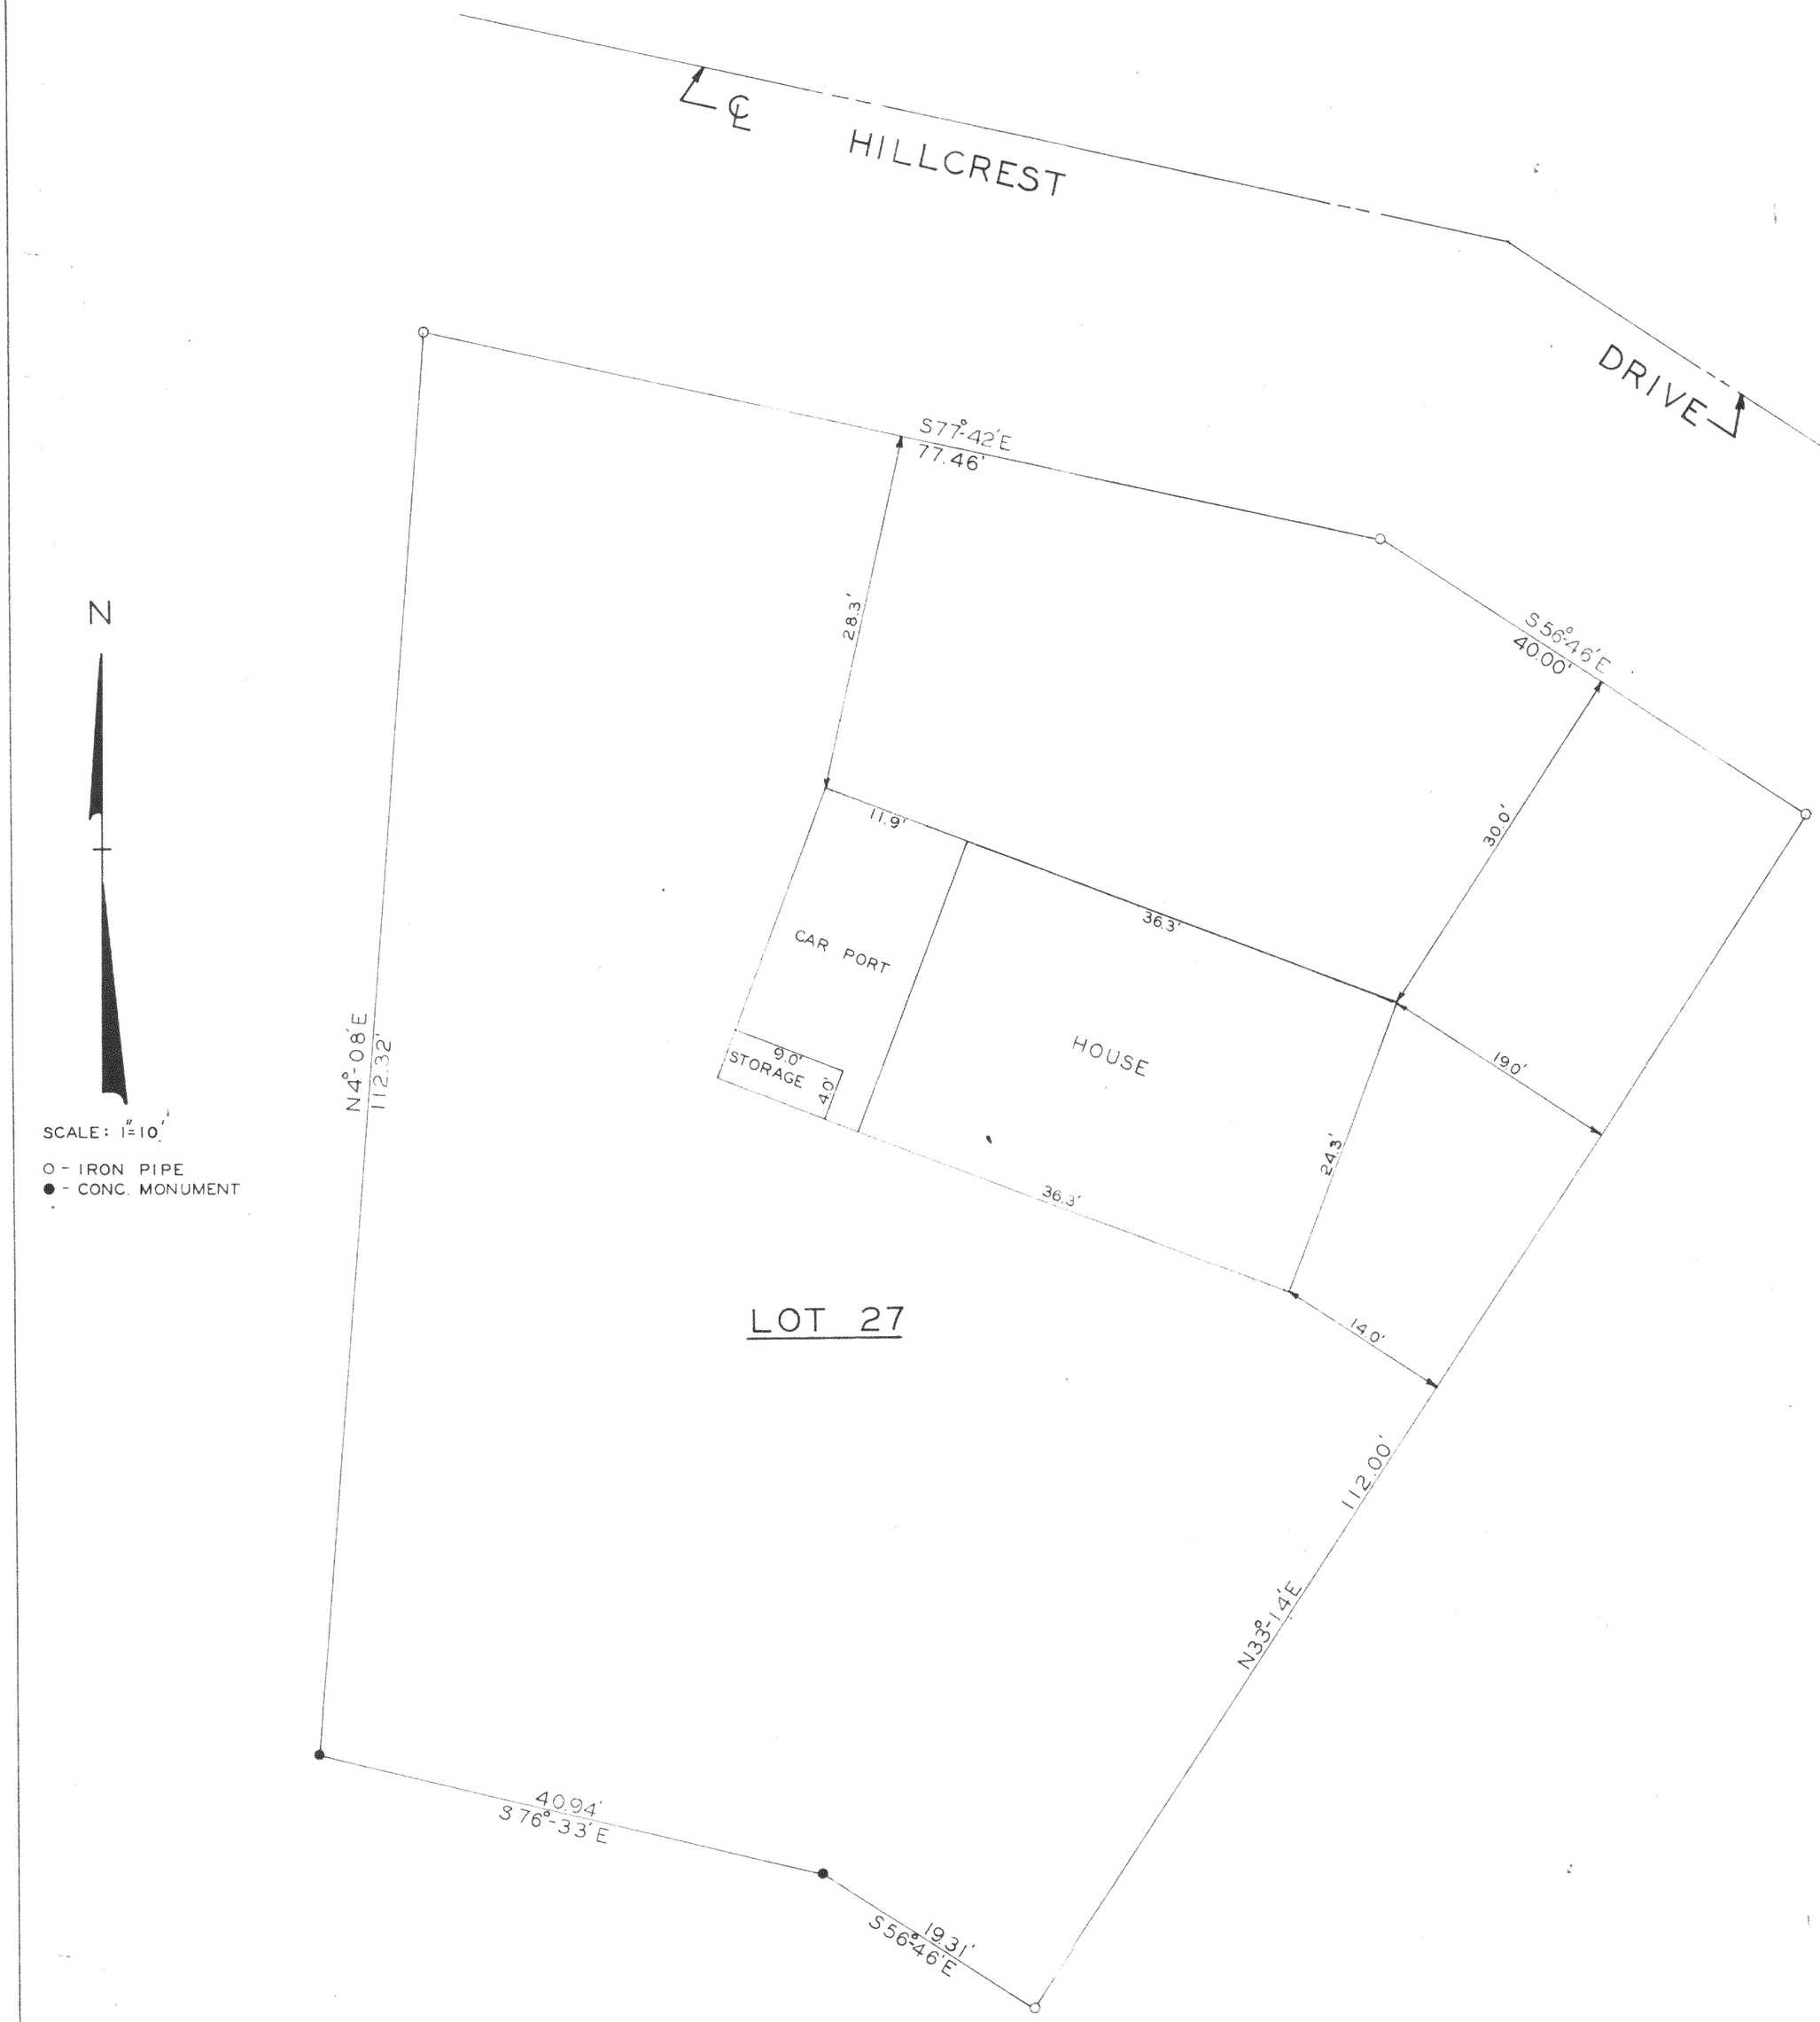

STATE OF WISCONSIN) S.S.
WALWORTH COUNTY)

I, GEORGE T. DUNHAM, DO HEREBY CERTIFY THAT I HAVE SURVEYED LOT 27, ADDITION D, COUNTRY CLUB ESTATES, VILLAGE OF FONTANA, WALWORTH COUNTY, WISCONSIN.

AND THAT THE ABOVE PLAT IS A CORRECT REPRESENTATION OF THE PROPERTY AND THE IMPROVEMENTS LOCATED THEREON.

FEBRUARY 15, 1960

George T. Dunham
GEORGE T. DUNHAM, SURVEYOR

SCTD-28

5-31