

PREPARED FOR:
JOSEPH PRINGLE
7 AMBROSE LANE
SOUTH BARRINGTON, IL 60010

PLAT OF SURVEY

-OF-


LYNCH & ASSOCIATES
ENGINEERING CONSULTANTS, LLC.
405 SKYLINE DRIVE, SUITE C
LAKE GENEVA, WI 53147
(262) 248-3697

LOT 2, CERTIFIED SURVEY MAP NO. 305, AD DULY RECORDED
IN WALWORTH COUNTY RECORDS AS DOCUMENT NO.
671978, LOCATED IN SECTION 13, TOWN 1 NORTH, RANGE 16
EAST, VILLAGE OF FONTANA, WALWORTH COUNTY,
WISCONSIN.

LOT 1 C.S.M. 305

TAX PARCEL: STFV 00110


TAX PARCEL: STFV 00107A

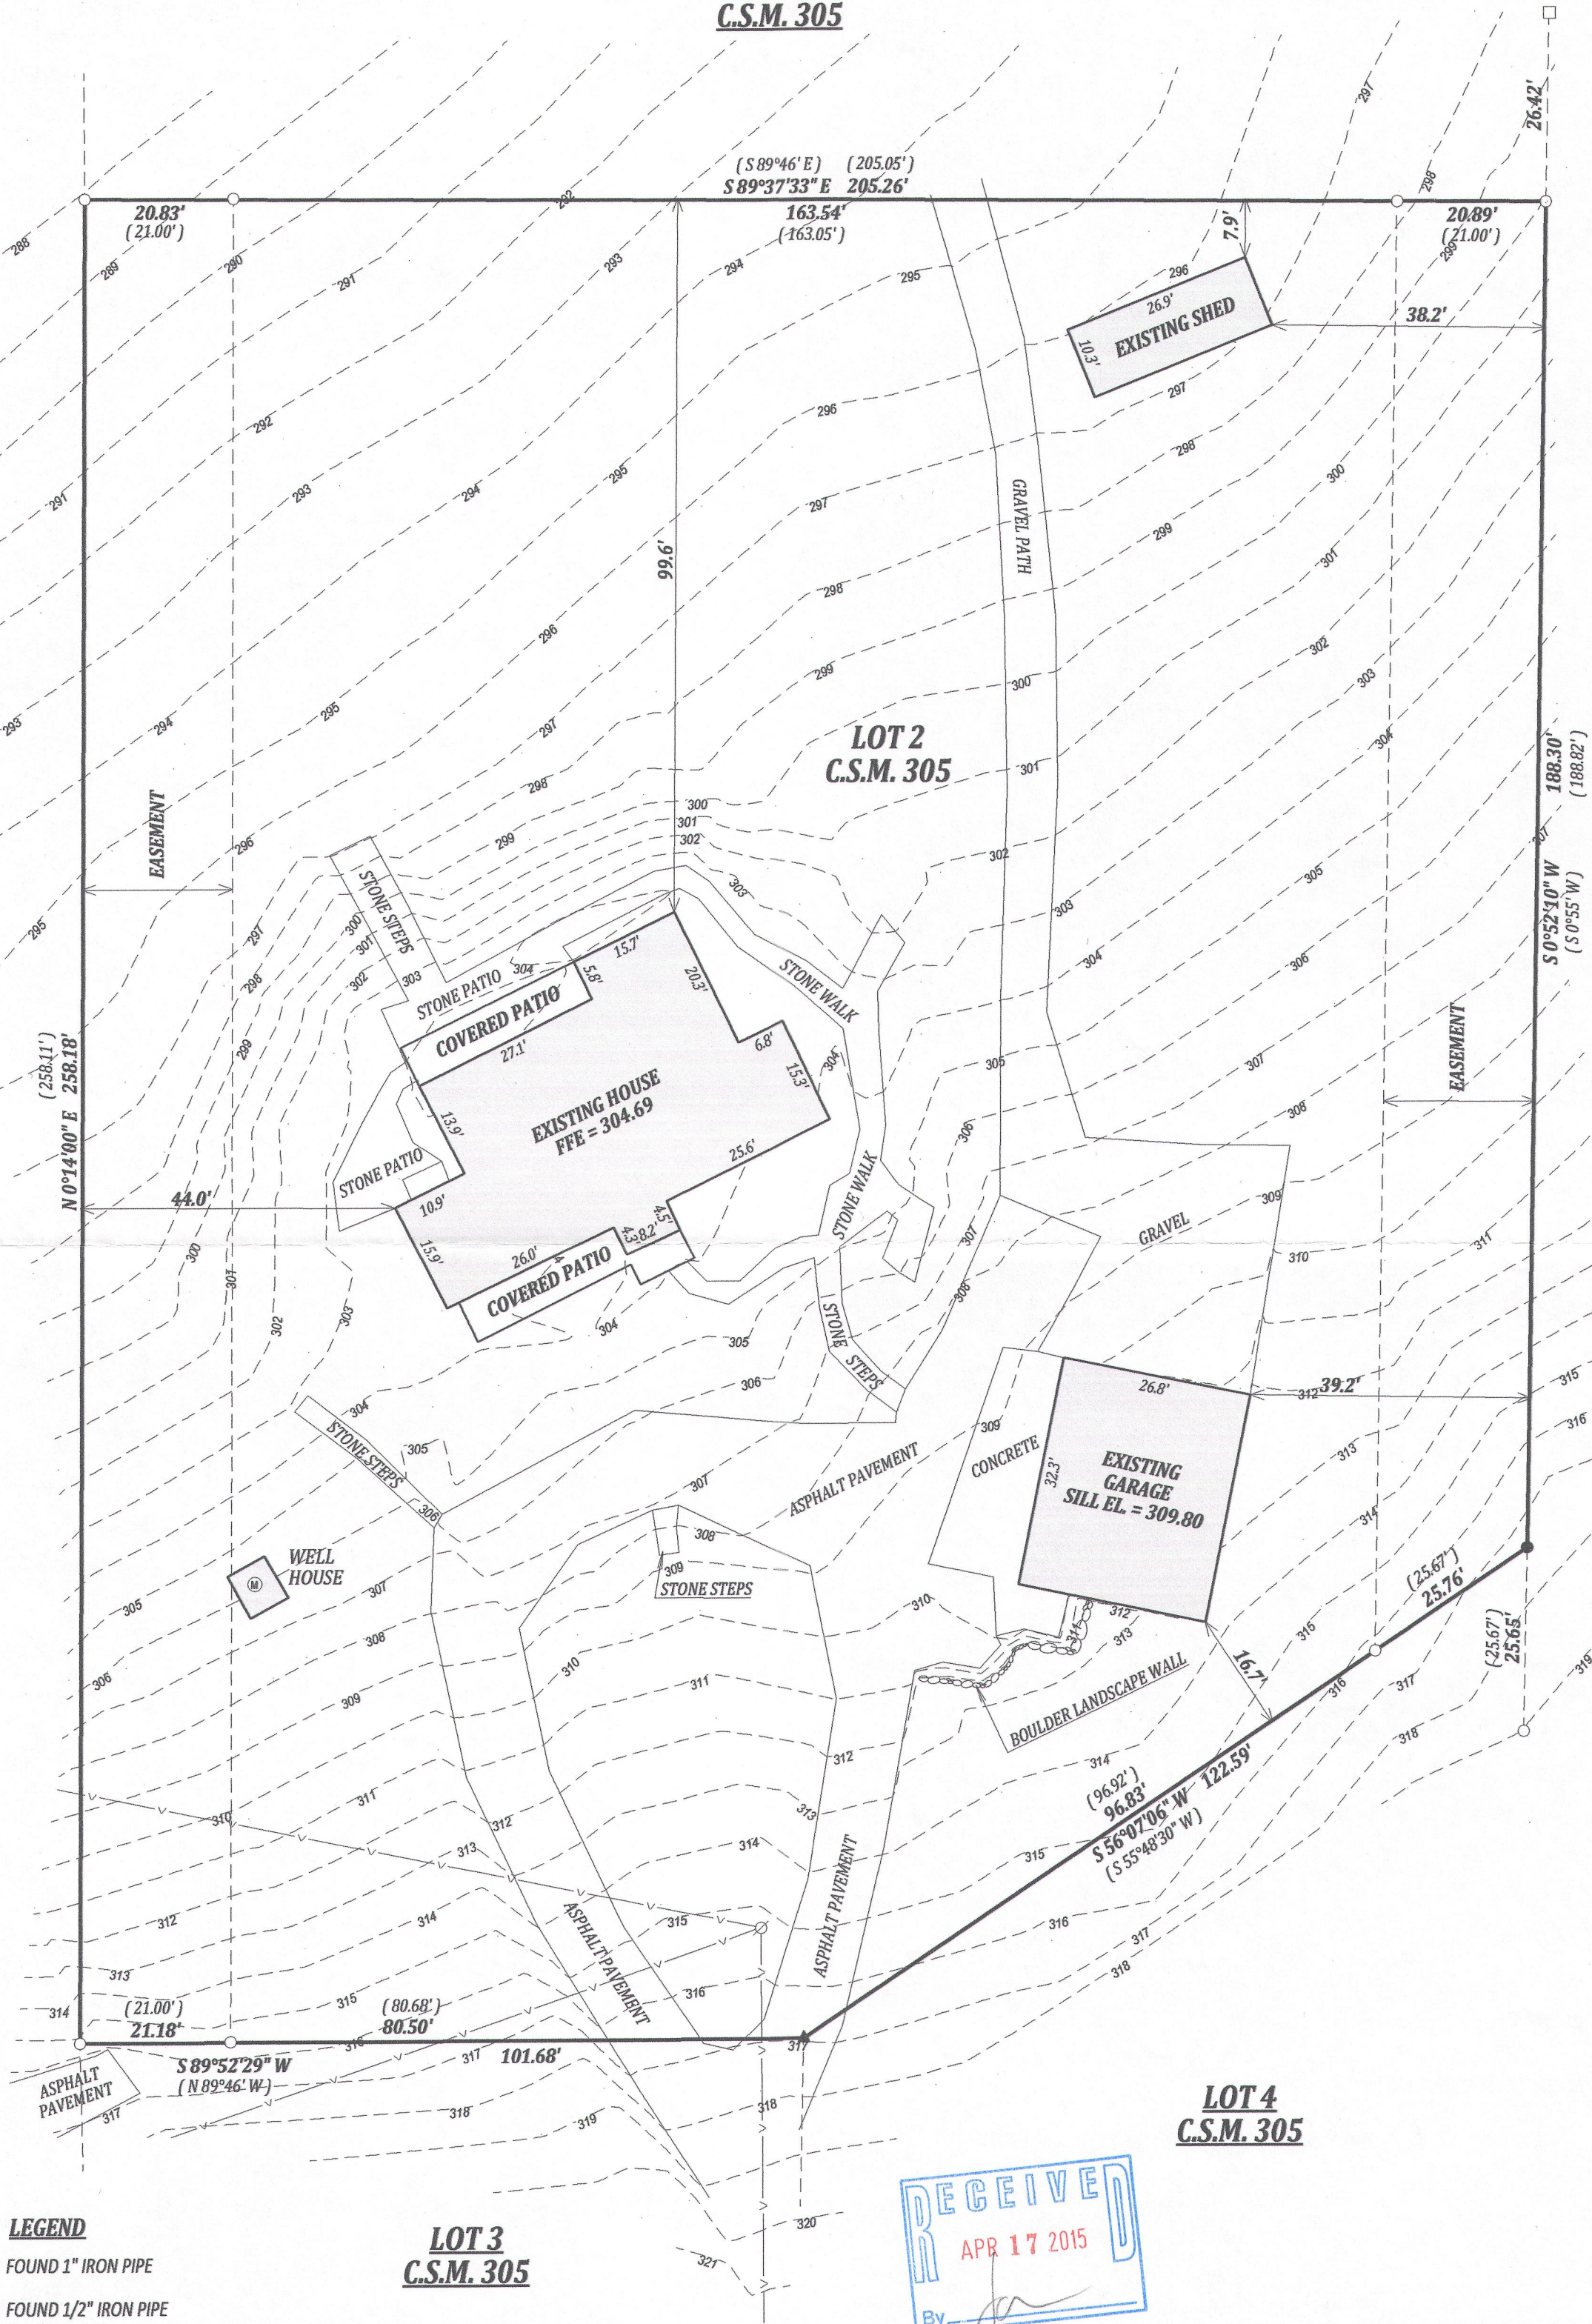

LEGEND

- FOUND 1" IRON PIPE
- FOUND 1/2" IRON PIPE
- FOUND 5/8" IRON BAR
- ▲ SET "MAG" NAIL
- (xx) RECORDED AS
- ⊗ POWER POLE
- OVERHEAD UTILITY LINE
- ⊙ MANHOLE


LOT 3 C.S.M. 305

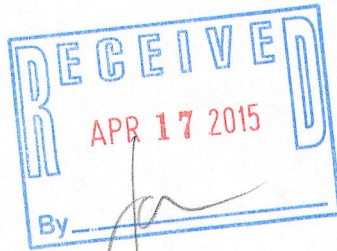

NOTE:
No title commitment or results of a title search were provided to this office pertaining to this survey. This Plat Of Survey may not reflect easements of record, encumbrances, restrictions, ownership, title evidence, or other facts that a current and accurate title search may disclose.

I have surveyed the above-described property and the above map is a true representation thereof and shows the size and location of the property, its exterior boundaries, the location and dimensions of all structures thereon, fences apparent easements and roadways and visible encroachments, if any.

This survey is made for the exclusive use of the present owners of the property, and also those who purchase, mortgage, or insure the title thereto within one (1) year from date hereof; and as to them I warrant the accuracy of said survey map.

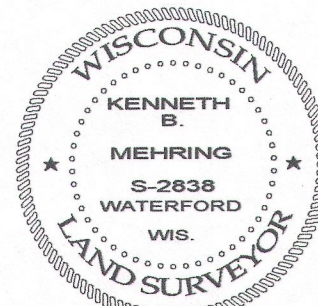

DATED THIS 14th DAY OF FEBRUARY, 2015

KENNETH B. MEHRING S - 2838
Wisconsin Registered Land Surveyor
(original if signed in red)

