
**LAND-MARK SURVEYING**
**Mark L. Miritz**
**Wisconsin Professional Land Surveyor S-2582**

N9330 Knuteson Drive
Whitewater, WI 53190
Phone:(262)495-3284
MARKMIRITZ@
LAND-MARKSURVEYING.COM

**ORDERED BY: MARY BETH BROMFIELD**
**THE RAULAND AGENCY**
**118 KENOSHA STREET**
**WALWORTH, WI 53184**


# PLAT OF SURVEY

**LOT 30, ADDITION "D" TO COUNTRY CLUB ESTATES LOCATED IN THE VILLAGE OF FONTANA-ON-GENEVA LAKE, WALWORTH COUNTY, WISCONSIN**

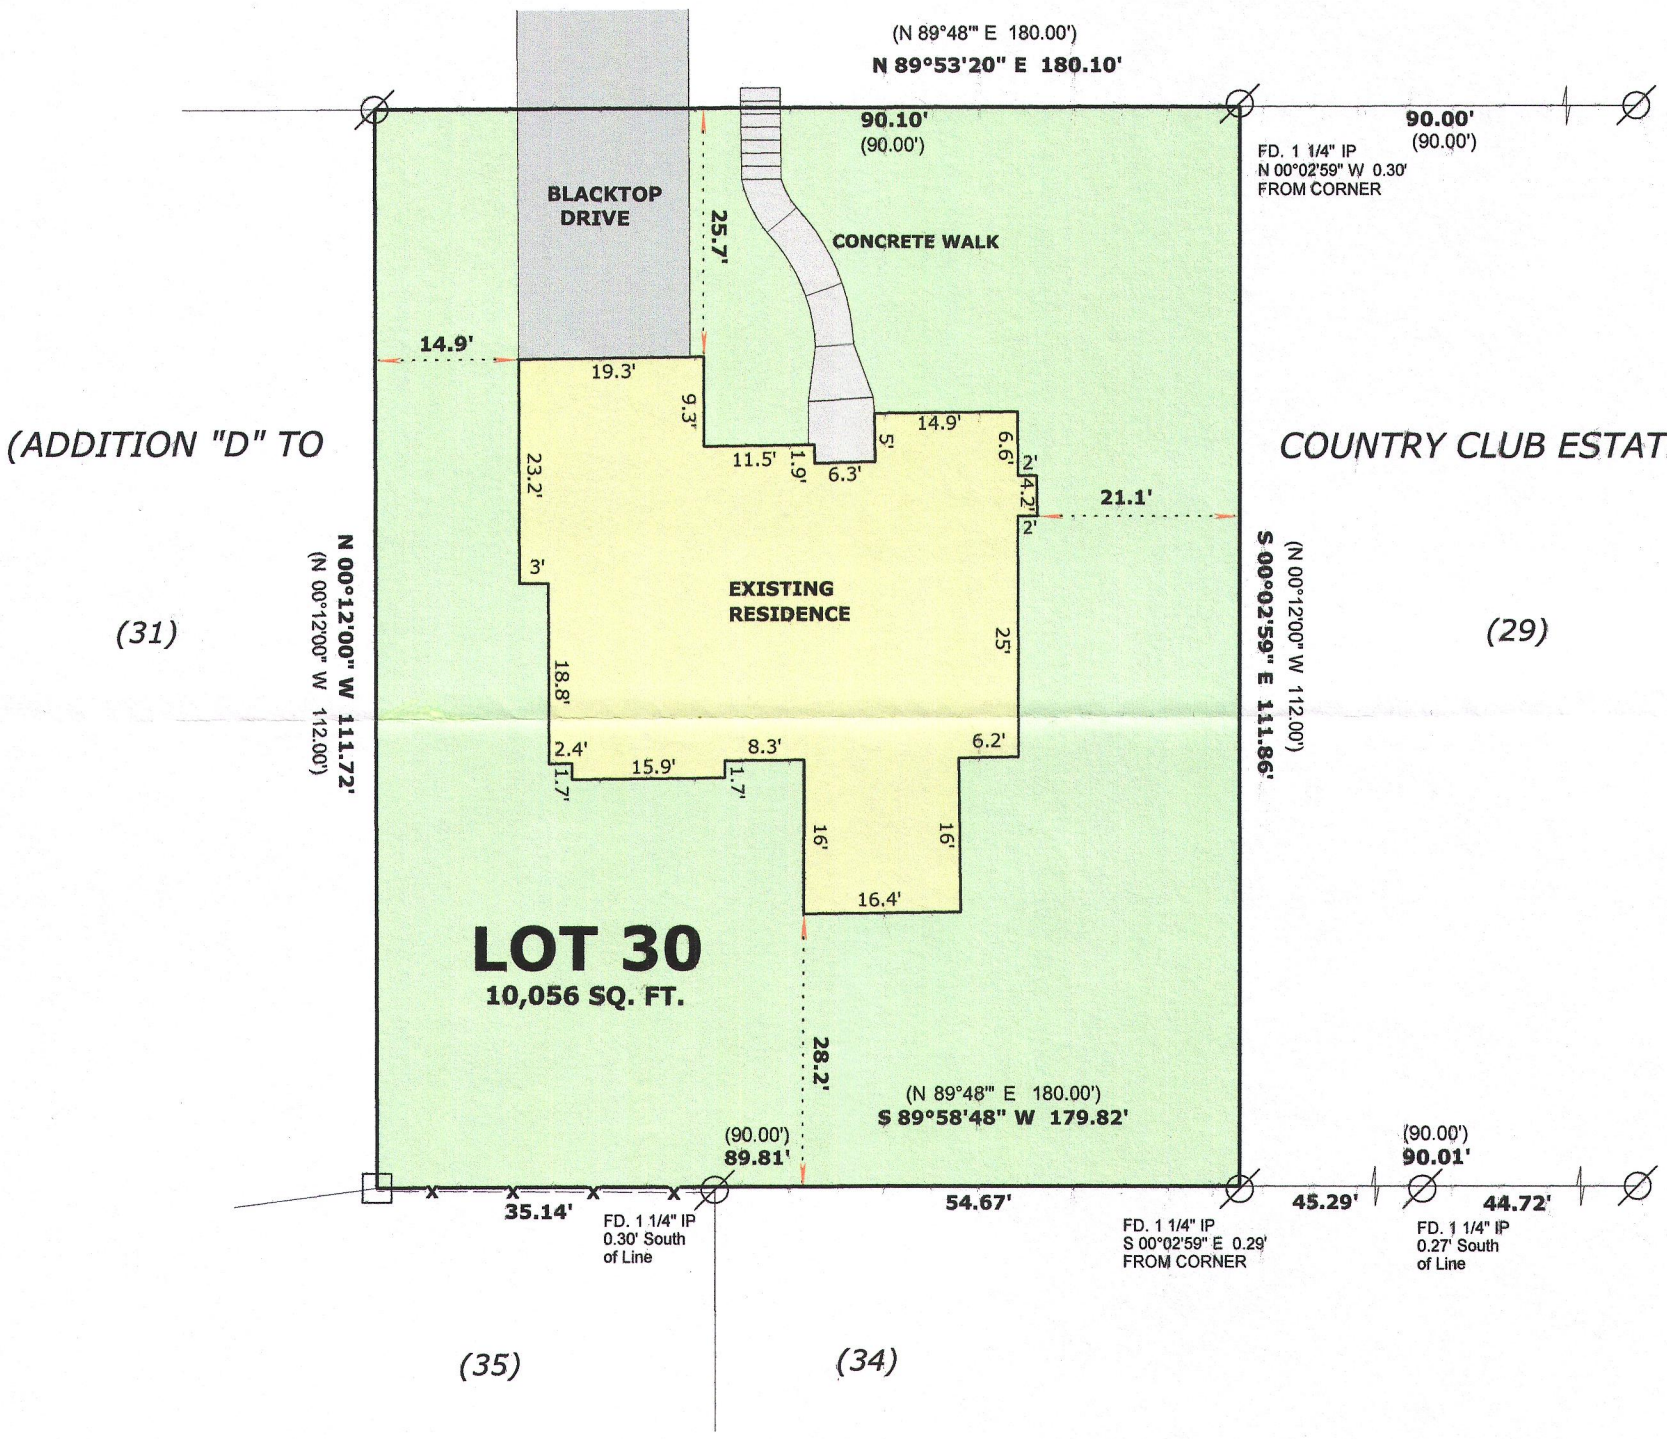



*(ADDITION "F" TO COUNTRY CLUB ESTATES)*

**SURVEYOR'S NOTE:**
**THE SIDEWALK AND DRIVEWAY LOCATION ARE APPROXIMATE DUE TO SNOW COVER**

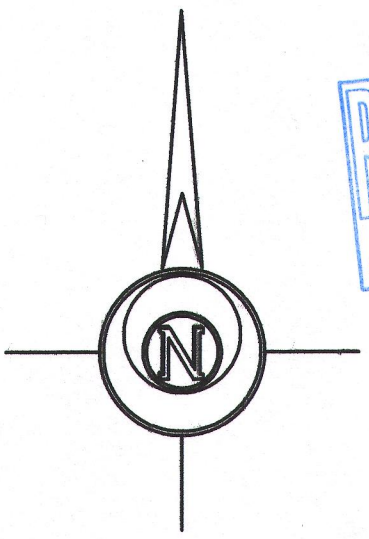


BASIS OF BEARINGS:
THE WEST LINE OF LOT 30 AS MONUMENTED
BEING N 00°12'00" E AS PLATTED

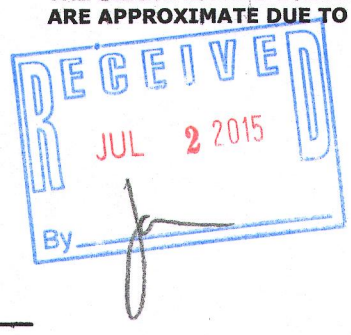





## LEGEND

| | |
|---|---|
| ∅ | FOUND IRON PIPE 1 1/4" |
| □ | FOUND PIPE IN CONCRETE |
| ( x x ) | RECORDED AS DIMENSION |
| —x—x— | EXISTING WOOD FENCE |

**SCALE: 1 INCH = 20 FEET**

"I hereby certify that the above described property has been surveyed by me or under my direction and that the above map is a true representation thereof and shows the size and location of the property, its exterior boundaries, the location of all visible structures and dimensions of all principal buildings thereon, boundary fences, apparent easements, roadways and visible encroachments, if any."
"This survey is made for the use of the present owners of the property, and also those who purchase, mortgage, or guarantee the title thereto within one year from date hereof."

Mark L. Miritz

**MARK L. MIRITZ**
**WISCONSIN PROFESSIONAL**
**LAND SURVEYOR S-2582**

**DATE:** MARCH 13, 2015 **JOB NO.** 15.302

SCTd-31 005-3143