
PREPARED FOR
DORTHY HIGGINS GERBER
SHOREWEST REALTY
LAKE GENEVA, WI

PLAT OF SURVEY

- OF -

LOTS 5 AND 6 OF SPRING VALLEY ESTATES, BEING A REDIVISION OF LAGOONA VALLEY ESTATES AND PART OF OUTLOT 94, ASSESSOR'S PLAT No. 1 AMENDED DESCRIBED AS FOLLOWS: COMMENCING AT THE SW CORNER OF THE INTERSECTION OF GENEVA BLVD. AND BRICKLEY DRIVE; THENCE S 0°08' E 90 FEET; THENCE S 84°24' W 110 FEET; THENCE N 0°08' W 90 FEET; THENCE N84°24' E 110 FEET TO THE POINT OF BEGINNING, LOCATED IN GOVERMENT LOT 3 IN THE SE 1/4 OF SECTION 14, TOWN 1 NORTH, RANGE 16 EAST, VILLAGE OF FONTANA - ON - GENEVA LAKE, WALWORTH COUNTY, WISCONSIN.

PATHFINDER SURVEYING INC.
(formerly)
J.K. SURVEYING INC.
P.O BOX 322
LAKE GENEVA, WI. 53147
WWW.PATHFINDERSURVEYING.NET
262-248-8303

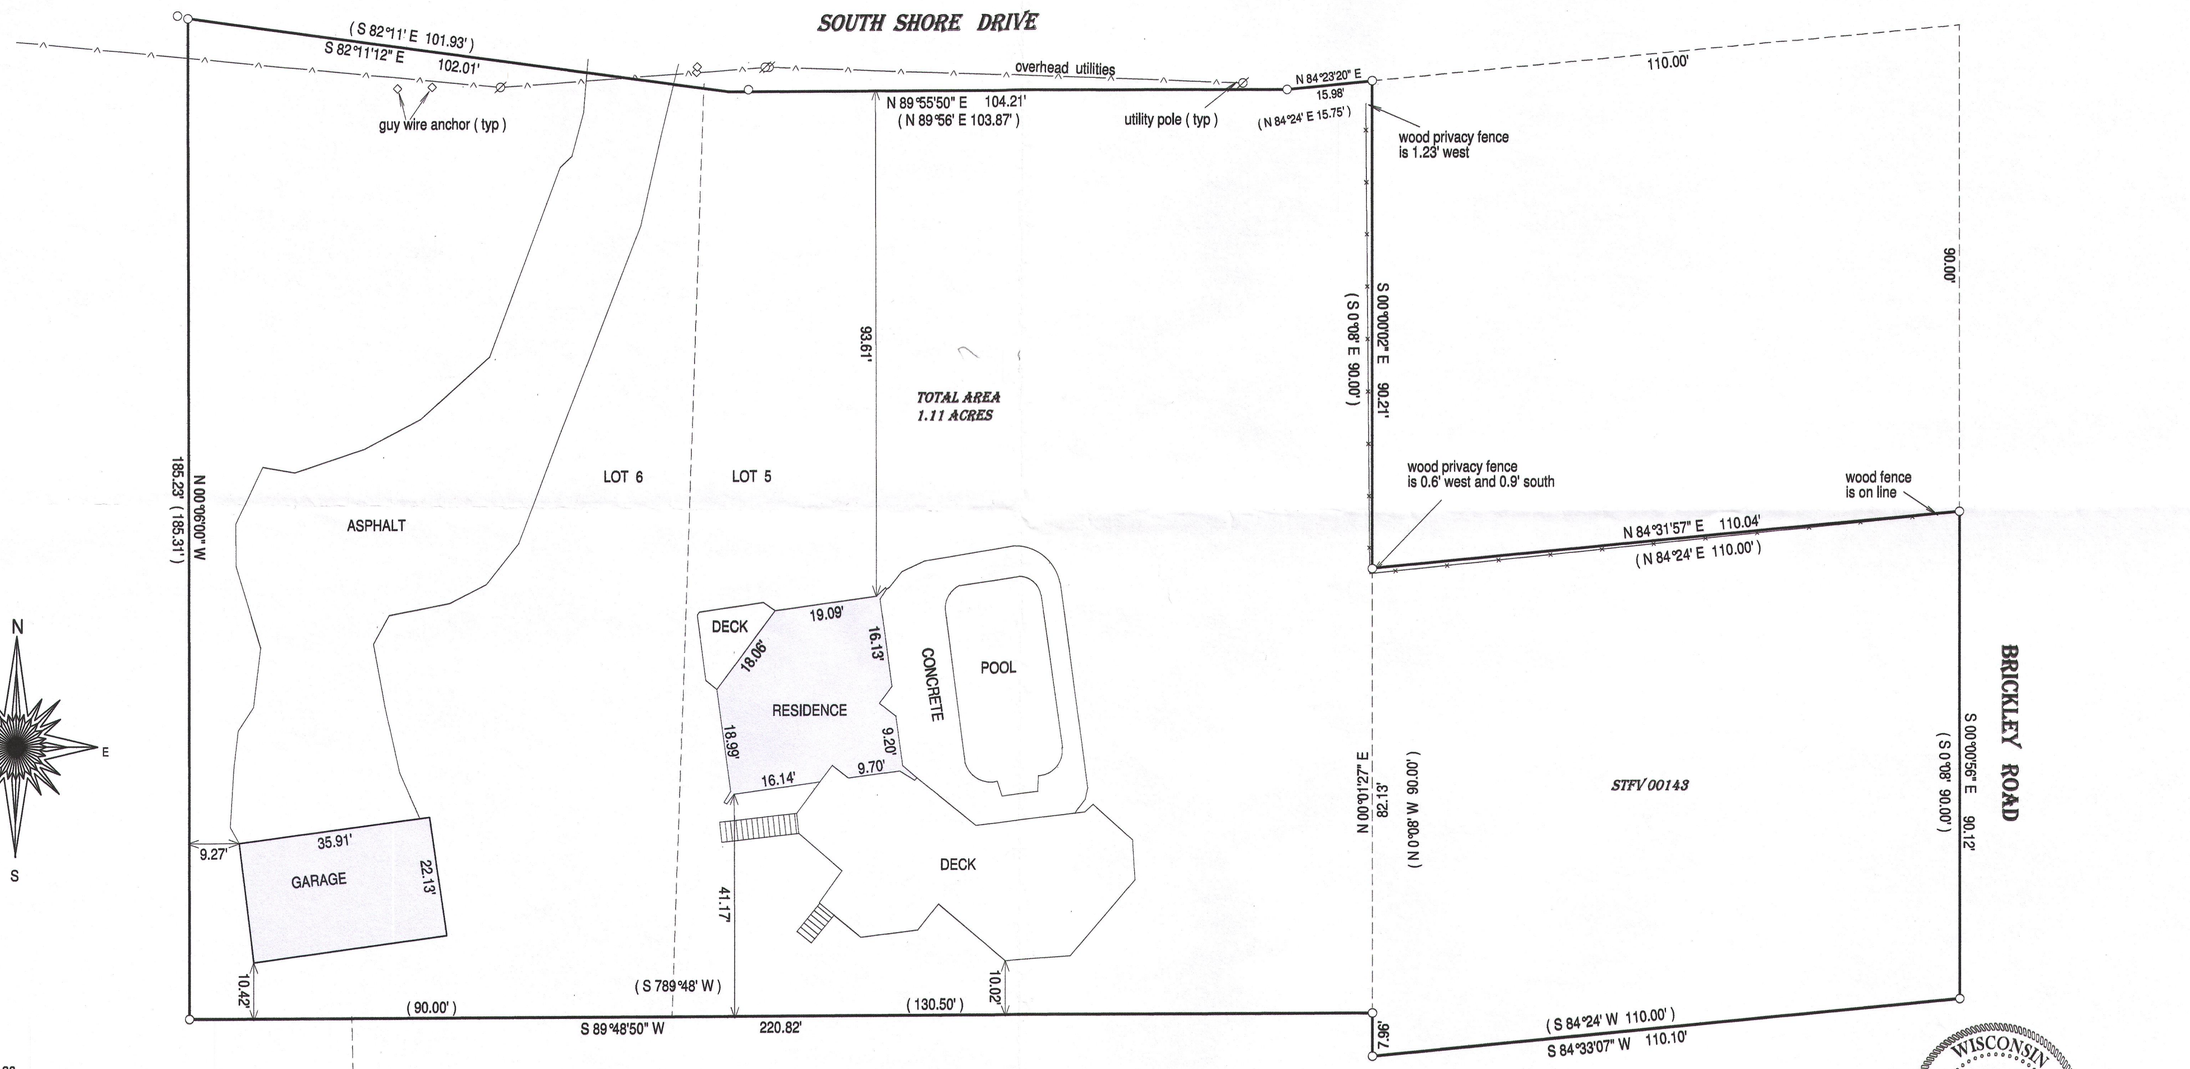

( )= recorded as
□ = found iron bar
○ = found iron pipe
● = set iron pipe
■ = set iron bar

SCALE 1" = 20'

JOB # 15-90

TAX ID # STFV 00143 & SSV 00005

BASIS OF BEARING OF THIS PLAT: THE WEST LINE OF LOT 5 WAS ASSUMED TO BEAR N 00°06'00" W AS RECORDED .

"I hereby certify that I have surveyed the above described property and that the above map is a true representation of its exterior boundaries and shows the size and location of all visible structures, apparent easements and encroachments if any." This survey is made for the present owners of the property, and those who purchase, mortgage, or guarentee the title thereto, within one year from the date hereof.

DATED THIS 10TH DAY OF APRIL, 2015.

RECEIVED
AUG 7 2015
By

WISCONSIN
JEFFREY L KIMPS S-2436 LAKE GENEVA, WIS.
LAND SURVEYOR

JEFFREY L KIMPS S-2436
Wisconsin Registered Land Surveyor
(original if signed in red)

STFV - 143
SSV - 5

005-3145