

CERTIFIED SURVEY MAP NO. 1414

Lots 1 and 2 of Certified Survey Map No. 1414, located in the Northeastly 1/4 of Section 13, Township One North, Range 6 East, Village of Fontana-on-Genewa Lake, Walworth County, Wisconsin recorded April 10, 1985 in Volume 6 of Certified Survey Maps, Page 290, as Document No. 1138602, and further described as commencing at the East 1/4 corner of said Section 13; thence North 88° 45' 00" West 410.61 feet to the place of beginning, thence continue North 88° 45' 00" West 168.78 feet to the North 0° 48' 30" point 905.18 feet to the place of beginning, thence Northeastly, along said point 905.18 feet to the North 0° 48' 30" point 934.32 feet from the place of beginning, thence South 0° 47' 40" West 934.32 feet to the place of beginning, and further being a Division of Outlot 54 of Assessor Plat No. 1 amended, all in Walworth County, Wisconsin.

Tax Key No: SA141400001 and SA141400002

NOTE: COPIES OF THIS MAP TO WHICH THE FOLLOWING CERTIFICATE WILL APPLY SHOW THE SURVEYOR'S ORIGINAL SEAL AND SIGNATURE IN RED INK. COPIES BY ANY OTHER MEANS MAY HAVE ALTERATIONS WHICH DO NOT REPRESENT THE SURVEYOR'S WORK PRODUCT.

I HEREBY CERTIFY THAT THE ABOVE DESCRIBED PROPERTY HAS BEEN SURVEYED UNDER MY DIRECTION AND THAT THE ABOVE MAP IS A TRUE REPRESENTATION THEREOF AND SHOWS THE SIZE AND LOCATION OF THE PROPERTY, ITS EXTERIOR BOUNDARIES, THE LOCATION OF ALL VISIBLE STRUCTURES, AND DIMENSIONS OF ALL PRINCIPLE BUILDINGS THEREON, BOUNDARY FENCES, APPARENT EASEMENTS, ROADWAYS, AND VISIBLE ENCROACHMENTS, IF ANY. THIS SURVEY IS MADE FOR THE USE OF THE PRESENT OWNERS OF THE PROPERTY, AND ALSO THOSE WHO PURCHASE, MORTGAGE, OR GUARANTEE THE TITLE THERETO WITHIN ONE YEAR FROM THE DATE HEREOF.



DATED: OCTOBER 30, 2015

Peter S. Gordon
PETER S. GORDON P.L.S. 2101

- WORK ORDERED BY -
CHICAGO TITLE INSURANCE CO.

FARRIS, HANSEN & ASSOCIATES, INC.

PROJECT	DATE	SHEET
	11	

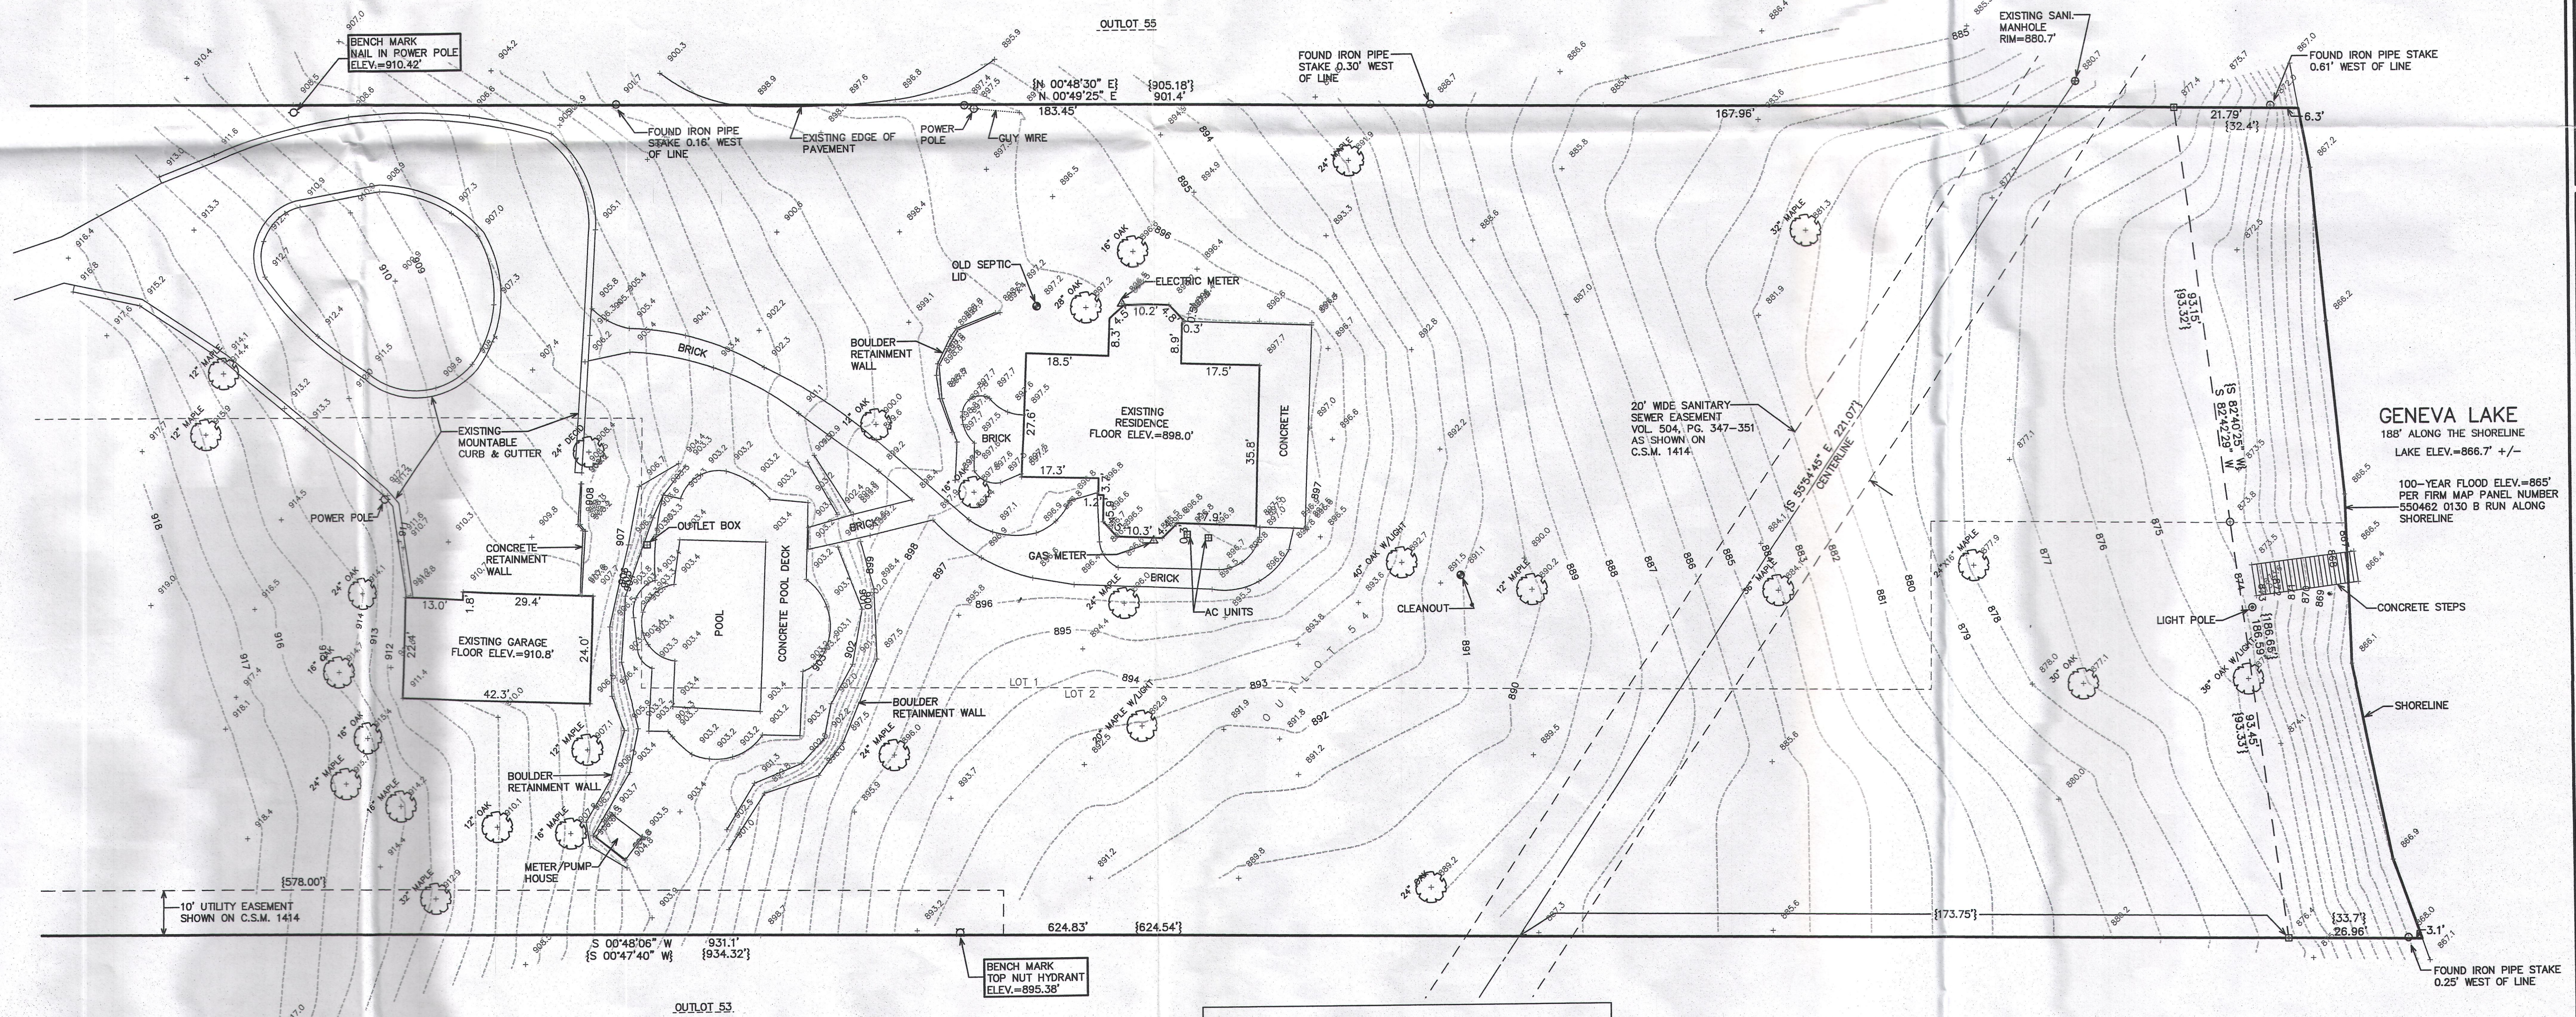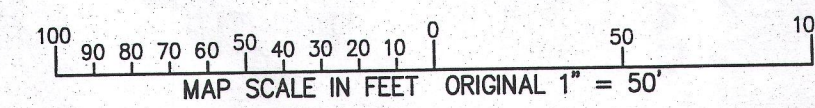

NOTE:
TOPOGRAPHIC MAPPING FROM 2007 WORK
NOT VERIFIED AS PART OF THE 2015 RESURVEY

