# PLAT OF SURVEY


## OF

LOT J5 OF

COUNTRY CLUB ESTATES

ADDITION "J"; FONTANA-ON-GENEVA LAKE

WALWORTH COUNTY, WISCONSIN

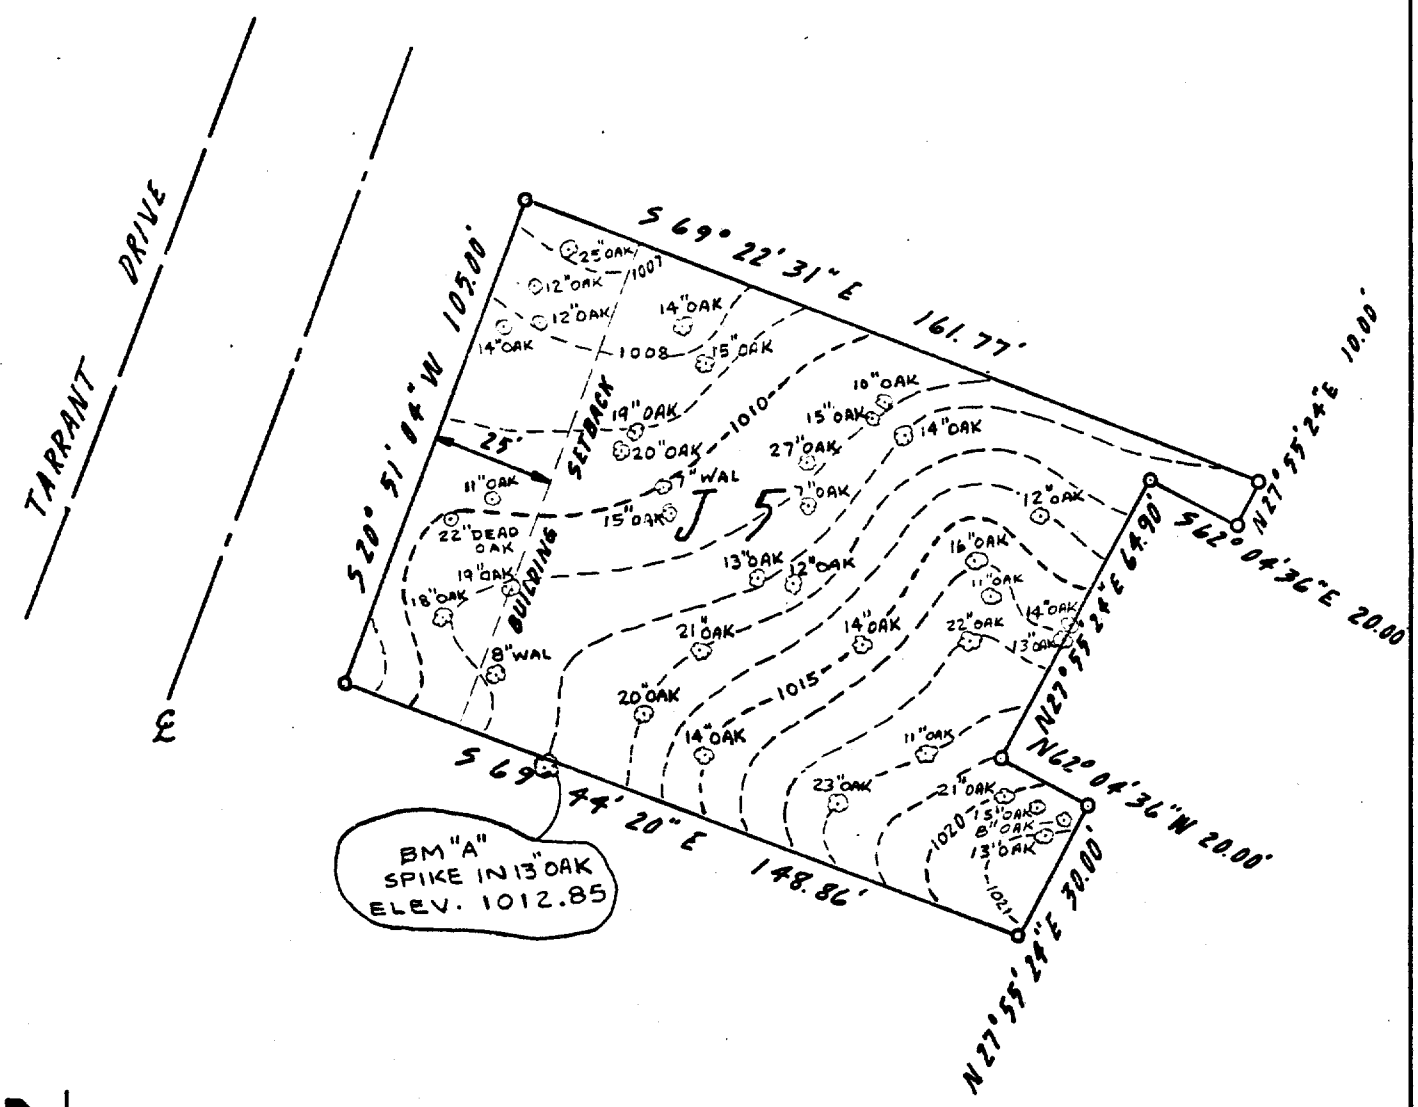


N

WISCONSIN
LLOYD L. JENSEN
S-211
ELKHORN, W.S.
LAND SURVEYOR

**LEGEND**

- O — Iron Pipe
- ● — Concrete Monument

Scale 1" = 40'

**SURVEY AND PLAT BY**

## JENSEN & JOHNSON, INC.

**CIVIL ENGINEERS AND SURVEYORS**

**Elkhorn, Wisconsin**

**WE CERTIFY:** That we have surveyed the above described property and that the plat shown hereon is an accurate survey and a true representation thereof and correctly shows the exterior boundary lines and all divisions of said property.

**Date** MAY 1973

Lloyd L. Jensen

LLOYD L. JENSEN,

Wisconsin Registered Land Surveyor, No. S-211

SCTJ-5

PRINT 178H

5-334