
PLAT OF SURVEY

OF LOT 38 OF PHEASANT RIDGE, A SUBDIVISION BEING PART OF THE SE 1/4 OF THE NE 1/4 OF SECTION 23, T. 1 N., R. 16 E., OF THE 4TH P.M., VILLAGE OF FONTANA-ON-GENEVA LAKE, WALWORTH COUNTY, WISCONSIN.

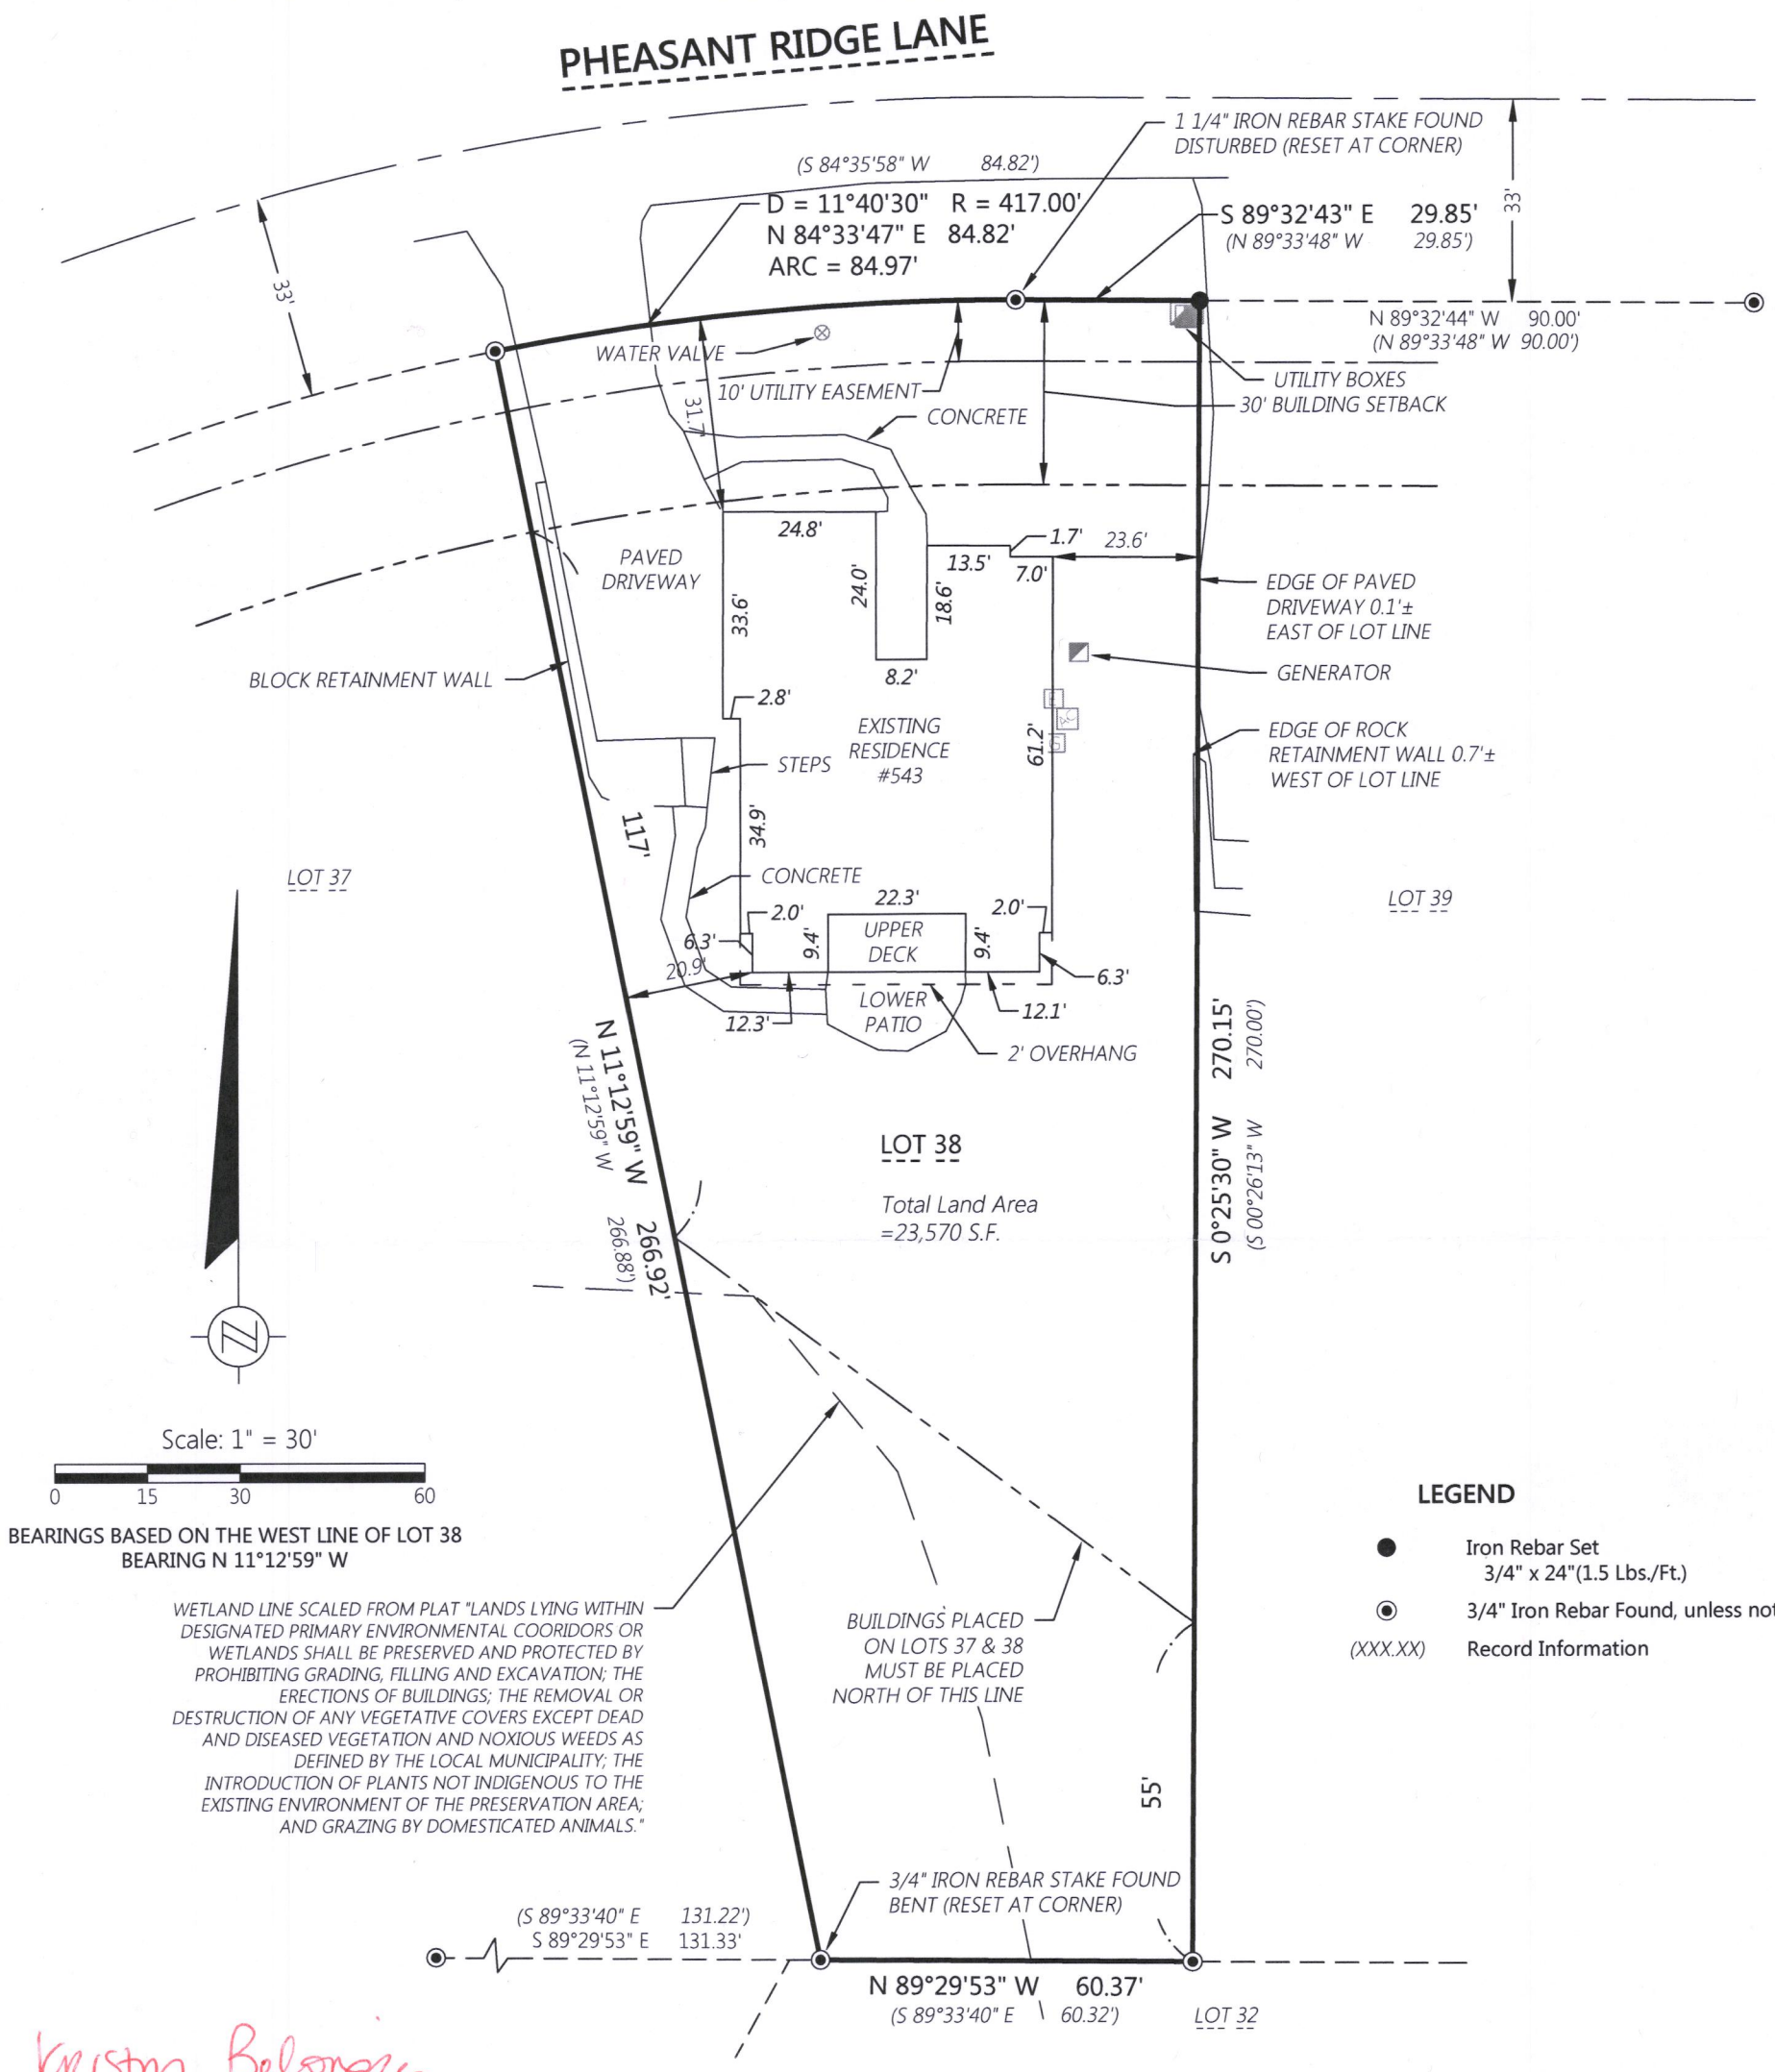

Kristin Belongia

Kristin J. Belongia, P.L.S.
Wisconsin Professional Land Surveyor S-2943

State of Wisconsin } ss
County of Rock }

If the surveyor's signature is not red in color, the plan is a copy that should be assumed to contain unauthorized alterations.
The certification contained on this document shall not apply to any copies.

I hereby certify that I have supervised the survey of the property described above and to the best my knowledge and belief, the plat drawn hereon correctly represents the size and location of the property, exterior boundaries, the location of all visible structures, and dimensions of all principle buildings thereon, fences, easements of record, and roadways, if any. This survey is made for the use of the present owners of the property, and also those who purchase, mortgage, or guarantee the title thereto within one year from the date hereof.
Given under my hand and seal this 30th day of November, 2017 at Beloit, Wisconsin.
Last day of field work November 28th, 2017

WISCONSIN
KRISTIN J. BELONGIA
S-2943
DELAVAN WIS.
LAND SURVEYOR

RECEIVED
DEC 14 2017
By Jan

ORDER NO: 32873 BOOK: 572/50 FIELD CREW: RHL DRAWN BY: KJB DATE: November 29, 2017	*FOR THE EXCLUSIVE USE OF:* Thre Rauland Agency, Inc. 118 Kenosha St. Walworth, WI 53184	**PLAT OF SURVEY**	**Batterman** engineers surveyors planners 2857 Bartells Drive Beloit, Wisconsin 53511 608.365.4464 www.rhbatterman.com

File Name: I:\32800-32899\32873 - The Rauland Agency - 543 Pheasant Ridge\SURVEY\RHB DRAWING FILES

SPHR-38 005-3377