
PLAT OF SURVEY

OF

THE SOUTH 112 FEET OF LOT 5 OF ADDITION B TO COUNTRY CLUB ESTATES WALWORTH Co. Wis.

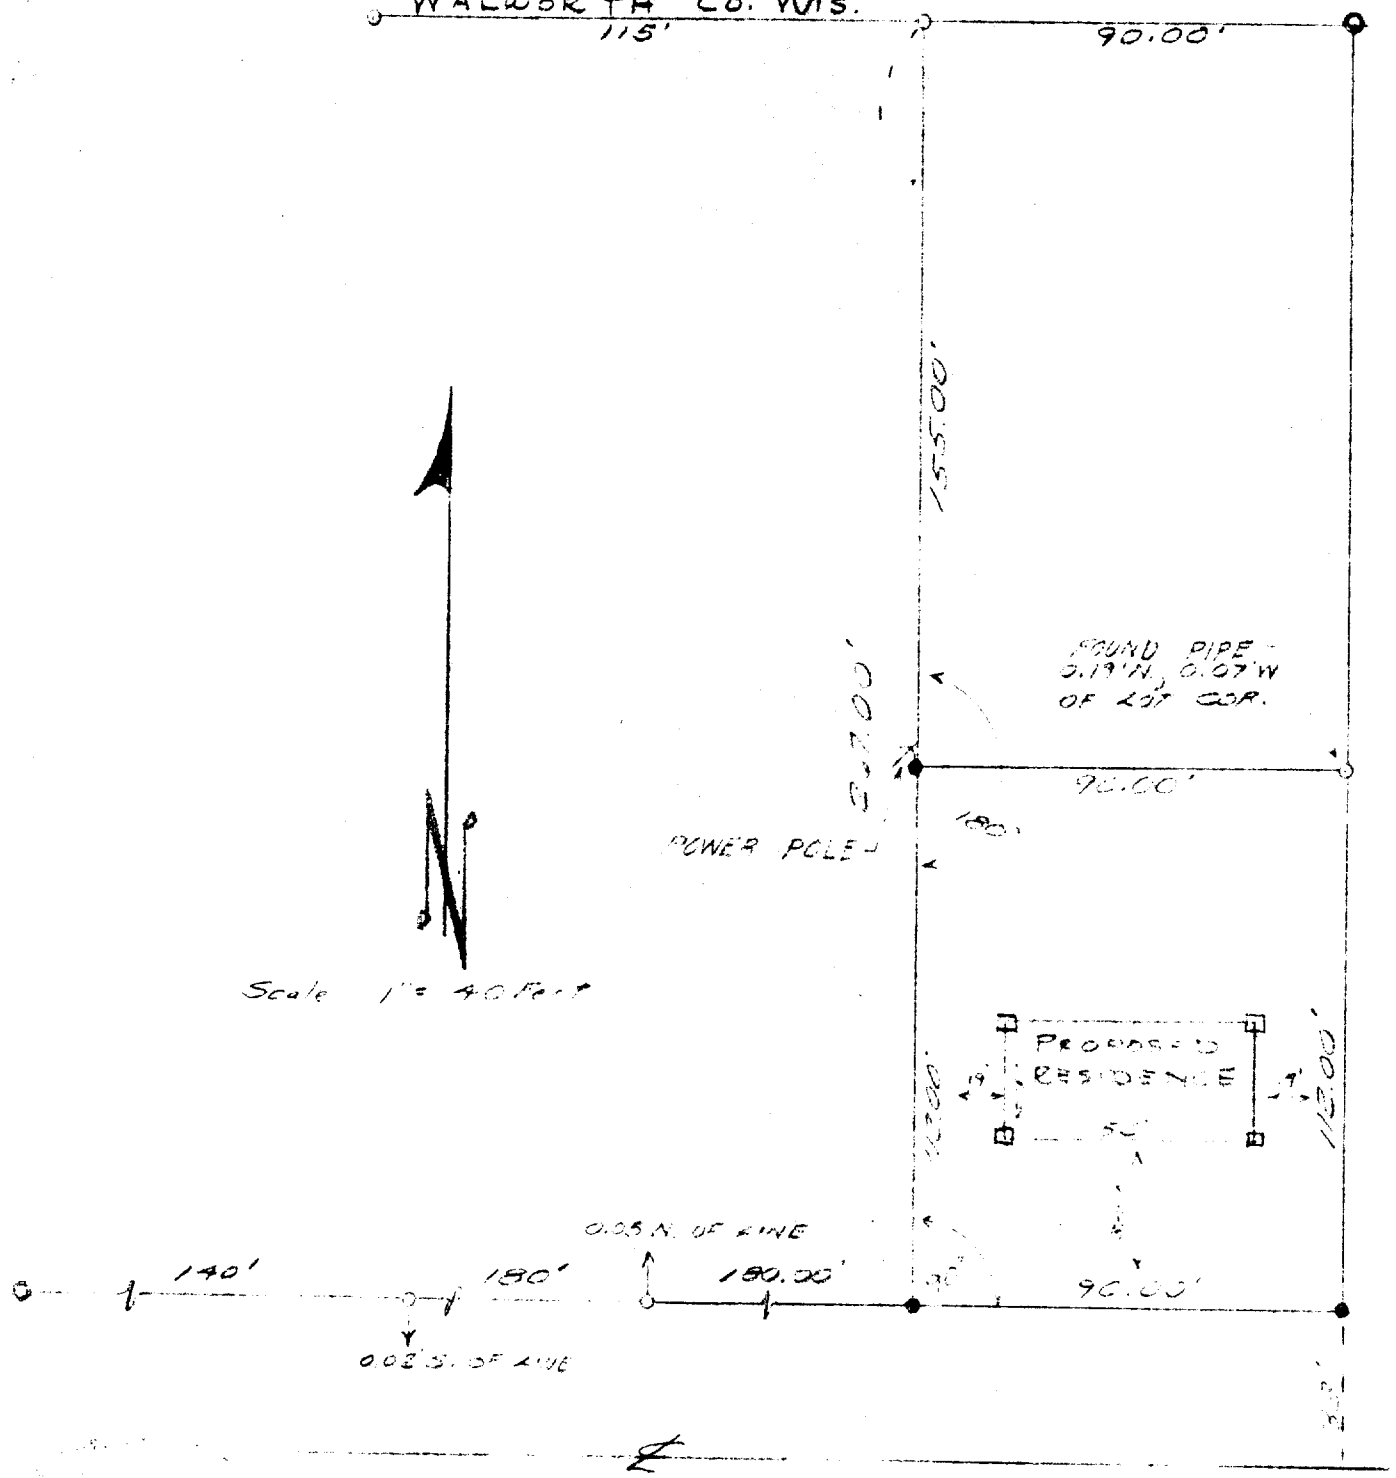

Scale 1" = 40 Feet

LEGEND

O — Iron Pipe Found 1"

~~Concrete Monument~~

Scale 1" = 40'

● - 0.72"x24" ROUND IRON ROD SET

⊙ - Found Pipe 2"

□ - Wood Stake

SURVEY AND PLAT BY

JENSEN & JOHNSON, INC.

CIVIL ENGINEERS AND SURVEYORS

Elkhorn, Wisconsin

WE CERTIFY: That we have surveyed the above described property and that the plat shown hereon is an accurate survey and a true representation thereof and correctly shows the exterior boundary lines and all divisions of said property.

Date 10 OCT 1973

Lloyd L. Jensen

LLOYD L. JENSEN,

Wisconsin Registered Land Surveyor, No. S-211

SCTB-6

5-35 & J