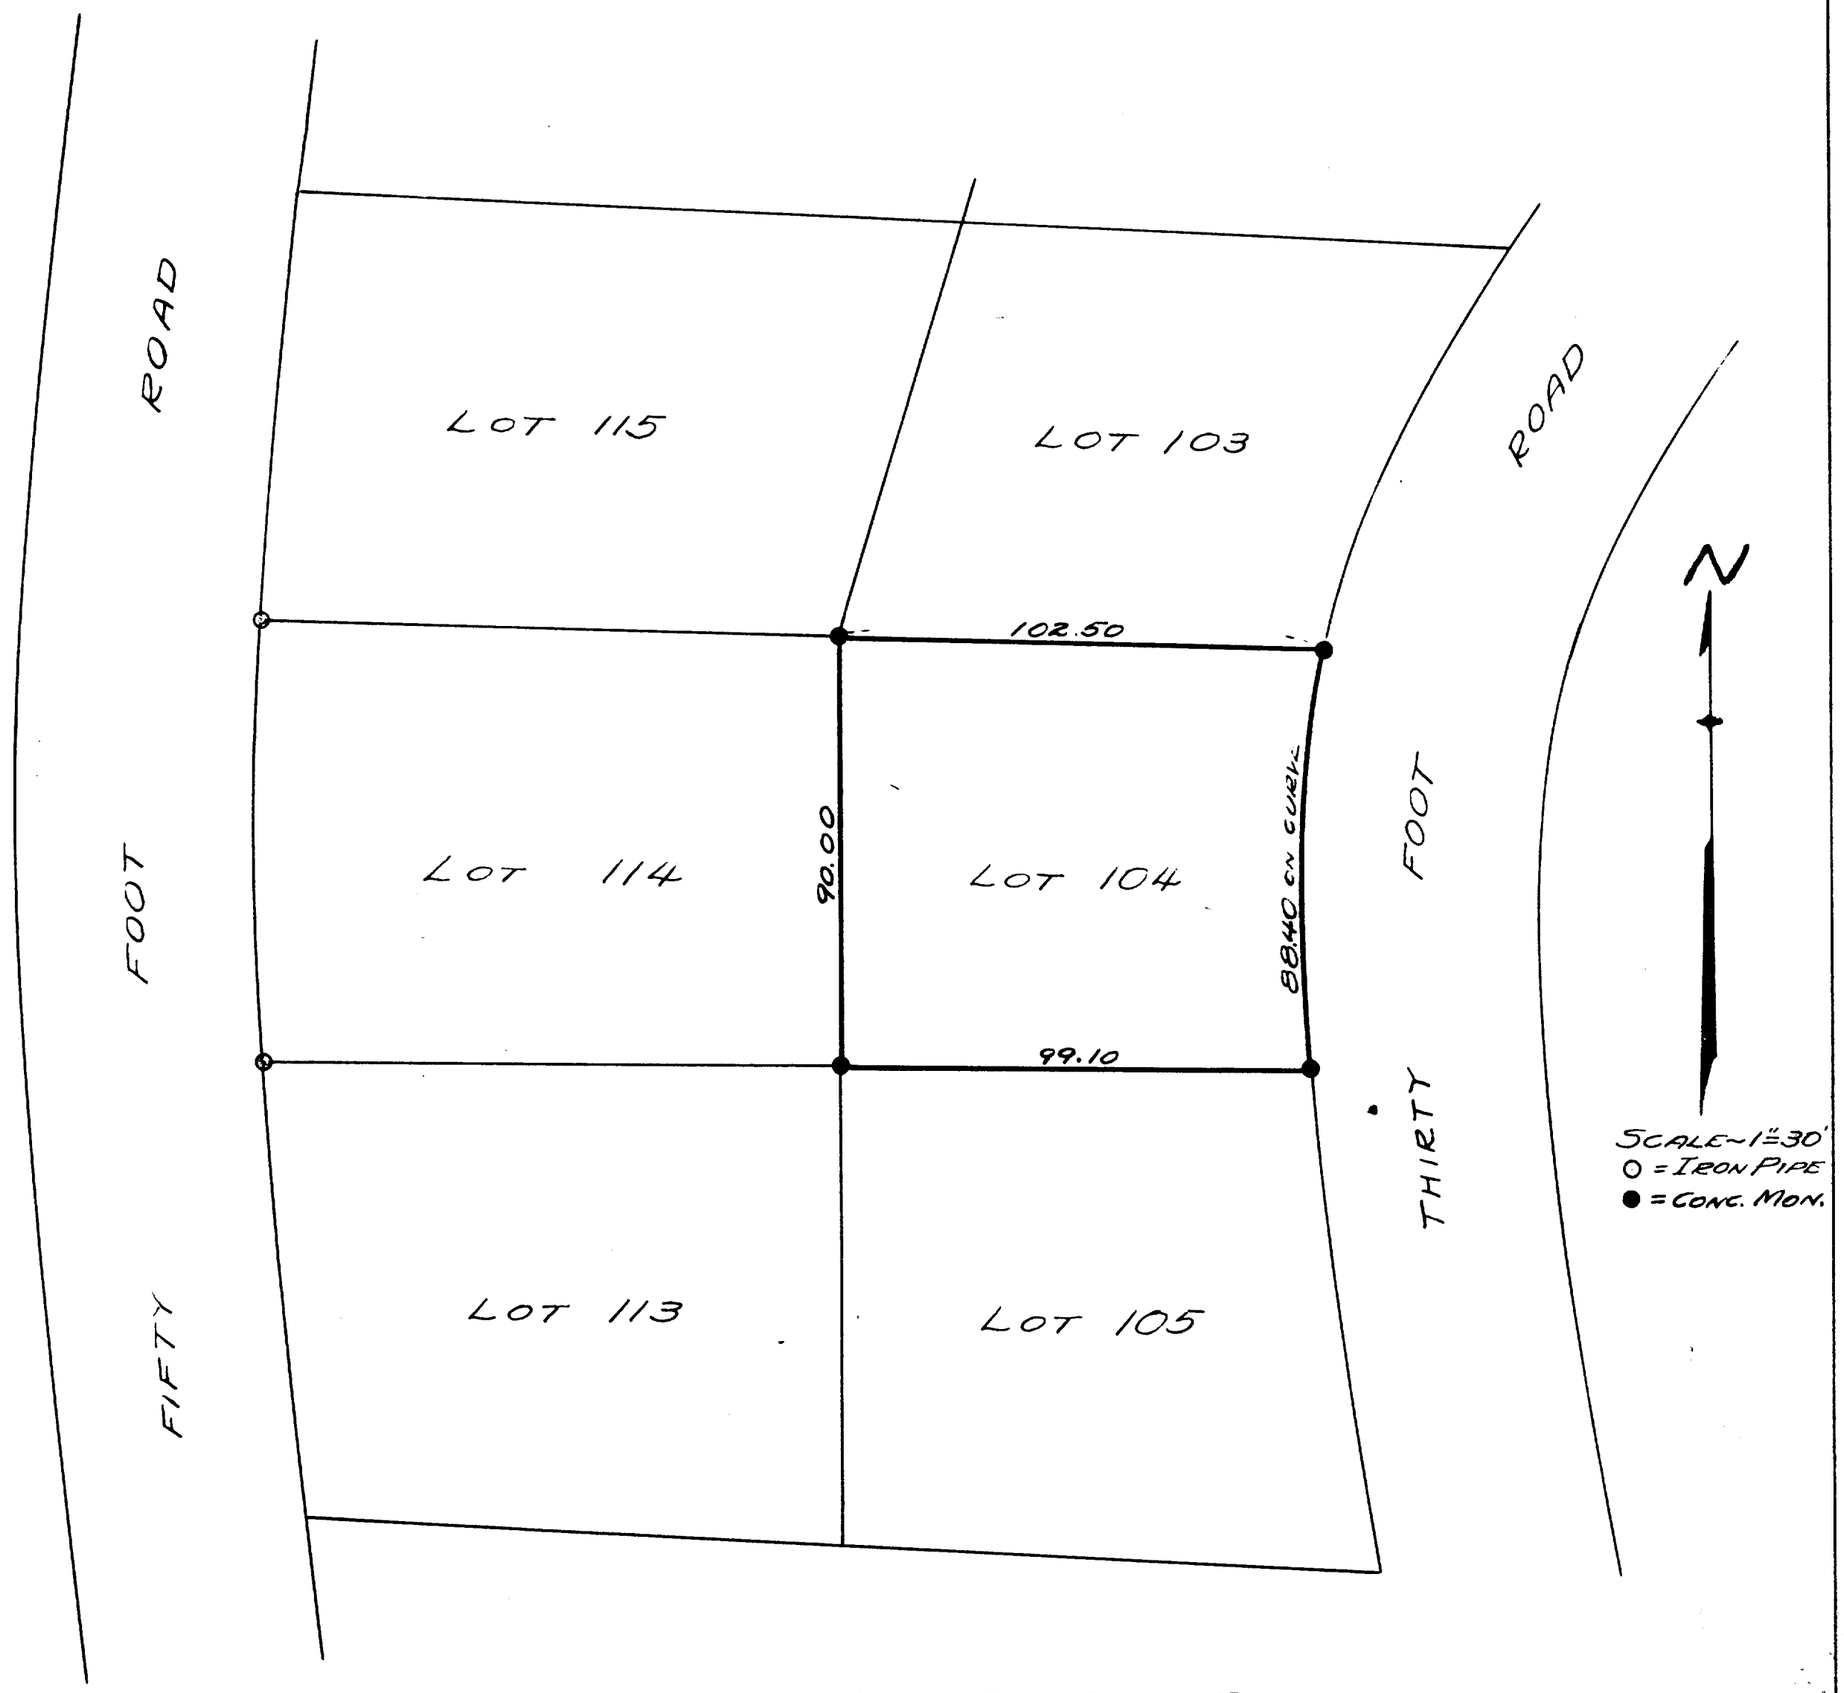

PLAT OF SURVEY OF LOT 104 OF UNIT 2 OF COUNTRY CLUB ESTATES, A SUBDIVISION LOCATED IN SECTIONS 14 AND 23 T1N, R16E OF WALWORTH COUNTY, WISCONSIN.

SEPT., 1946

H. E. Johnson
SURVEYOR

SC02-98

5-35 J