
HAROLD H. KOLB

REGISTERED PROFESSIONAL LAND SURVEYOR
LAKE GENEVA, WISCONSIN

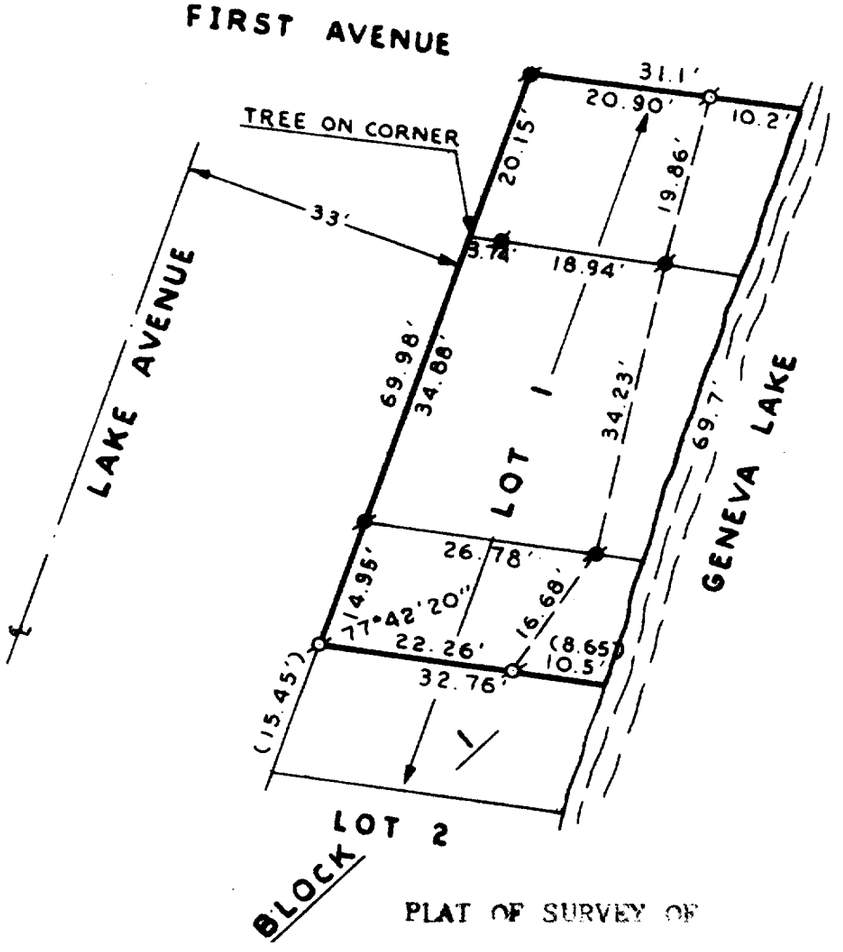

N

SCALE: 1"=20'

PLAT OF SURVEY OF

Part of Lot 1, Block 1, D. A. Reid's Addition to Reid's Park, Village of Fontana-on-Geneva Lake, Walworth County, Wisconsin.

LEGEND

- ϕ — IRON PIPE FOUND
- O — IRON PIPE PLACED
- ⌀ — CONCRETE MONUMENT Found
- x — SPIKE
- ( ) — As Platted

HAROLD H KOLB S-187 LAKE GENEVA WIS. LAND SUR...

I, **HAROLD H. KOLB**, DO HEREBY CERTIFY THAT I HAVE SURVEYED THE PROPERTY HEREON DESCRIBED ACCORDING TO THE OFFICIAL RECORDS, AND THAT THE PLAT HEREON IS A CORRECT REPRESENTATION OF THE LOT LINES.

Harold H. Kolb

HAROLD H. KOLB
WISCONSIN REGISTERED LAND SURVEYOR, S-187
DATE December 28, 1973

5-364

BRUNING 40-105 1M-6-71