
# PLAT OF SURVEY – PERMIT
## UNIT 89 OF ABBEY SPRINGS CONDOMINIUM NO. 3

LOCATED IN PART OF THE SE 1/4 OF THE SE 1/4
OF SECTION 13, TOWN 1 NORTH, RANGE 16 EAST,
VILLAGE OF FONTANA–ON–GENEVA LAKE, WALWORTH COUNTY, WISCONSIN

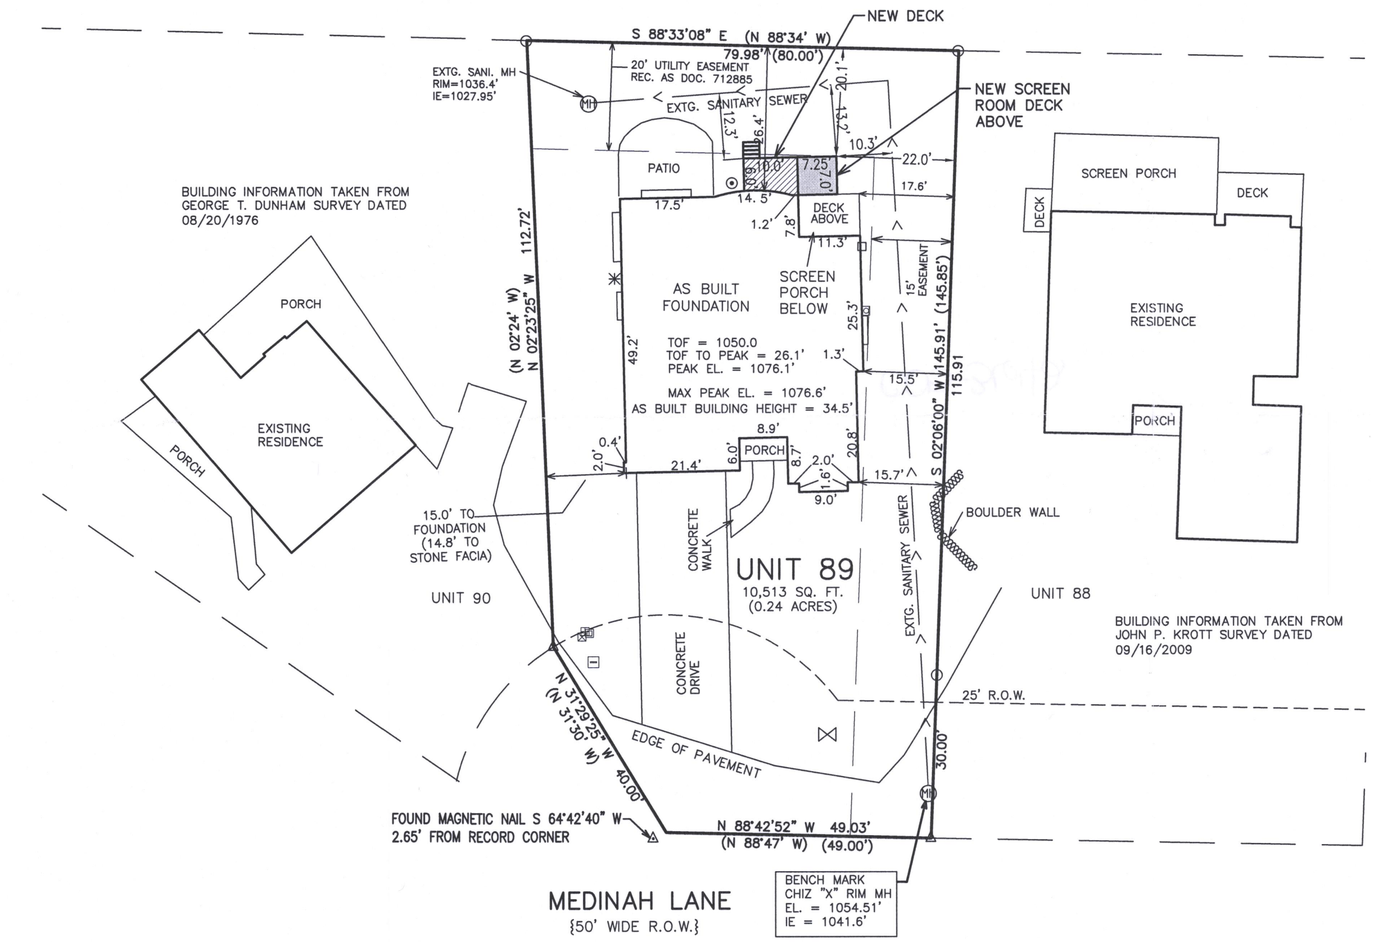


EASEMENTS ARE BASED UPON TITLE POLICY
429111 CHICAGO TITLE CO. DATED 5–28–2008

LEGEND

- △ = FOUND MAGNETIC NAIL
- ○ = FOUND IRON PIPE STAKE
- ✳ = AIR CONDITIONING UNIT
- ⊟ = ELECTRIC TRANSFORMER
- ⧈ = CABLE BOX
- ⊞ = ELECTRIC BOX
- ⊠ = TELEPHONE BOX
- ⋈ = WATER VALVE
- ⊙ = CLEAN OUT
- □ = ELECTRIC METER
- ⧇ = GAS METER
- (MH) = SANITARY SEWER MANHOLE
- {XXX} = RECORDED AS

RECEIVED
OCT 26 2021
By

NOTE: COPIES OF THIS MAP TO WHICH THE FOLLOWING CERTIFICATE WILL APPLY SHOW THE SURVEYOR'S ORIGINAL SEAL AND SIGNATURE IN RED INK. COPIES BY ANY OTHER MEANS MAY HAVE ALTERATIONS WHICH DO NOT REPRESENT THE SURVEYOR'S WORK PRODUCT.

I HEREBY CERTIFY THAT THE ABOVE DESCRIBED PROPERTY HAS BEEN SURVEYED UNDER MY DIRECTION AND THAT THE ABOVE MAP IS A TRUE REPRESENTATION THEREOF AND SHOWS THE SIZE AND LOCATION OF THE PROPERTY AND ITS EXTERIOR BOUNDARIES. THIS SURVEY IS MADE FOR THE USE OF THE PRESENT OWNERS OF THE PROPERTY, AND ALSO THOSE WHO PURCHASE, MORTGAGE, OR GUARANTEE THE TITLE THERETO WITHIN ONE YEAR FROM THE DATE HEREOF.

WISCONSIN
CHRISTOPHER A HODGES
2760
PALMYRA
WIS.
LAND SURVEYOR

DATED: 9/21/21

CHRISTOPHER A. HODGES P.L.S. 2760

**PERMIT PLAT**
89 MEDINAH LANE
FONTANA, WI 53125

– WORK ORDERED BY –
MARY & BRIAN COOK
750 N. HUDSON AVE. UNIT 412
CHICAGO, IL 60654


FARRIS, HANSEN & ASSOCIATES, INC.
ENGINEERING – ARCHITECTURE – SURVEYING
7 RIDGWAY COURT P.O. BOX 437
ELKHORN, WISCONSIN 53121
OFFICE: (262) 723–2098 FAX: (262) 723–5886


REVISIONS
- 03/20/2019 RESURVEYED
- 12/31/2019 – LB PERMIT
- 01/10/2020 – LB UPDATE
- 02/04/2020 – LB UPDATE
- 09/20/2021 – TS REVISE DECK

PROJECT NO. 6743.20
DATE: 03/10/2005
SHEET NO. 1 OF 1

X:\PROJECTS\6743\6743_20\ACAD\6743-20.DWG

SCDB 3-89

005-3669