
# PLAT OF SURVEY
## UNIT 591 OF ABBEY SPRINGS CONDOMINIUM NO. 13
LOCATED IN THE SOUTHEAST 1/4 OF SECTION 13, TOWN 1 NORTH, RANGE 16 EAST,
WALWORTH COUNTY, WISCONSIN

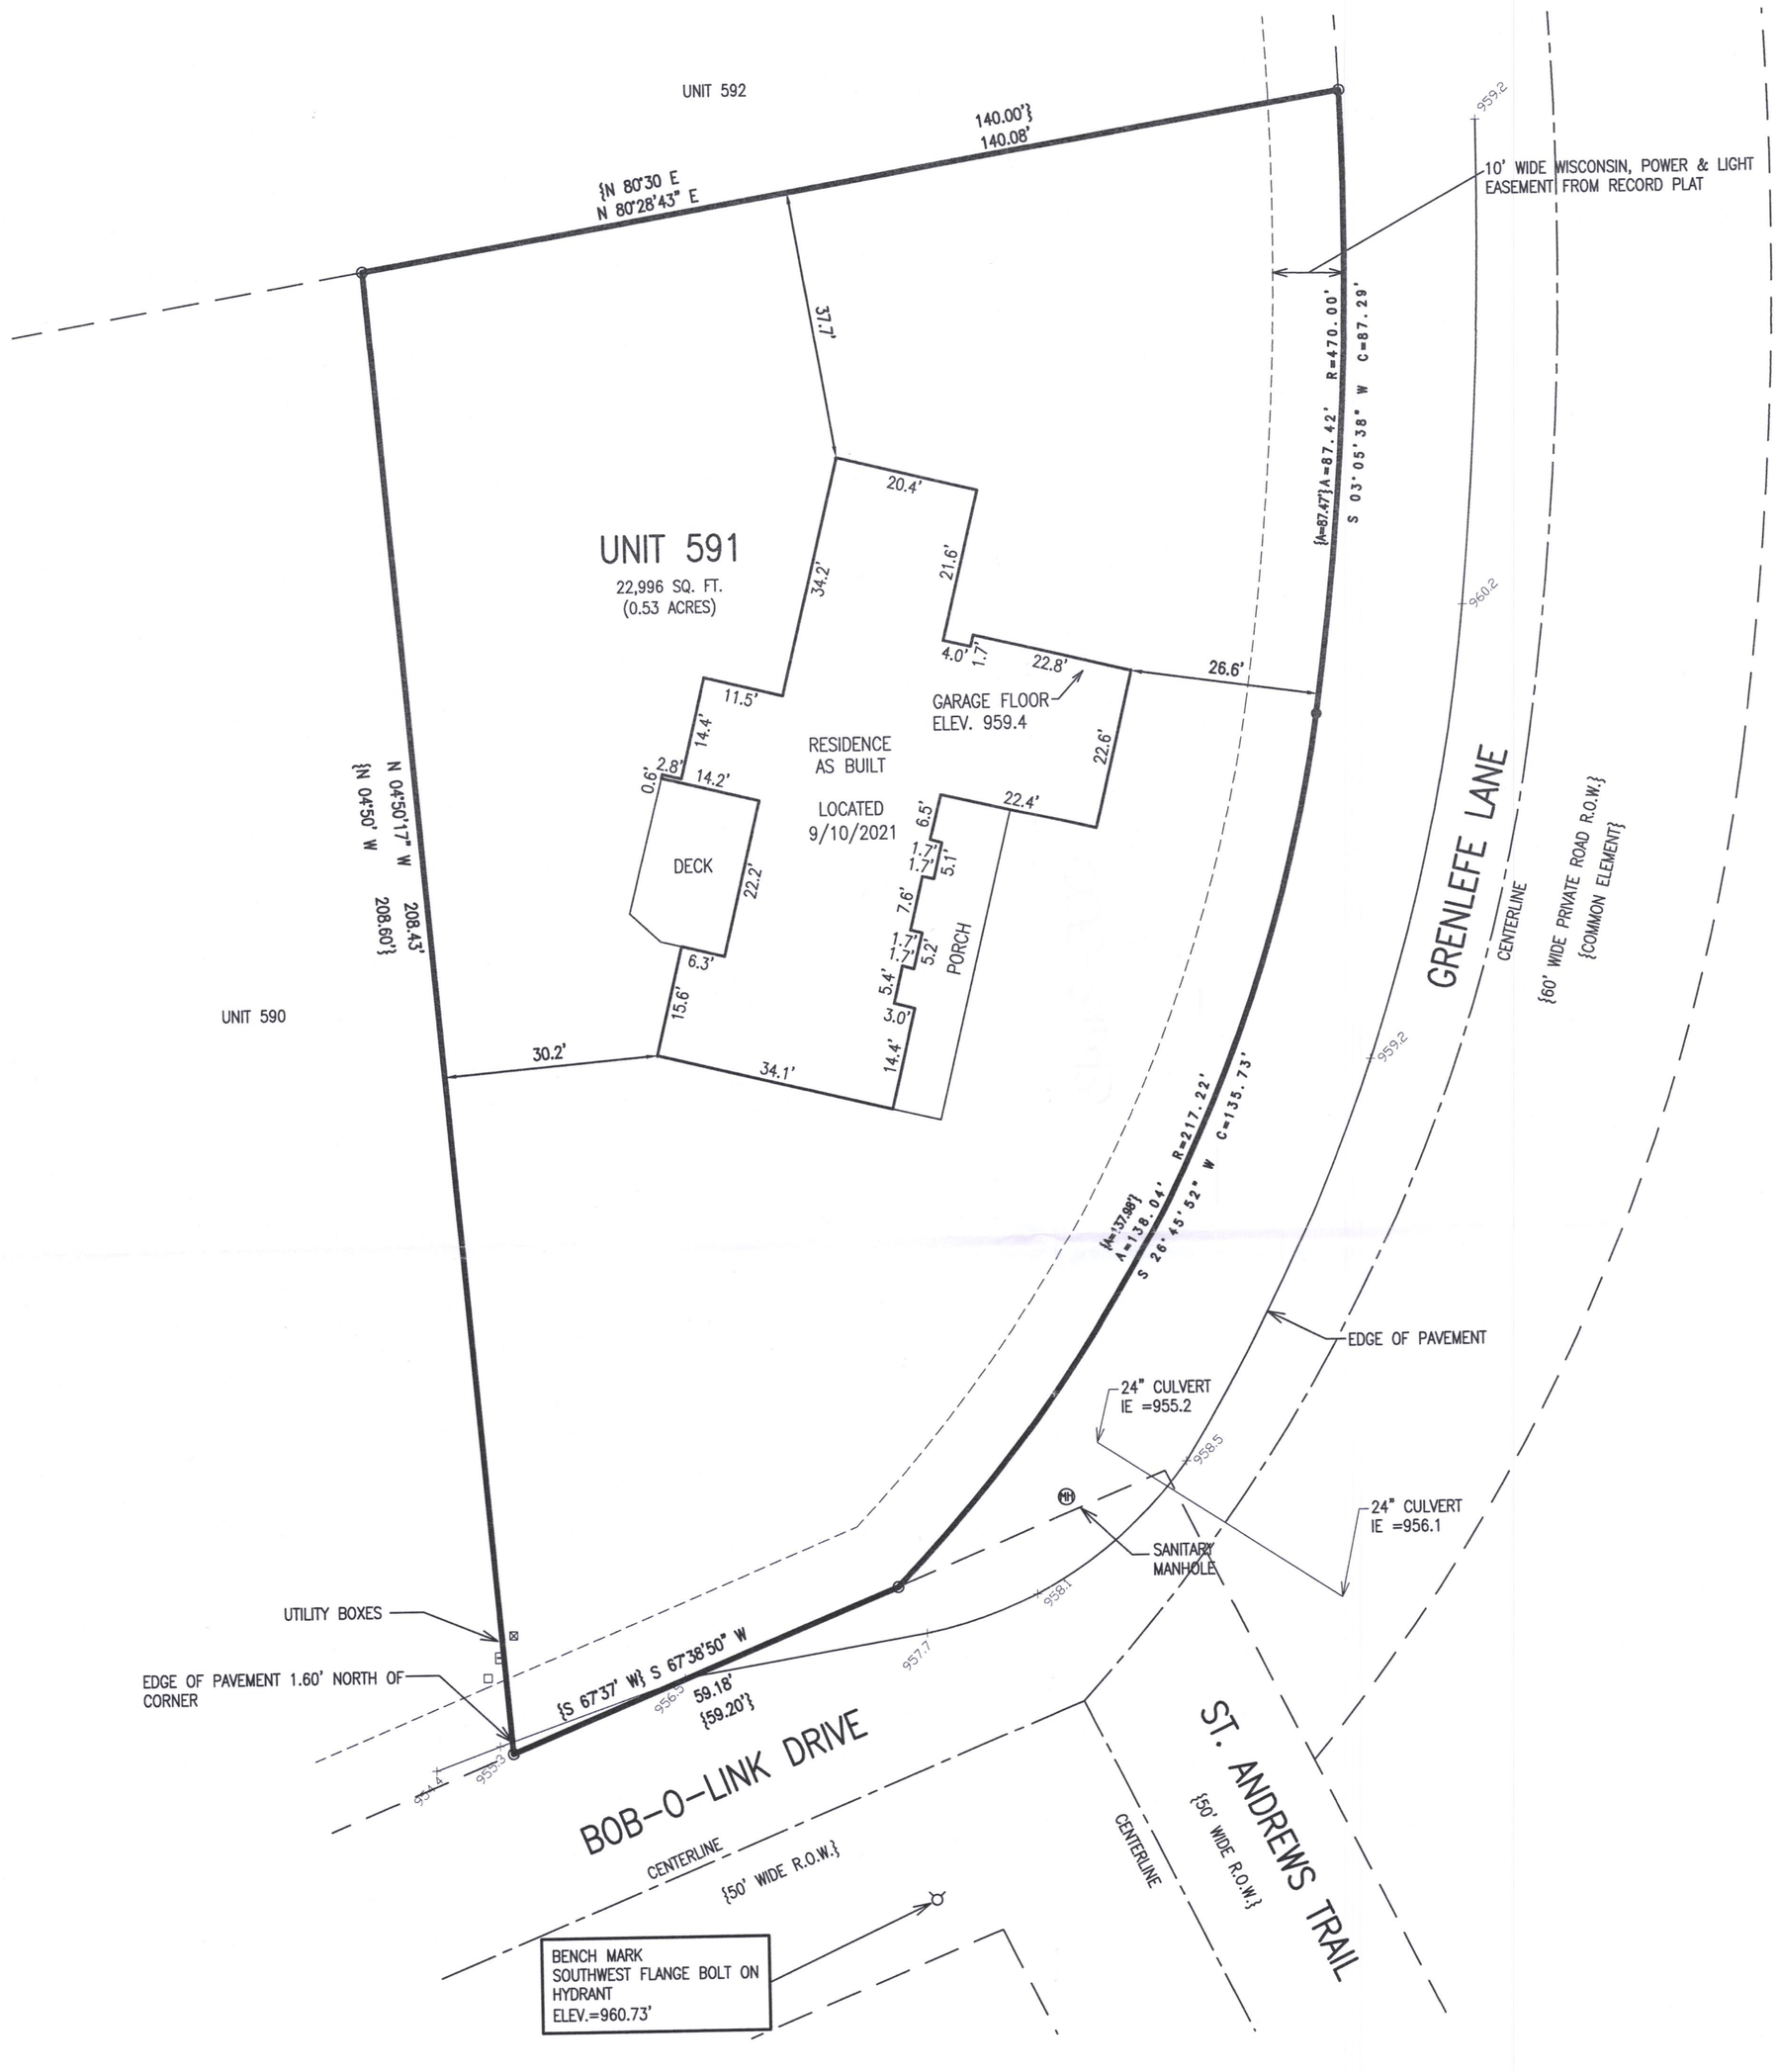


NOTE: COPIES OF THIS MAP TO WHICH THE FOLLOWING CERTIFICATE WILL APPLY SHOW THE SURVEYOR'S ORIGINAL SEAL AND SIGNATURE IN RED INK. COPIES BY ANY OTHER MEANS MAY HAVE ALTERATIONS WHICH DO NOT REPRESENT THE SURVEYOR'S WORK PRODUCT.

I HEREBY CERTIFY THAT THE ABOVE DESCRIBED PROPERTY HAS BEEN SURVEYED UNDER MY DIRECTION AND THAT THE ABOVE MAP IS A TRUE REPRESENTATION THEREOF AND SHOWS THE SIZE AND LOCATION OF THE PROPERTY AND ITS EXTERIOR BOUNDARIES. THIS SURVEY IS MADE FOR THE USE OF THE PRESENT OWNERS OF THE PROPERTY, AND ALSO THOSE WHO PURCHASE, MORTGAGE, OR GUARANTEE THE TITLE THERETO WITHIN ONE YEAR FROM THE DATE HEREOF.

DATED: 4/29/2021

REVISED 10/14/2021 TO SHOW RESIDENCE AS BUILT.

WISCONSIN
CHRISTOPHER A HODGES
2760
PALMYRA
WIS.
LAND SURVEYOR

CHRISTOPHER A. HODGES P.L.S. S-2760

RECEIVED
OCT 26 2021
By SMF

**LEGEND**
○ = FOUND IRON PIPE STAKE
{XXX} = RECORDED AS

WEST LINE OF UNIT 591 BEARS N 04°50'17" W PER SURVEY OF RECORD

20 10 0 20 40 60 80
MAP SCALE IN FEET – ORIGINAL 1"=20'

**PLAT OF SURVEY**
SITE, GRADING, DRAINAGE, & EROSION CONTROL PLAN


**FARRIS, HANSEN & ASSOCIATES, INC.**
ENGINEERING – ARCHITECTURE – SURVEYING
7 RIDGWAY COURT P.O. BOX 437
ELKHORN, WISCONSIN 53121
OFFICE: (262) 723-2098 FAX: (262) 723-5886


– WORK ORDERED BY –
ED SALOGA
448 COURTNEY CIR
SUGAR GROVE, IL 60554

REVISIONS

PROJECT NO. 9467.21
DATE: 02/26/2021
SHEET NO. 1 OF 1

X:\Projects\9467\9467_21\ACAD\9467.21.dwg

SCDB13-591

005-3643