PLAT OF SURVEY WITH TOPOGRAPHIC MAPPING
THE SOUTH 90' OF LOT 1, BLOCK 1, INDIAN HILLS SUBDIVISION

LOCATED IN PART OF THE NE 1/4 OF THE SE 1/4 OF SECTION 14, TOWN 1 NORTH, RANGE 16 EAST,
VILLAGE OF FONTANA-ON-GENEVA LAKE, WALWORTH COUNTY, WISCONSIN

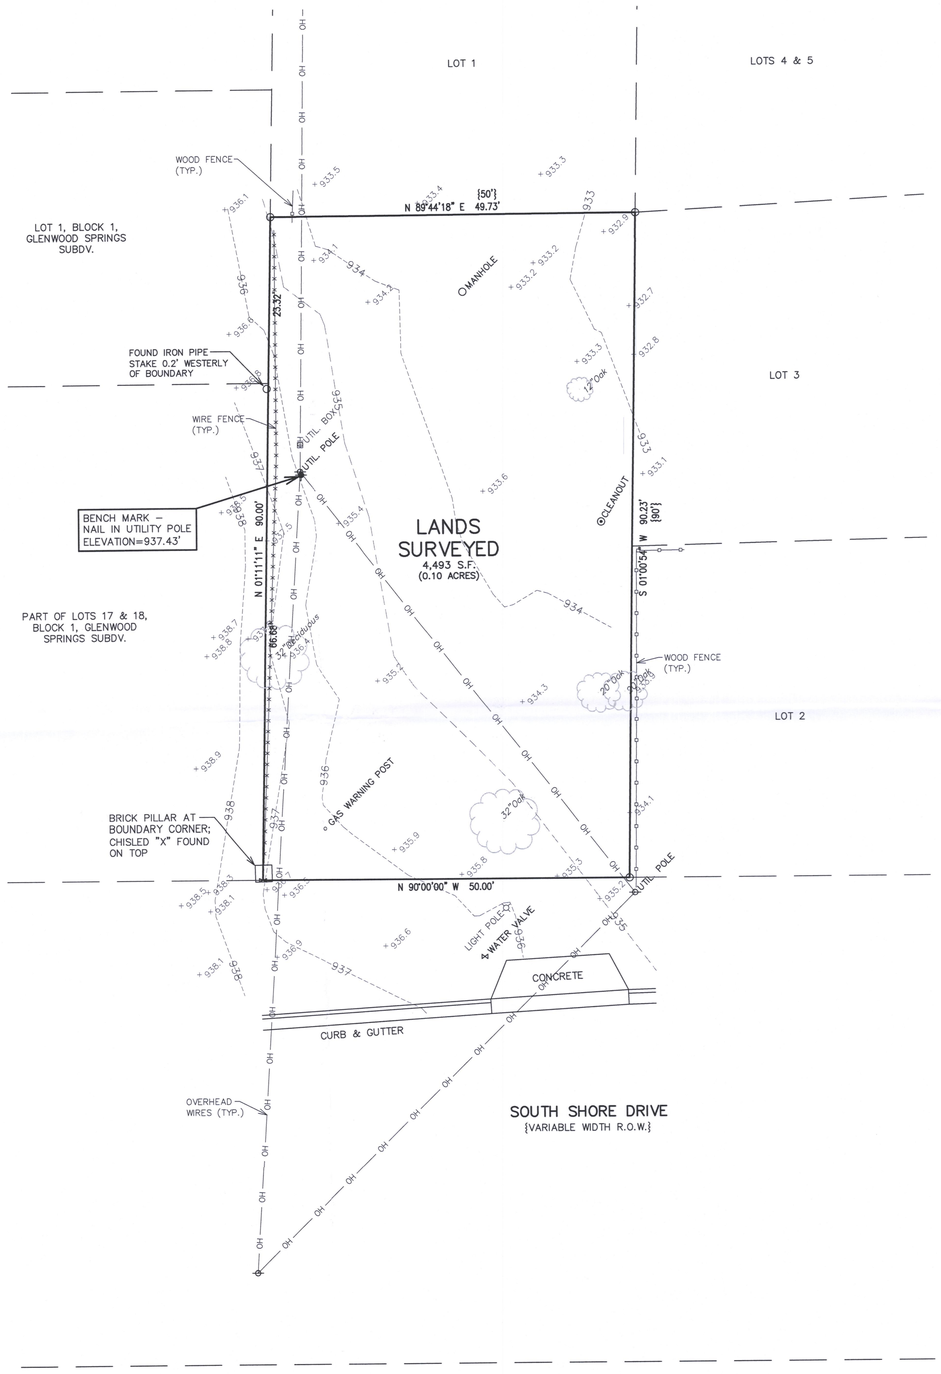

LEGEND
○ = FOUND IRON PIPE STAKE
⋈ = FOUND CHISLED "X"
{XXX} = RECORDED AS

MAP SCALE IN FEET - ORIGINAL 1"=10'

RECEIVED JAN - 7 2021 BY: SMF

NOTE: COPIES OF THIS MAP TO WHICH THE FOLLOWING CERTIFICATE WILL APPLY SHOW THE SURVEYOR'S ORIGINAL SEAL AND SIGNATURE IN RED INK. COPIES BY ANY OTHER MEANS MAY HAVE ALTERATIONS WHICH DO NOT REPRESENT THE SURVEYOR'S WORK PRODUCT.

I HEREBY CERTIFY THAT THE ABOVE DESCRIBED PROPERTY HAS BEEN SURVEYED UNDER MY DIRECTION AND THAT THE ABOVE MAP IS A TRUE REPRESENTATION THEREOF AND SHOWS THE SIZE AND LOCATION OF THE PROPERTY AND ITS EXTERIOR BOUNDARIES. THIS SURVEY IS MADE FOR THE USE OF THE PRESENT OWNERS OF THE PROPERTY, AND ALSO THOSE WHO PURCHASE, MORTGAGE, OR GUARANTEE THE TITLE THERETO WITHIN ONE YEAR FROM THE DATE HEREOF.

WISCONSIN CHRISTOPHER A. HODGES S-2760 PALMYRA WIS. LAND SURVEYOR

DATED: 9/1/2021

CHRISTOPHER A. HODGES P.L.S. S-2760

PLAT OF SURVEY WITH TOPO
S. 90' LOT 1 BLK. 1 INDIAN HILLS SUBD.
510 SOUTH SHORE DRIVE
FONTANA, WI 53125

- WORK ORDERED BY -
KARL RUSS
971 TURNING POINT LANE
MAINEVILLE, OH 45039

FARRIS, HANSEN & ASSOCIATES, INC.
ENGINEERING - ARCHITECTURE - SURVEYING
7 RIDGWAY COURT P.O. BOX 437
ELKHORN, WISCONSIN 53121
OFFICE: (262) 723-2098 FAX: (262) 723-5886

REVISIONS

PROJECT NO. 10060.21
DATE 09/01/2021
SHEET NO. 1 OF 1

X:\PROJECTS\10060\ACAD\10060 SQDECP.dwg

SIH-2

005-3653