
PLAT OF SURVEY

OF

LOT 2, BLOCK 6, D.A. REID'S ADDITION TO REID'S PARK, VILLAGE OF FONTANA-ON-GENEVA LAKE, WALWORTH COUNTY, WISCONSIN.

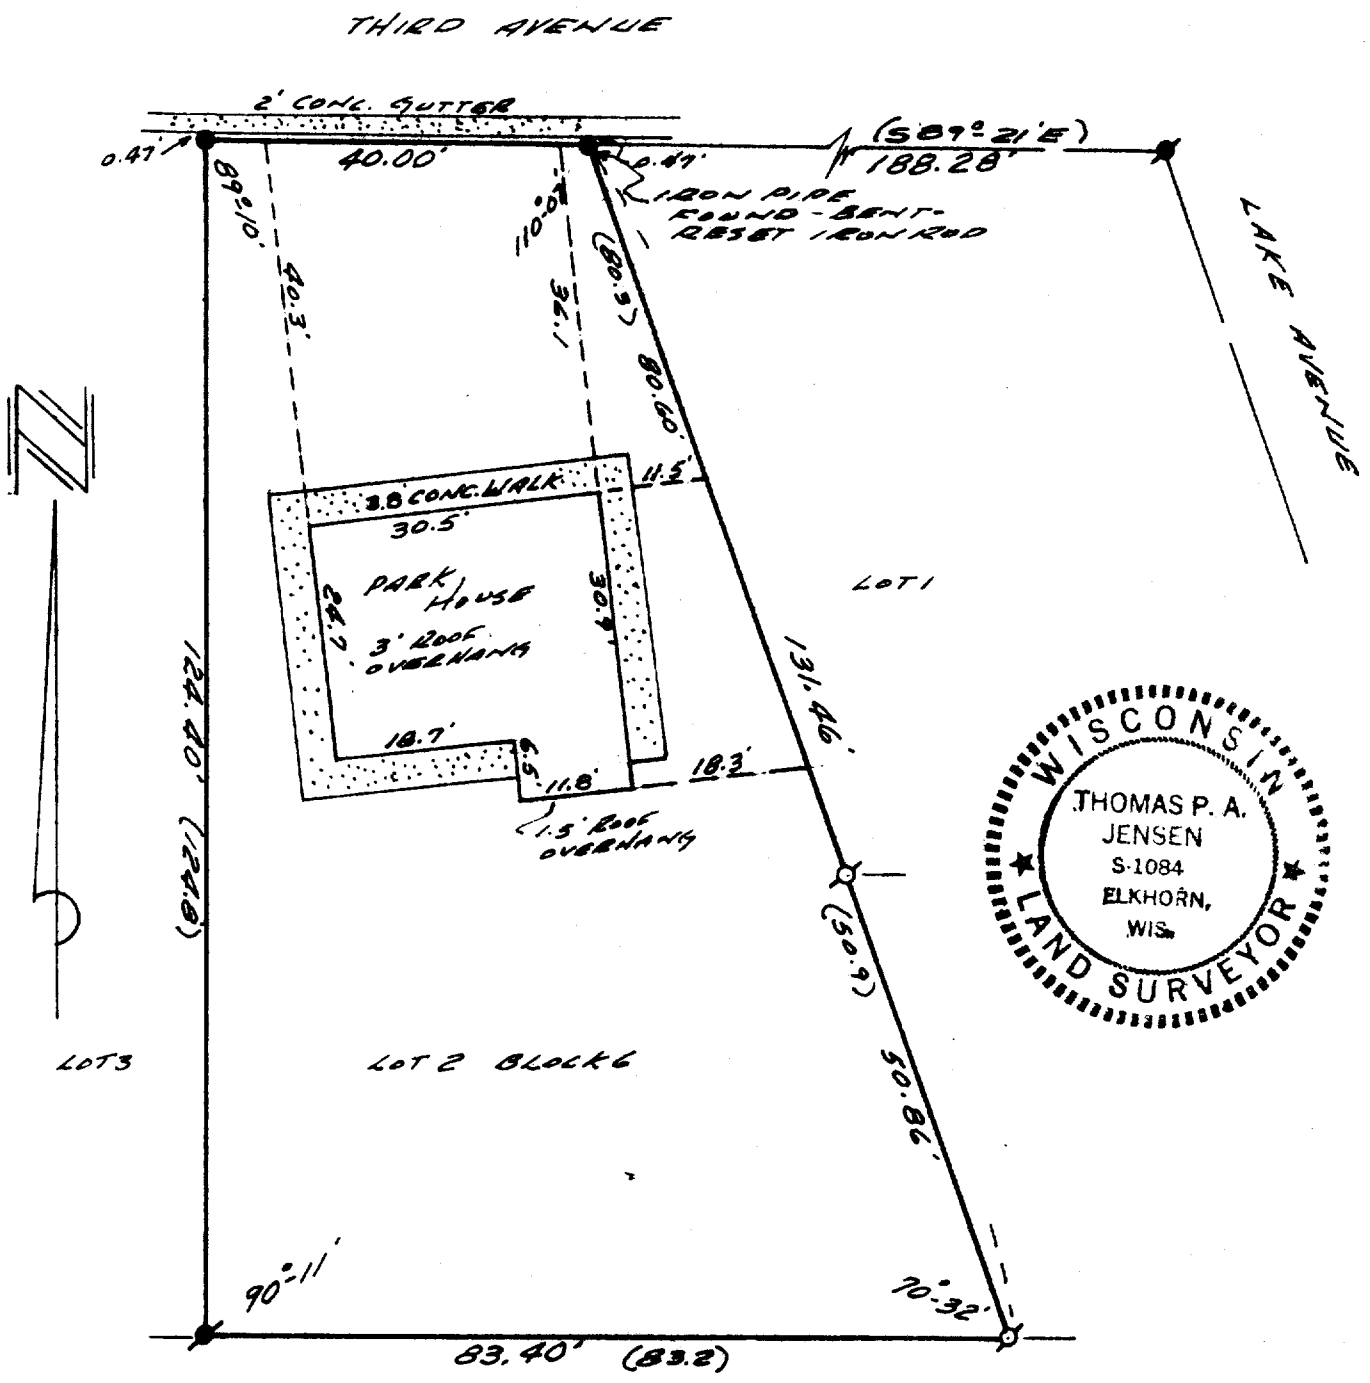

WISCONSIN
THOMAS P. A. JENSEN
S-1084
ELKHORN, WIS.
LAND SURVEYOR

SURVEY AND PLAT BY

JENSEN & JOHNSON, INC.

CIVIL ENGINEERS AND SURVEYORS

Elkhorn, Wisconsin

LEGEND

- ○— Iron Pipe FOUND
- ■— Concrete Monument FOUND
- Scale 1" = 20'
- ● ~ IRON ROD SET
- ( ).— PLATTED DISTANCE

WE CERTIFY: That we have surveyed the above described property and that the plat shown hereon is an accurate survey and a true representation thereof and correctly shows the exterior boundary lines and all divisions of said property, AND ALL BUILDINGS THEREON.

Date MAY 14, 1974 Thomas P.A. Jensen [redacted],

Wisconsin Registered Land Surveyor, No. S-[redacted] 1084

SRA-39

175H

5-365JX