
ROBERS & BOYD, INC.
CONSULTING ENGINEERS & LAND SURVEYORS
PHONE (414) 763-2652 — 116 E. CHESTNUT ST. — BURLINGTON, WIS. 53105

PLAT OF SURVEY
AND
BUILDING LOCATION

Outlot 65 of Assessors Plat # 1 (amended) to the Village of Fontana on Geneva Lake and Lot 5 of Robert Gardners Subdivision, Village of Fontana on Geneva Lake, said parcel located in the Village of Fontana, Walworth County, Wisconsin.

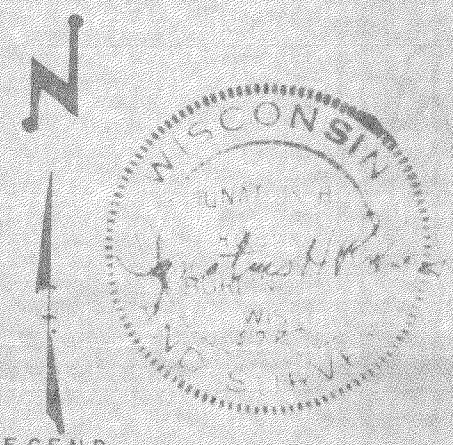


—LEGEND—
- ● FOUND IRON PIPE
- ○ SET IRON PIPE
- ⊕ FOUND CONC. MONMNT

SCALE 1"=60'

AUGUST 5, 1974

NOTE
THERE ARE NO VISIBLE ENCROACHMENTS

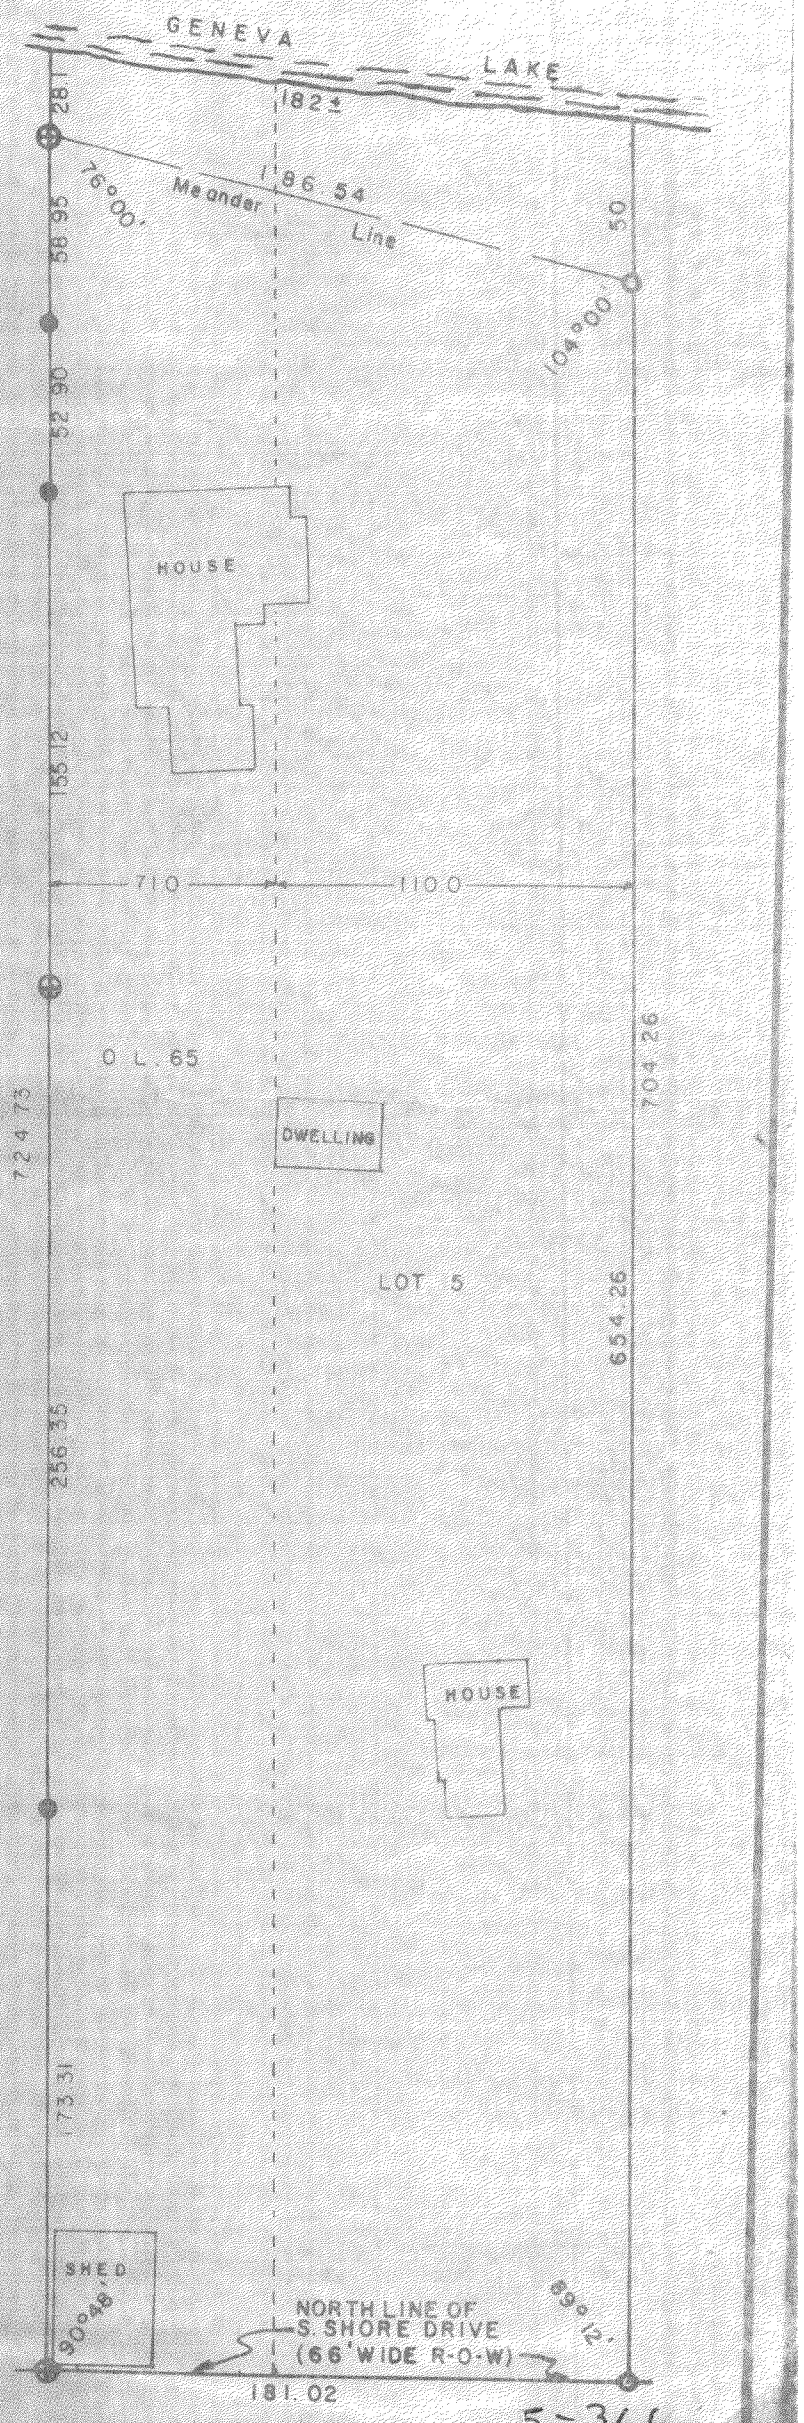

"I have surveyed the above-described property, and the above map is a true representation thereof and shows the size and location of the property, its exterior boundaries, the location and dimensions of all visible structures thereon, fences, apparent easements and roadway, and visible encroachments, if any.

This survey is made for the exclusive use of the present owners of the property, and those who purchase, mortgage, or guarantee the title thereto, within one year from date hereof and to them I warrant the accuracy of said survey and map."

Dated at Burlington, this 5th day of August, 1974

Gordon H Roberts
Surveyor S737

New Cert. Survey #655

5-366