



PLAT OF SURVEY AND TOPOGRAPHIC MAPPING
LOTS 1 & 2 OF CERTIFIED SURVEY MAP NO. 661

REC. IN VOL. 3 ON PG. 147 AS DOC. NO. 16208
LOCATED IN THE SW 1/4 OF SECTION 11,
TOWN 1 NORTH, RANGE 16 EAST,
VILLAGE OF FONTANA - ON - GENEVA LAKE, WALWORTH COUNTY, WISCONSIN

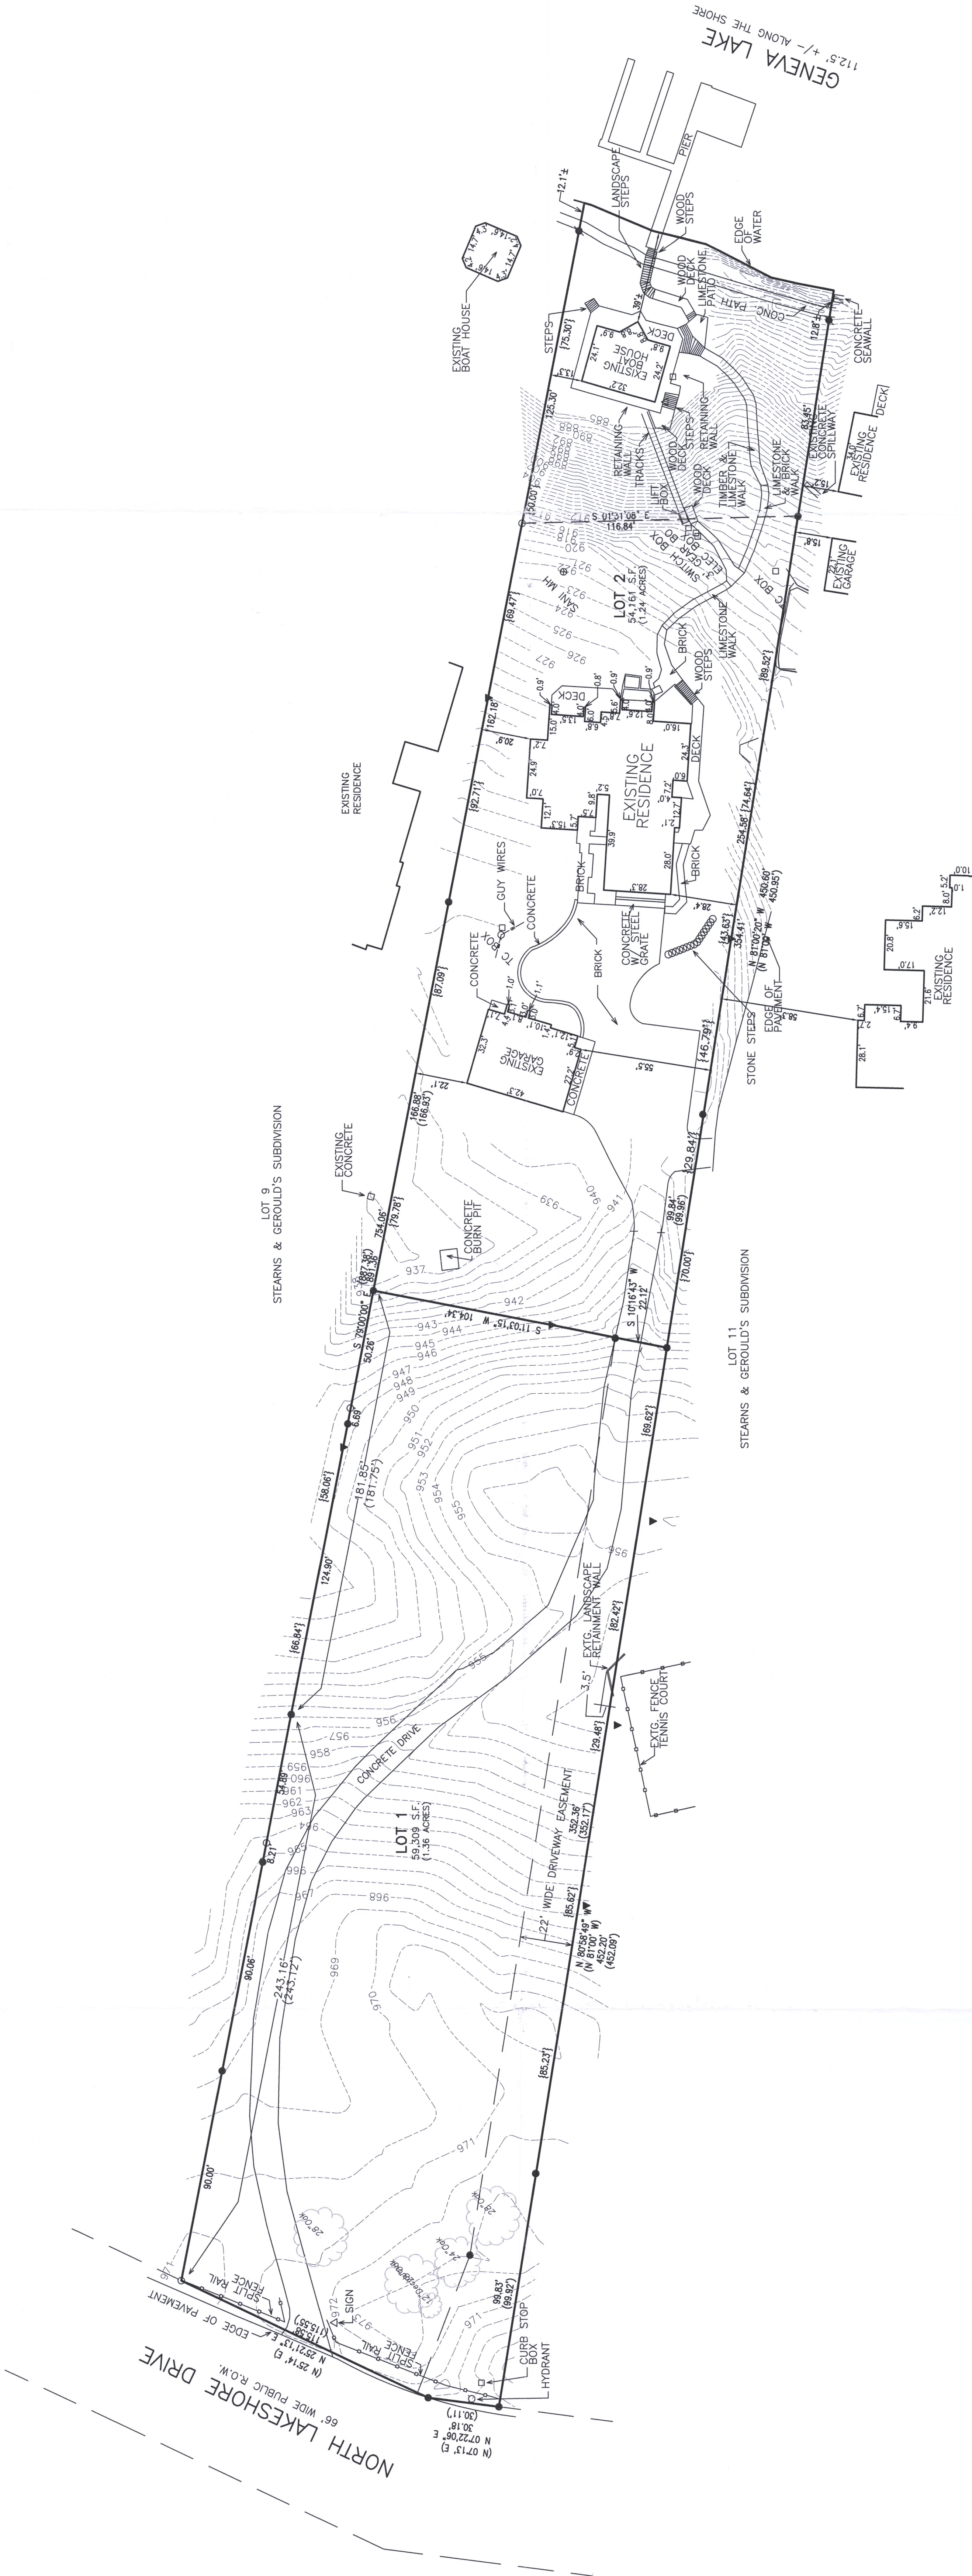

- LEGEND
- = FOUND IRON PIPE STAKE
 - = FOUND IRON REBAR STAKE
 - = SET IRON REBAR STAKE
 - ▼ = SET LATH
 - (XXX) = RECORDED AS
 - {XXX.XX} = DISTANCES BETWEEN SET REBARS

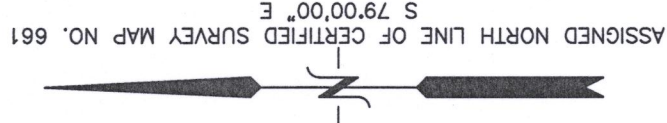


NOTE: COPIES OF THIS MAP TO WHICH THE FOLLOWING CERTIFICATE WILL APPLY SHOW THE SURVEYOR'S ORIGINAL SEAL AND SIGNATURE IN RED INK. COPIES BY ANY OTHER MEANS MAY HAVE ALTERATIONS WHICH DO NOT REPRESENT THE SURVEYOR'S WORK PRODUCT.

I HEREBY CERTIFY THAT THE ABOVE DESCRIBED PROPERTY HAS BEEN SURVEYED UNDER MY DIRECTION AND THAT THE ABOVE MAP IS A TRUE REPRESENTATION HEREOF AND SHOWS THE SIZE AND LOCATION OF THE PROPERTY AND ITS EXTERIOR BOUNDARIES, AND ALSO THOSE WHO PURCHASE, MORTGAGE, OR GUARANTEE THE TITLE THERETO WITHIN ONE YEAR FROM THE DATE HEREOF.

DATED: 12/21/2021
PLAT OF SURVEY PREPARED BY PETER S. GORDON DATED 7/7/2015.

CHRISTOPHER A. HODGES P.L.S. 2760

SA 661-1 SA 661-2

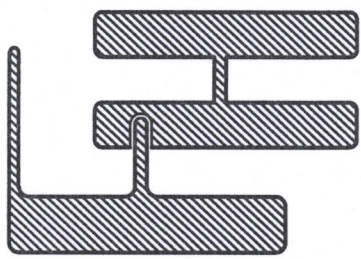

- WORK ORDERED BY -
BILL HUCK
363 N. LAKE SHORE DRIVE
FONTANA, WISCONSIN 53125

FARRIS, HANSEN & ASSOCIATES, INC.
ENGINEERING - ARCHITECTURE - SURVEYING
7 RIDGWAY COURT P.O. BOX 437
ELKHORN, WISCONSIN 53121
OFFICE: (262) 723-2098 FAX: (262) 723-5886

REVISIONS

PROJECT NO.
6425.15
DATE
12/21/2021
SHEET NO.
1 OF 1