



PLAT OF SURVEY AND TOPOGRAPHIC MAPPING
LOTS 1 & 2 OF CERTIFIED SURVEY MAP NO. 661

REC. IN VOL. 3 ON PG. 147 AS DOC. NO. 16208
LOCATED IN THE SW 1/4 OF SECTION 11,
TOWN 1 NORTH, RANGE 16 EAST,
VILLAGE OF FONTANA — ON — GENEVA LAKE, WALWORTH COUNTY, WISCONSIN

ASSIGNED NORTH LINE OF CERTIFIED SURVEY MAP NO. 661
S. 79°07'00" E.

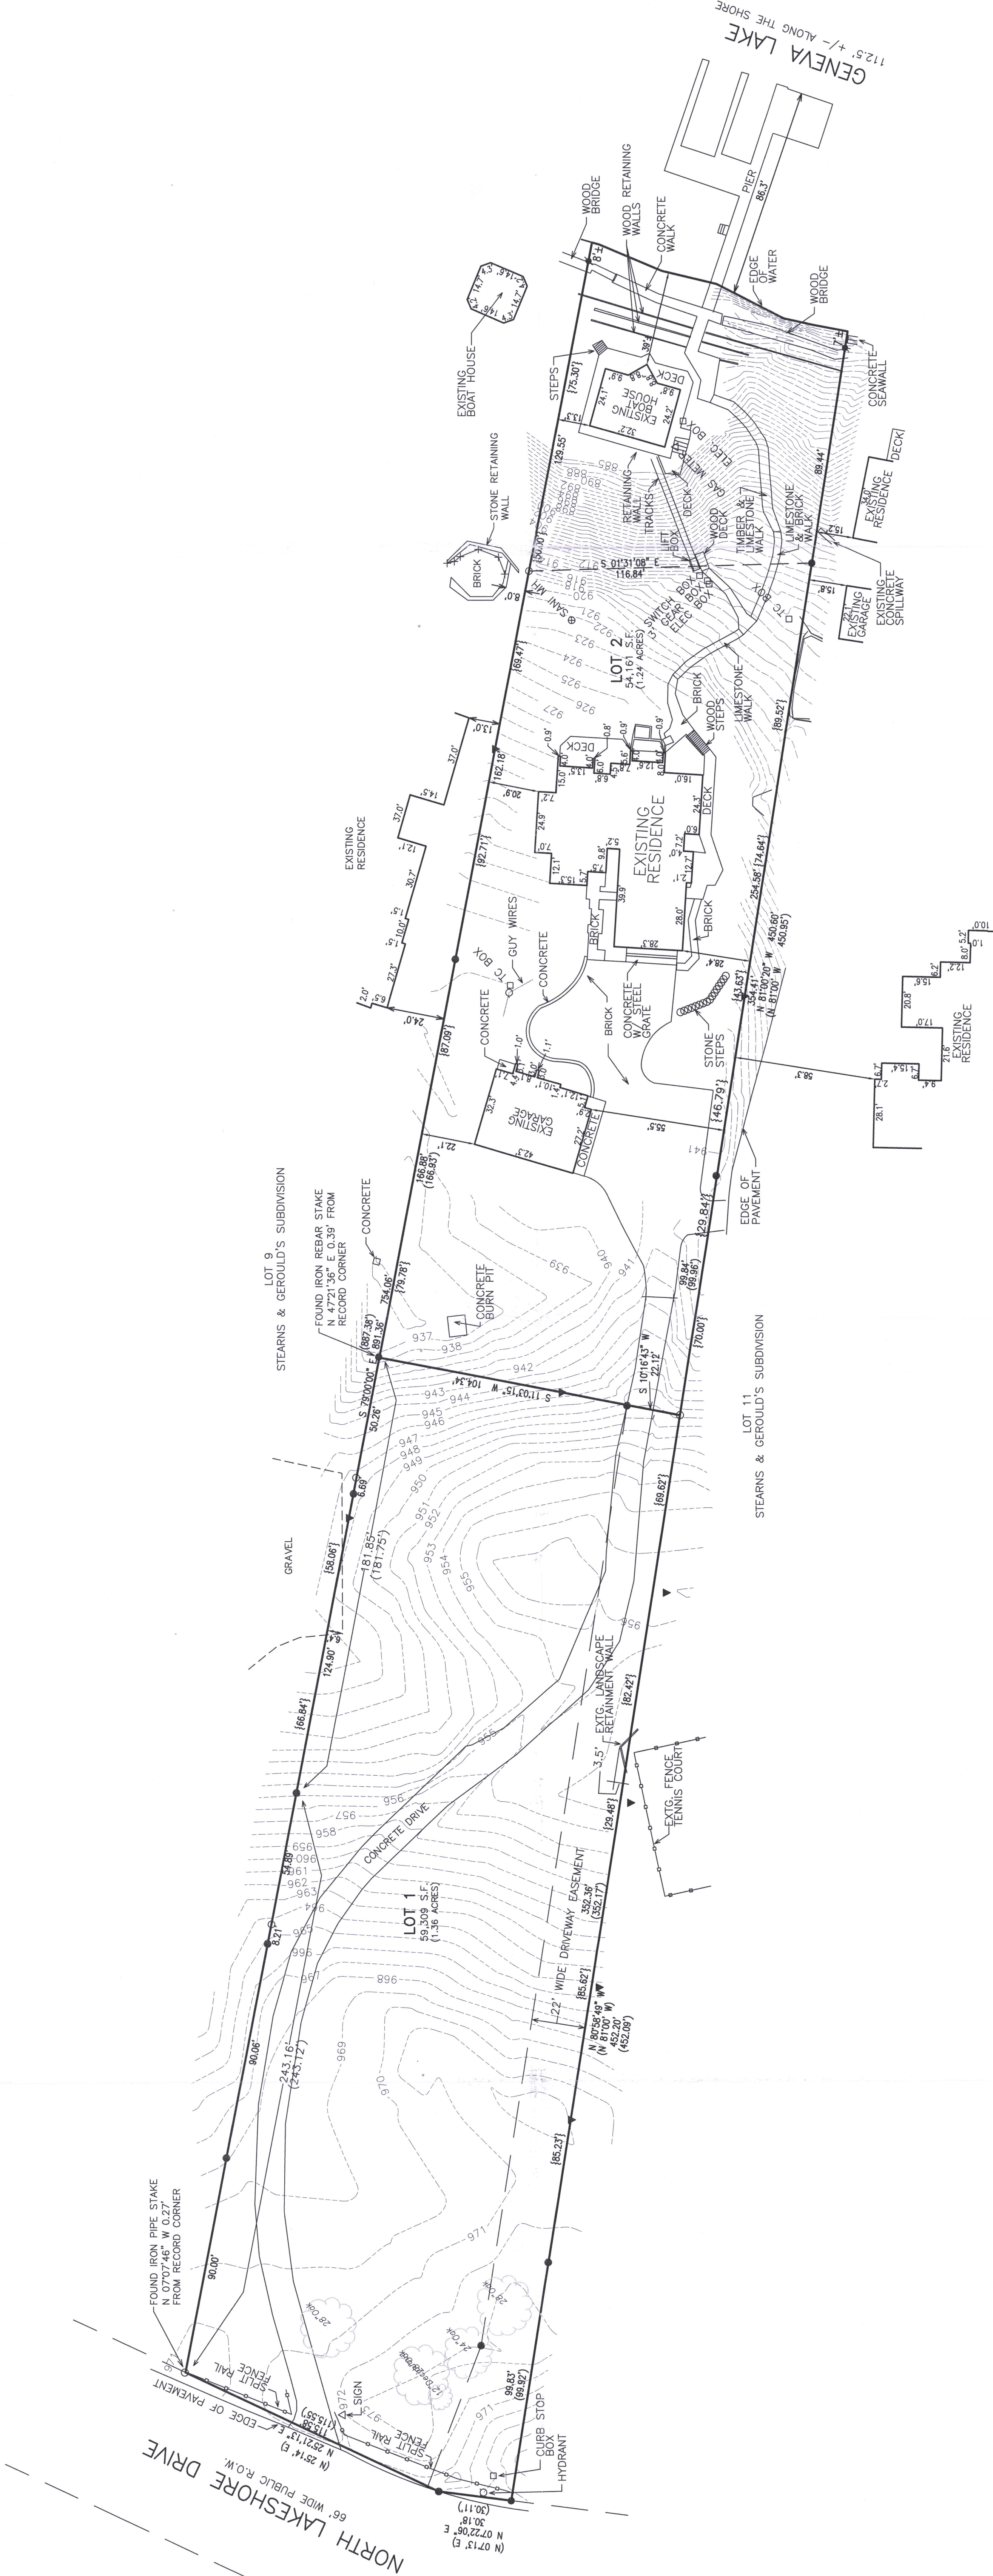

- LEGEND
- = FOUND IRON PIPE STAKE
 - = FOUND IRON REBAR STAKE
 - = SET IRON REBAR STAKE
 - ▼ = SET LATH
- (XXX) = RECORDED AS
{XXX.XX'} = DISTANCES BETWEEN SET REBARS

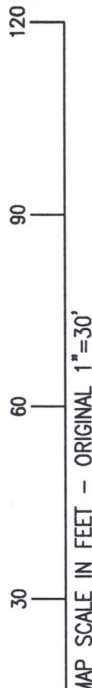

SA 100-1

NOTE: COPIES OF THIS MAP TO WHICH THE FOLLOWING CERTIFICATE WILL APPLY SHOW THE SURVEYOR'S WORK AND THE SURVEYOR'S NAME AND ADDRESS. ANY OTHER MEANS MAY HAVE ALTERATIONS WHICH DO NOT REPRESENT THE SURVEYOR'S WORK PRODUCT.

I HEREBY CERTIFY THAT THE ABOVE DESCRIBED PROPERTY HAS BEEN SURVEYED UNDER MY DIRECTION AND THAT THE ABOVE MAP IS A TRUE REPRESENTATION THEREOF AND SHOWS THE SIZE AND LOCATION OF THE PROPERTY AND ITS EXTERIOR BOUNDARIES. THIS SURVEY IS MADE FOR THE USE OF THE PRESENT OWNERS OF THE PROPERTY AND IS NOT TO BE USED FOR ANY OTHER PURPOSE WITHOUT THE WRITTEN CONSENT OF THE SURVEYOR. THIS CERTIFICATE IS VALID FOR ONE YEAR FROM THE DATE HEREOF.

DATED: 5/12/2022
REVISED 12/21/2021 TO UPDATE A
P.L.S. GORDON DATED 7/7/2015
REVISED 5/12/2022 TO UPDATE PLAT
OF SURVEY.
CHRISTOPHER A. HODGES P.L.S. 2760



— WORK ORDERED BY —
BILL HUCK
363 N. LAKESHORE DRIVE
FONTANA, WISCONSIN 53125

FARRIS, HANSEN & ASSOCIATES, INC.
ENGINEERING — ARCHITECTURE — SURVEYING
7 RIDGWAY COURT P.O. BOX 457
ELKHORN, WISCONSIN 53121
OFFICE: (262) 723-2098 FAX: (262) 723-5886

REVISIONS

PROJECT NO.
6425.15

DATE
12/21/2021

SHEET NO.
1 OF 1