
GEORGE T. DUNHAM
SURVEYING & SUBDIVIDING
DELAVAN, WISCONSIN



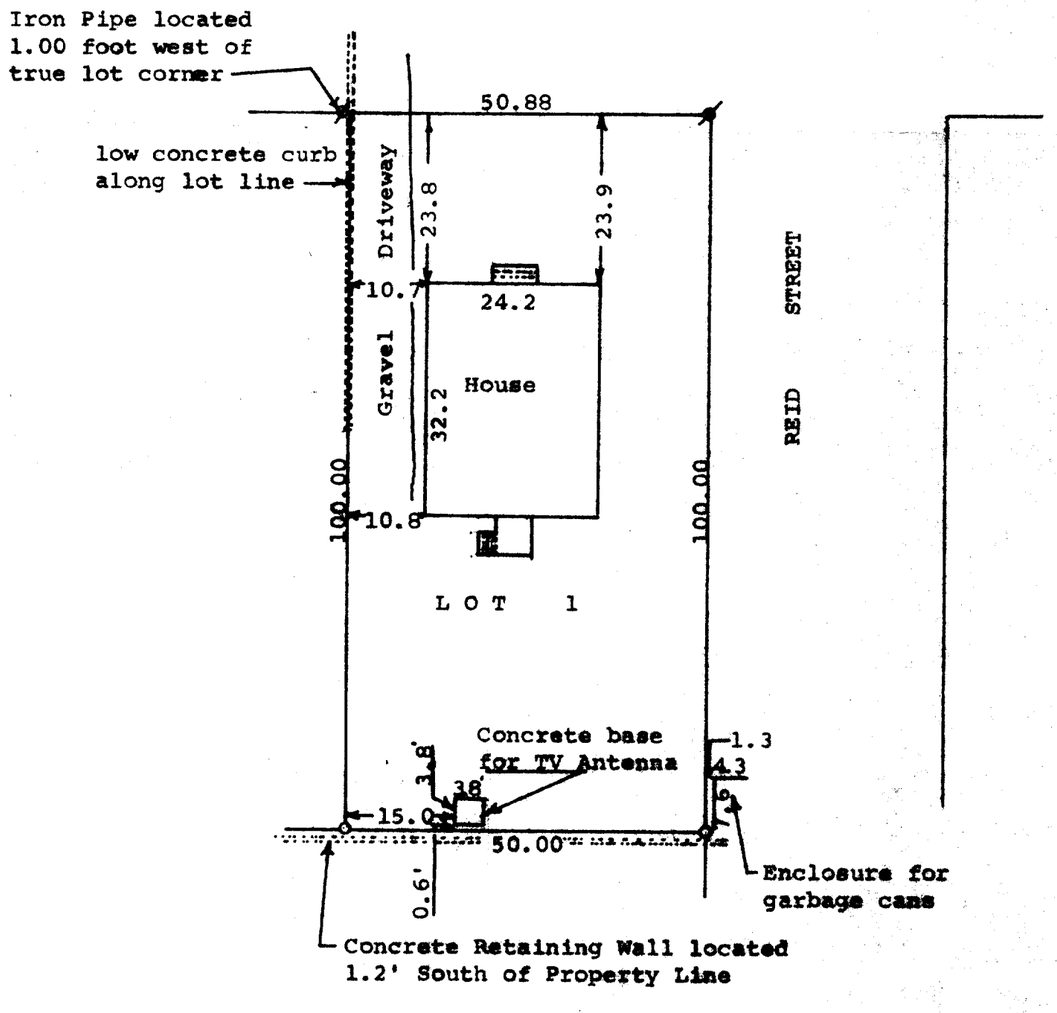

Scale - 1" = 20'
ø = Iron Pipe Found
o = Iron Pipe Set
ø = Concrete Monument Found

STATE OF WISCONSIN)
COUNTY OF WALWORTH) ss

I, George T. Dunham, Surveyor, certify that I have surveyed the property described as follows,

Lot 1 in Block 4 of D. A. Reids Addition to Reids Park, located in the Village of Fontana-on-Geneva-Lake, Walworth County, Wisconsin.

and that the above plat is a true representation thereof and shows the size and location of the property, its exterior boundaries, the location and dimensions of all structures, fences, apparent easements and roadways and visible encroachments, if any.

This survey is made for the exclusive use of the present owners of the property, and also those who purchase, mortgage, or guarantee the title thereto within one (1) year from date hereof; and as to them I warrant the accuracy of said survey and map.

January 30, 1975

George T. Dunham

George T. Dunham, Surveyor

WISCONSIN
GEORGE T. DUNHAM
DELAVAN, WIS.
LAND SURVEYOR

5-390